#19021

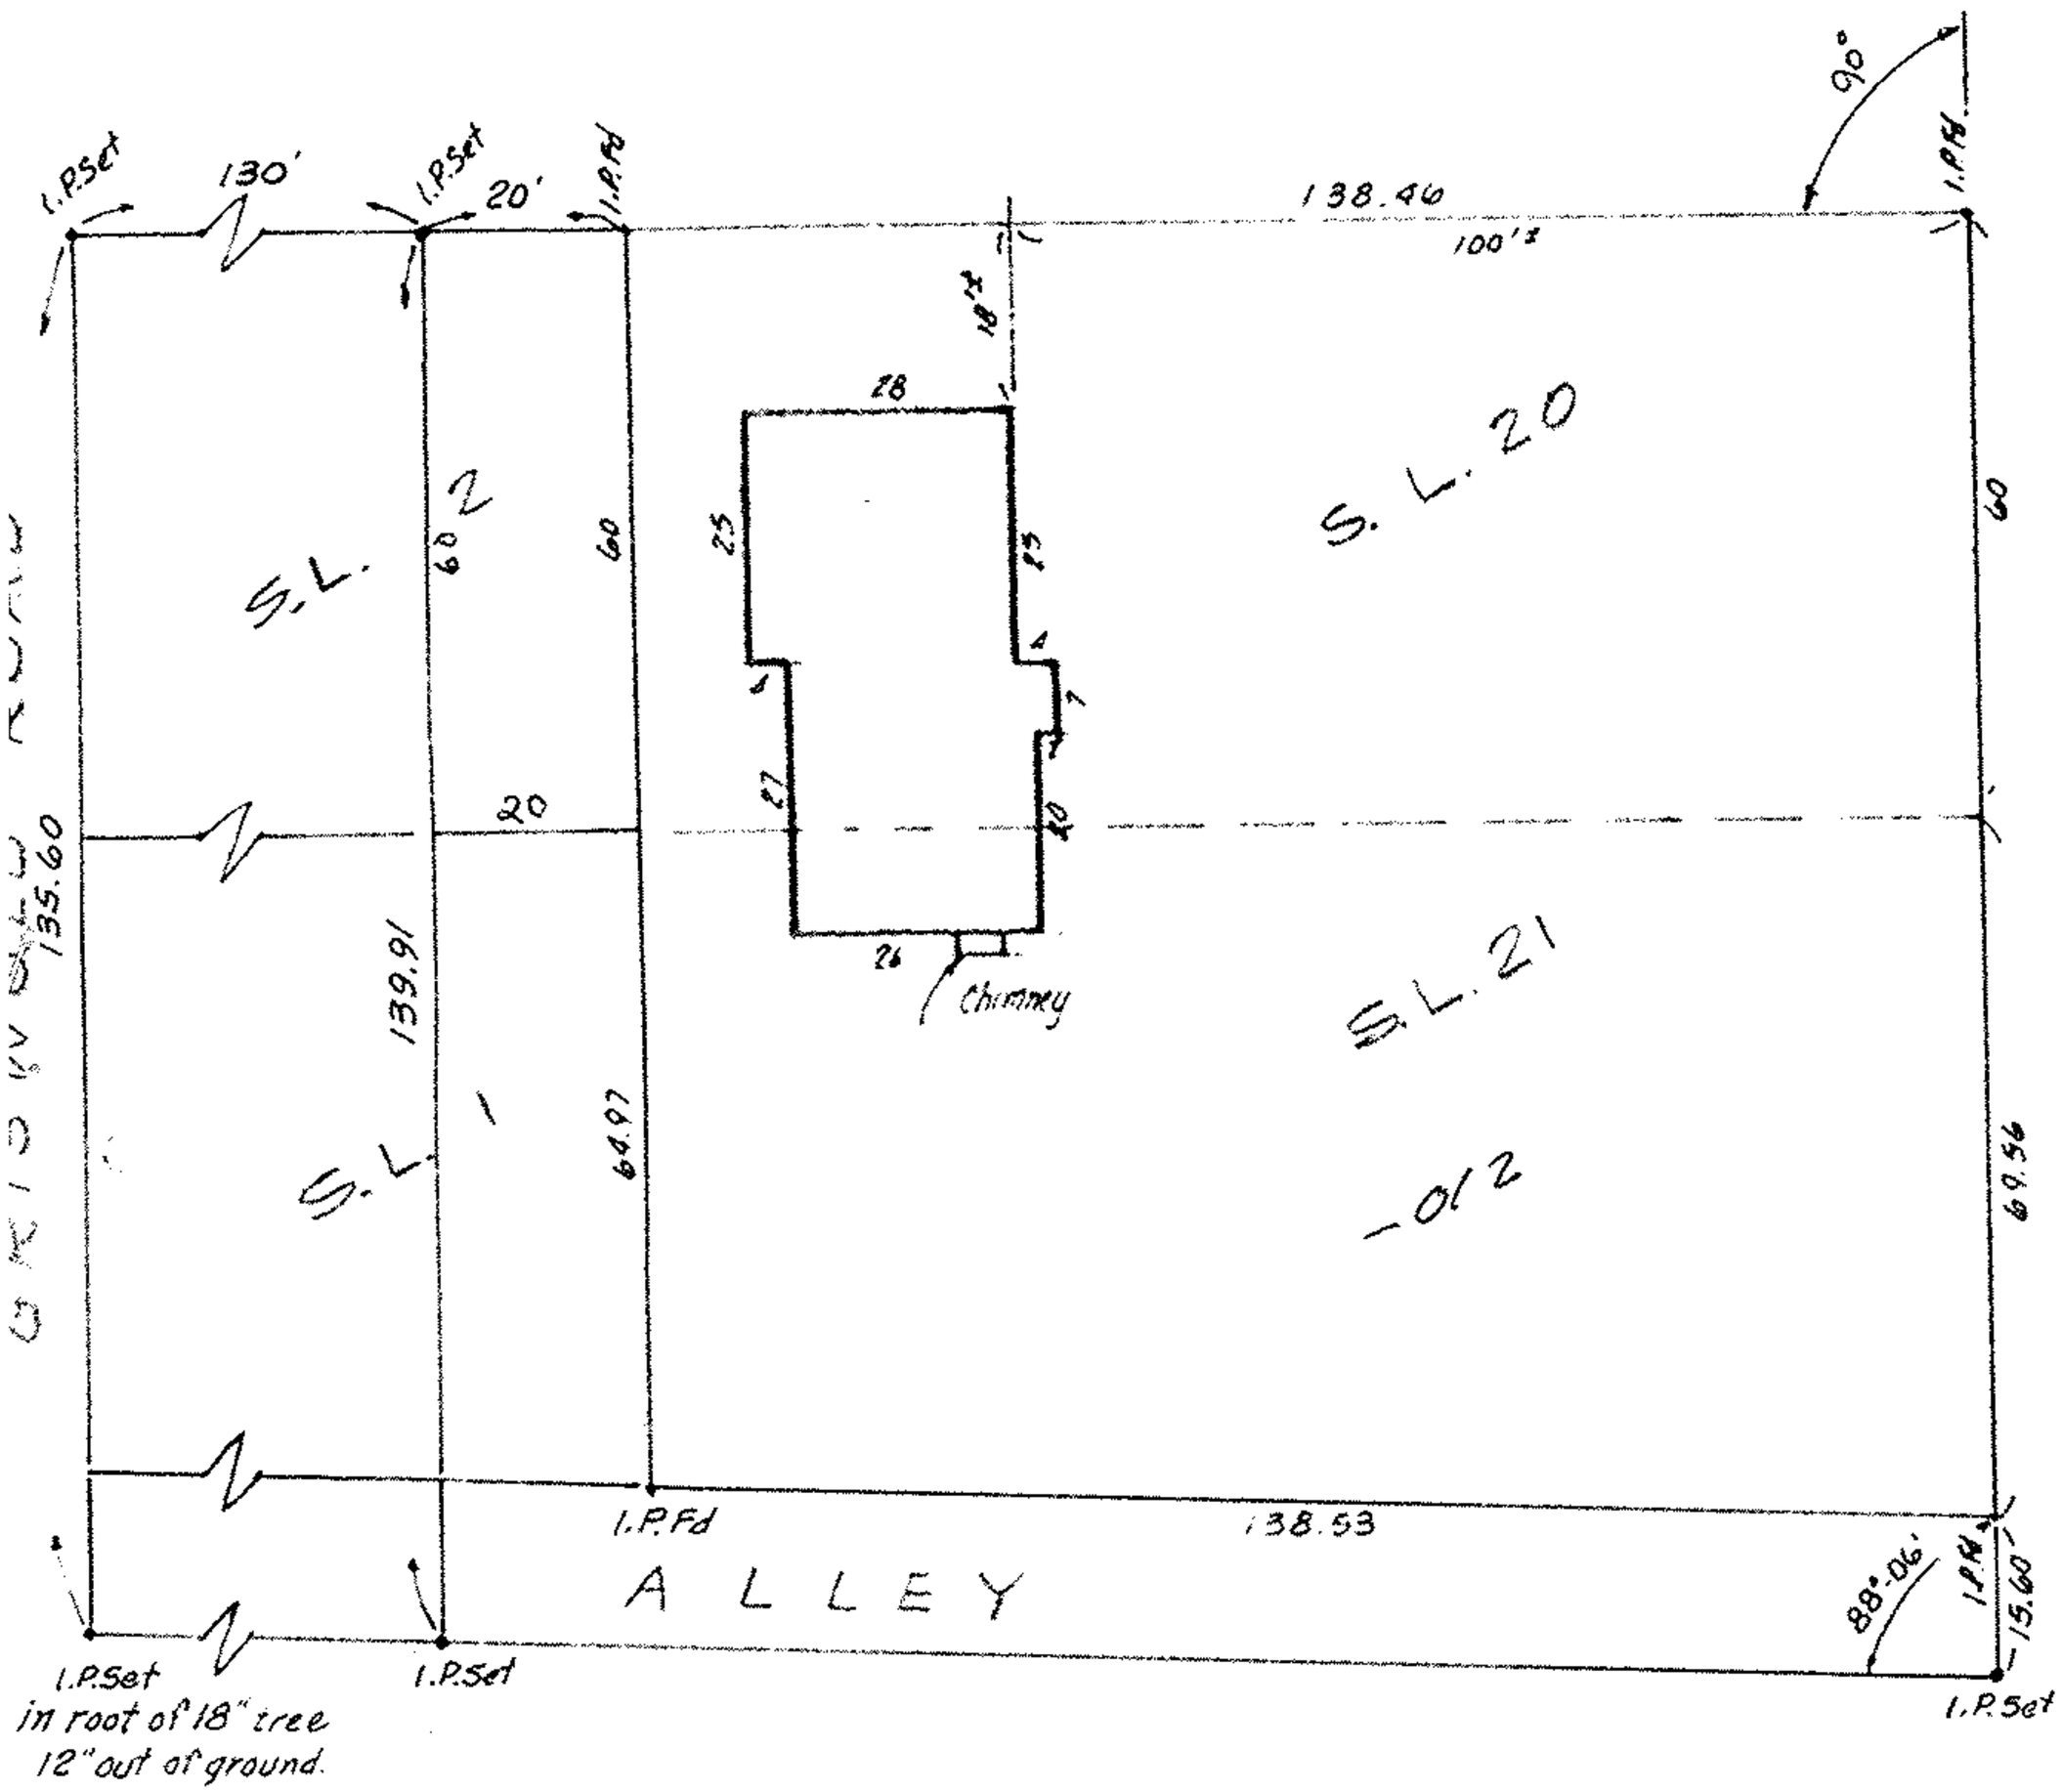

1" = 30'

LAWRENCE CT. 50'

#19021

APPROVED
LORAIN CO.
MAP DEPT.

DATE 7-2-90
PAGE 6-42
BY CAROLYN FRANCIS
VOID AFTER #19021

06-24-038-102-012

STATE OF OHIO
LAWRENCE
V.
McGLINCHY
4970
REGISTERED
SURVEYOR

SUBLOTS #1, 2, 20 & 21 of ELYRIA HEIGHTS ALLOTMENT
PLUS PLATTED ALLEY
PLAT VOL. 6 PAGE 48
PART of ORIG. ELYRIA TWP. LOT 38 WEST of BLACK RIVER
LORAIN COUNTY ,OHIO

THIS IS A PLAT OF SURVEY:
FOR WALT GODLES
McGLINCHY & ASSOCIATES
APR. 2 1982 #827166