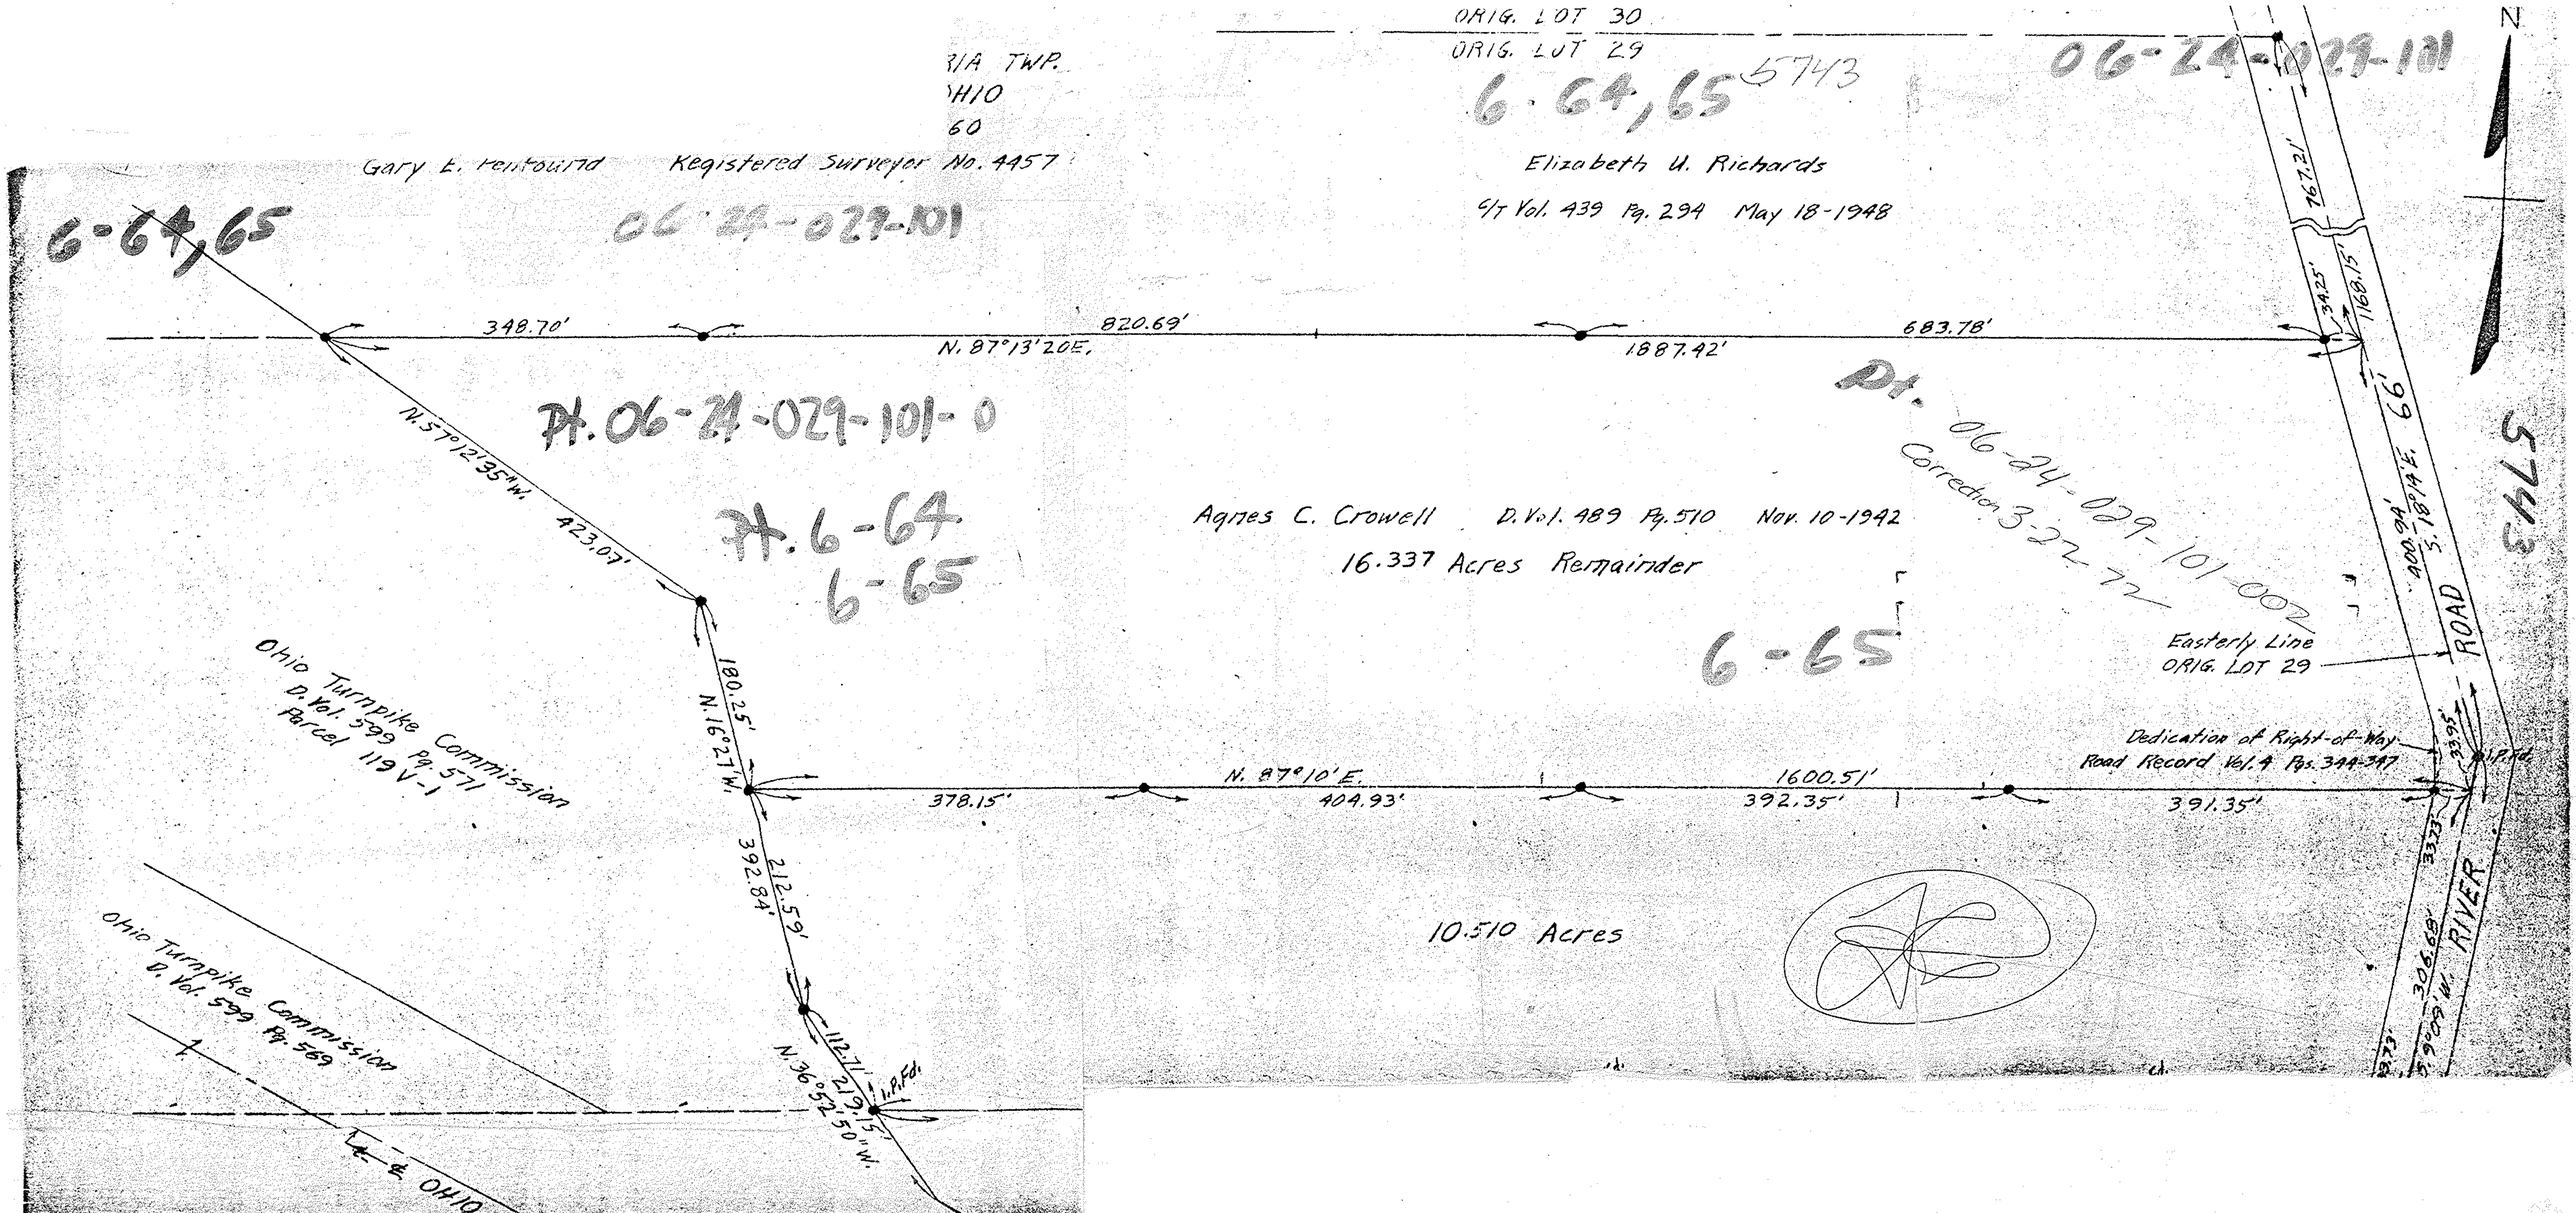

ORIG. LOT 30
ORIG. LOT 29
6-64,65
5743
06-24-029-101
N
RIA TWP.
OHIO
60
Gary E. Penfound Registered Surveyor No. 4457
Elizabeth U. Richards
C/T Vol. 439 Pg. 294 May 18-1948
6-64,65
06-24-029-101
348.70'
820.69'
N. 87°13'20E.
1887.42'
683.78'
767.21'
34.25'
1168.15'
Pt. 06-24-029-101-0
Pt. 06-24-029-101-002
Correction 3-22-72
Pt. 6-64
6-65
N. 57°12'35"W.
423.07'
Agnes C. Crowell D. Vol. 489 Pg. 510 Nov. 10-1942
16.337 Acres Remainder
6-65
Easterly Line
ORIG. LOT 29
ROAD
400.94'
S. 18°14'E.
66'
5743
Ohio Turnpike Commission
D. Vol. 599 Pg. 571
Parcel 119V-1
180.25'
N. 16°27'W.
N. 87°10'E.
1600.51'
Dedication of Right-of-Way
Road Record Vol. 4 Pgs. 344-347
I.P.Fd.
378.15'
404.93'
392.35'
391.35'
33.95'
33.73'
392.84'
212.59'
10.510 Acres
RIVER
306.68'
S. 9°09'W.
Ohio Turnpike Commission
D. Vol. 599 Pg. 569
112.71'
219.15'
N. 36°52'50"W.
I.P.Fd.
℄ OHIO