6-24-02 6-65 06-24-021

06-24-029-101-

PLOT PLAN

JOB Nº 71-324

SUBLOT

SUBDIVISION

OTHER PART OF ELYRIA TWP. O.L. 29 - W. OF RIV. - CITY OF ELYRIA

KLEINOEDER · SCHMIDT and ASSOCIATES

ENGINEERS — SURVEYORS — CONSULTANTS in LAND PLANNING
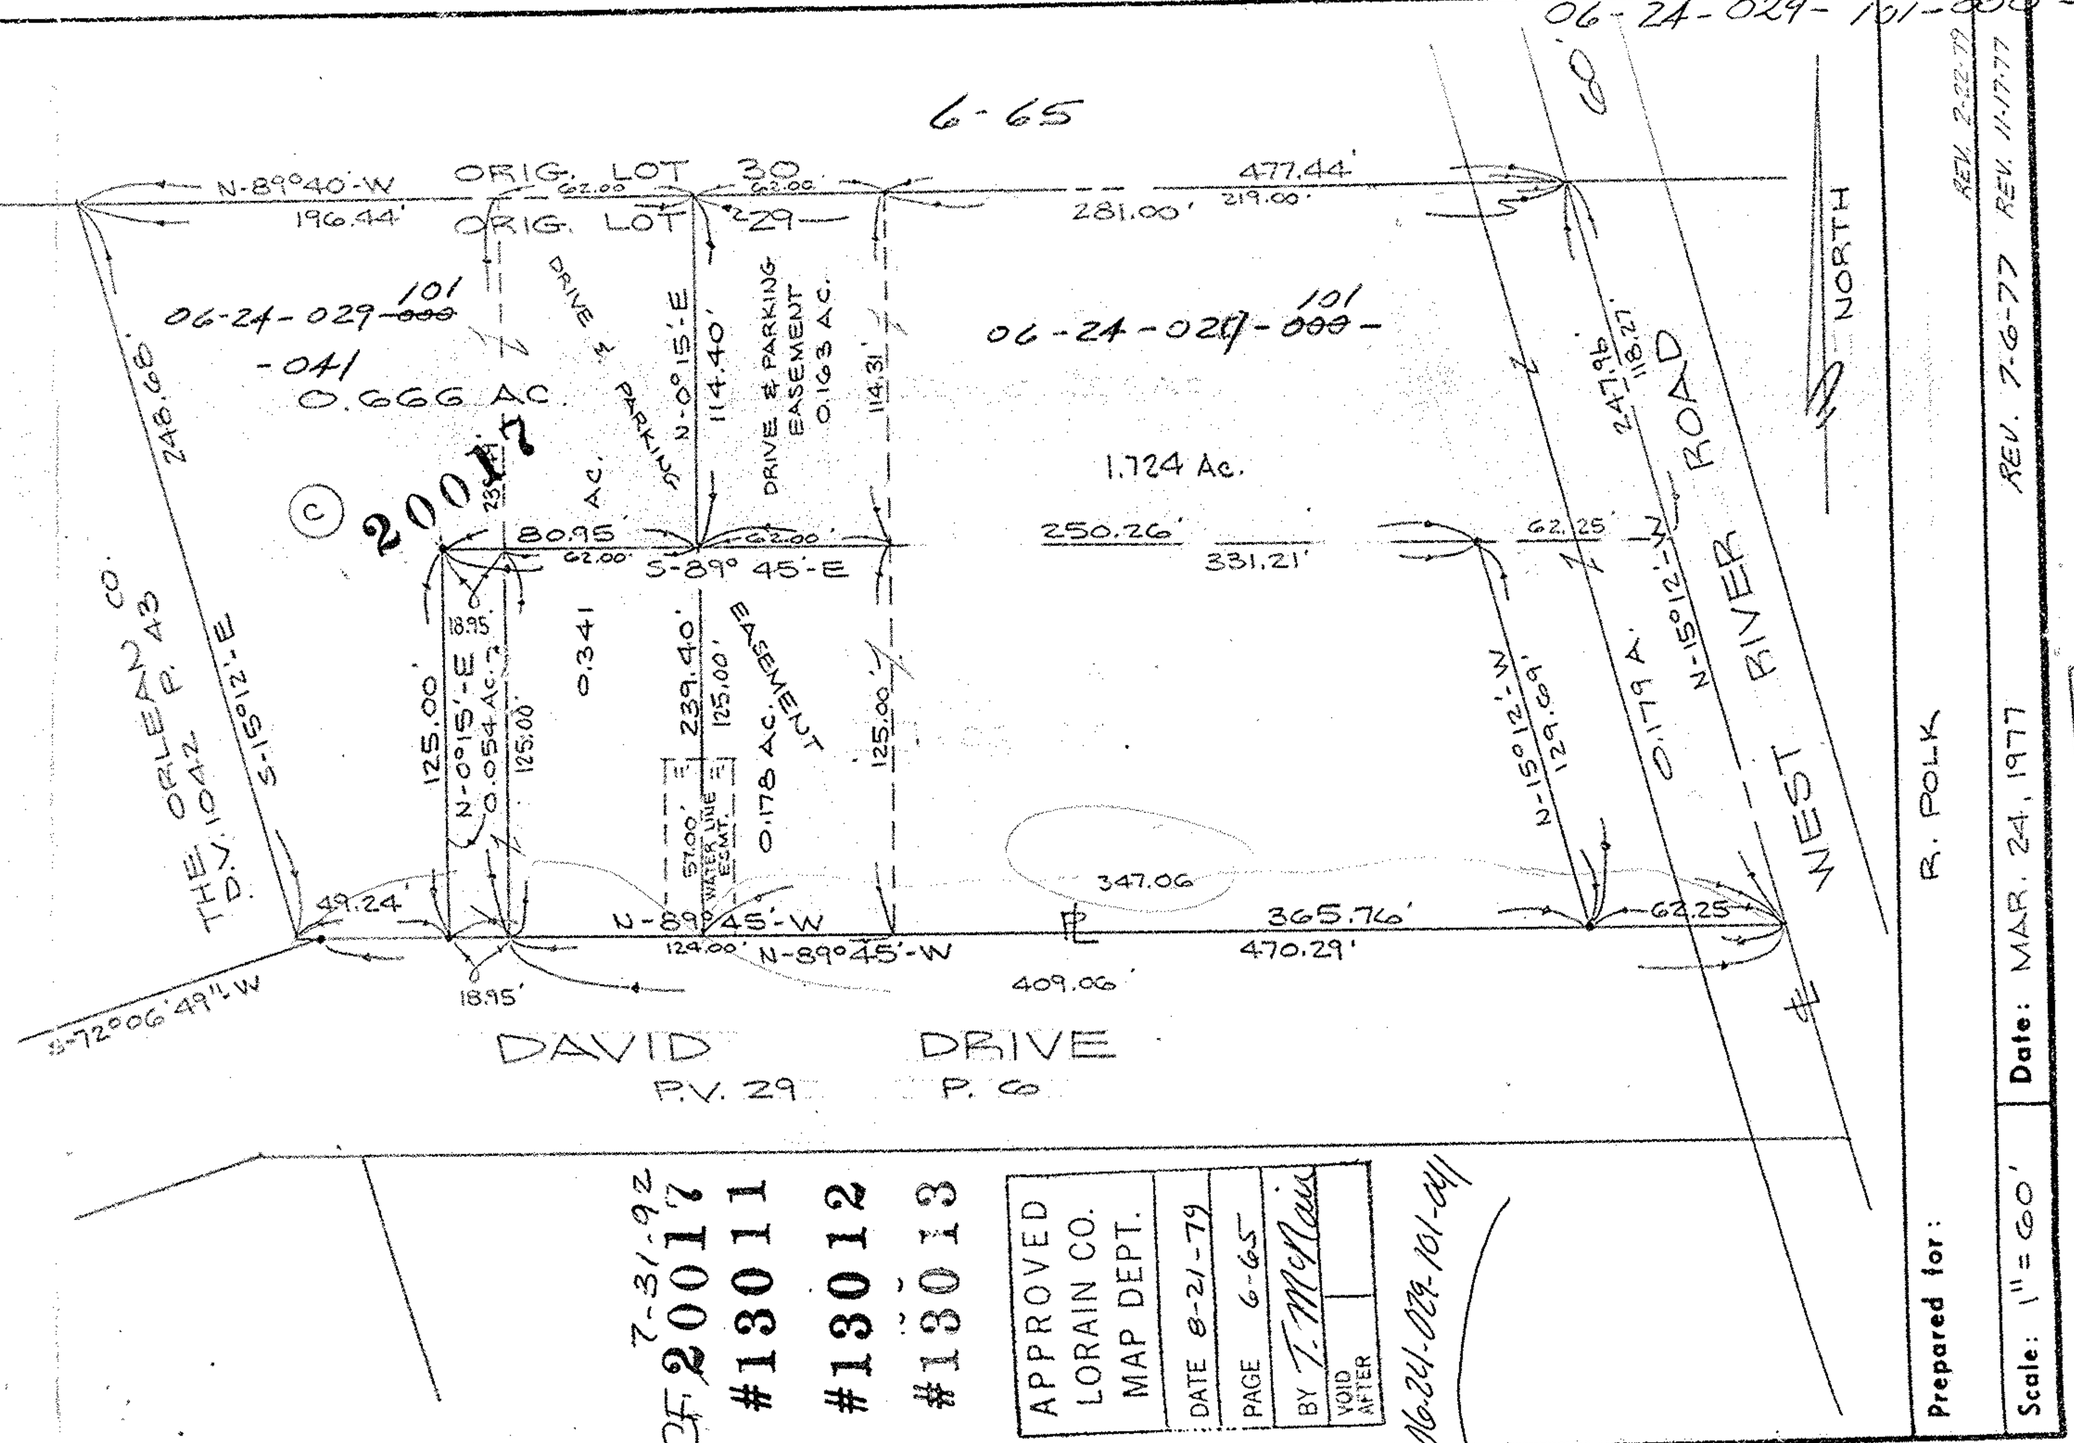
ELYRIA · NORWALK · MEDINA OHIO