


6.58

15494

06-24-043-102

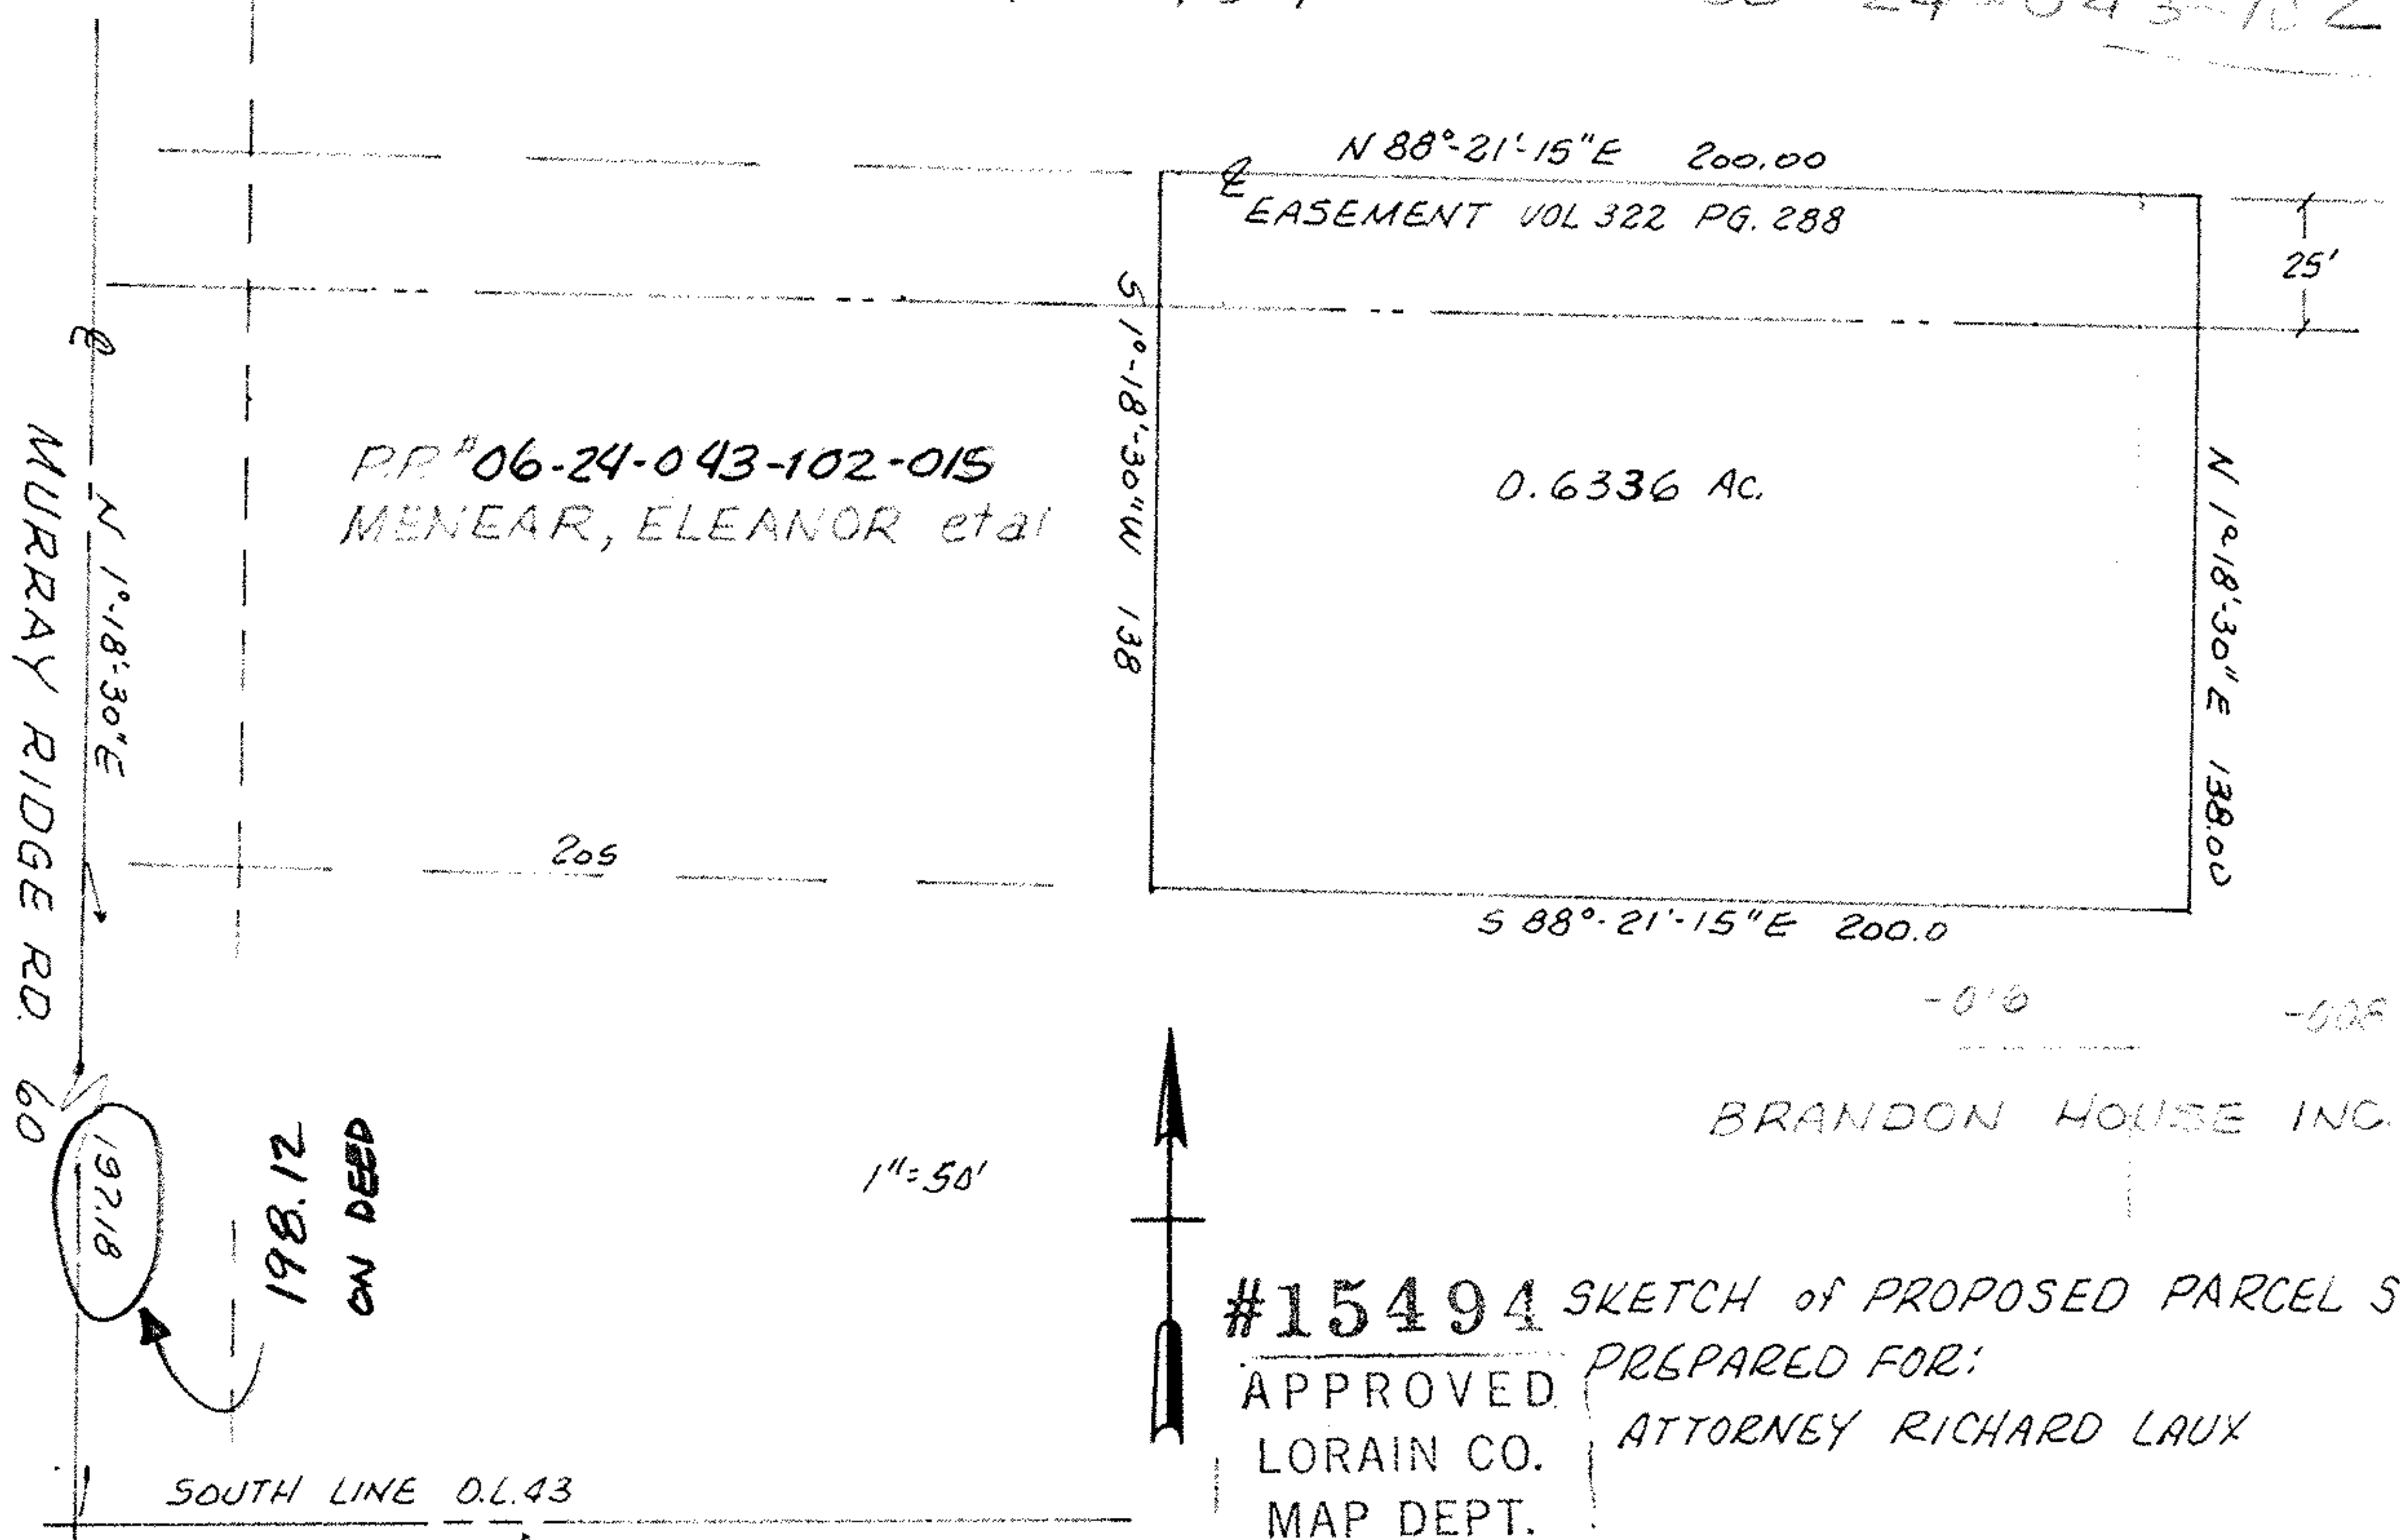

#15494 SKETCH of PROPOSED PARCEL SPLIT
 PREPARED FOR:
 APPROVED LORAIN CO. MAP DEPT. ATTORNEY RICHARD LAUX
 DATE 4.11.84
 PAGE 6.58
 BY T. McMain
 VOID "PTC"

THIS IS NOT A PLAT OF SURVEY:

PART of ORIG. ELYRIA
NOW in CITY of
LORAIN COUNTY

TWP. LOT 43 WEST of BLACK RIVER
, OHIO

McGLINCHY & ASSOCIATES INC.

MAR 22, 1984

#848256