06-24-042

#16742

6-58

06-24-043 102-003, 004, 007, 015, 013
-042-000-009

PARCEL MAP

PREPARED FROM RECORD ONLY - NOT A SURVEY

PART OF ELYRIA TWP. ORIG. LOTS 42 & 43 - W. OF R.

TOWNSHIP OF ELYRIA COUNTY OF LORAIN STATE OF OHIO

SCALE: 1" = 100' JUNE 15, 1961

PREPARED BY

KLEINOEDER - SCHMIDT & ASSOC.

CONSULTING ENGINEERS & SURVEYORS
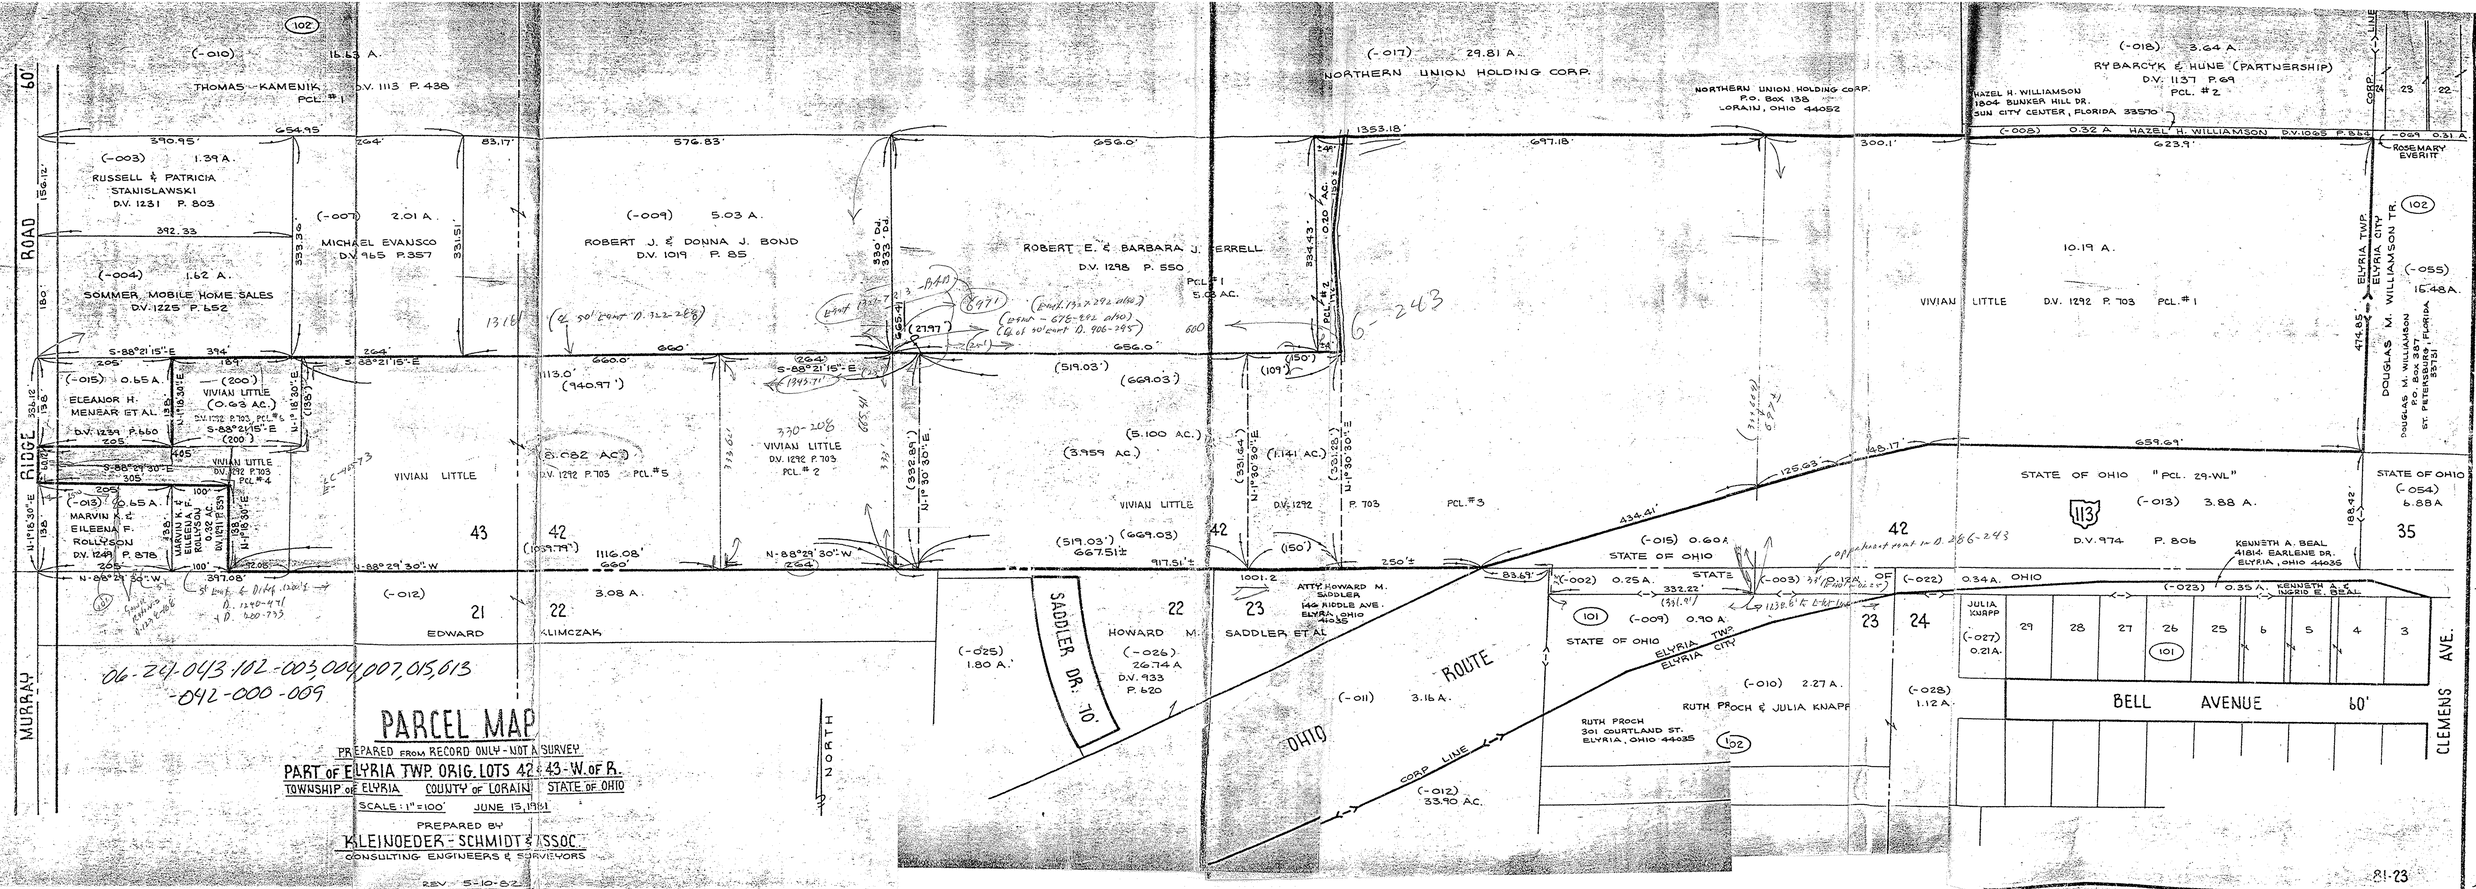
REV 5-10-82