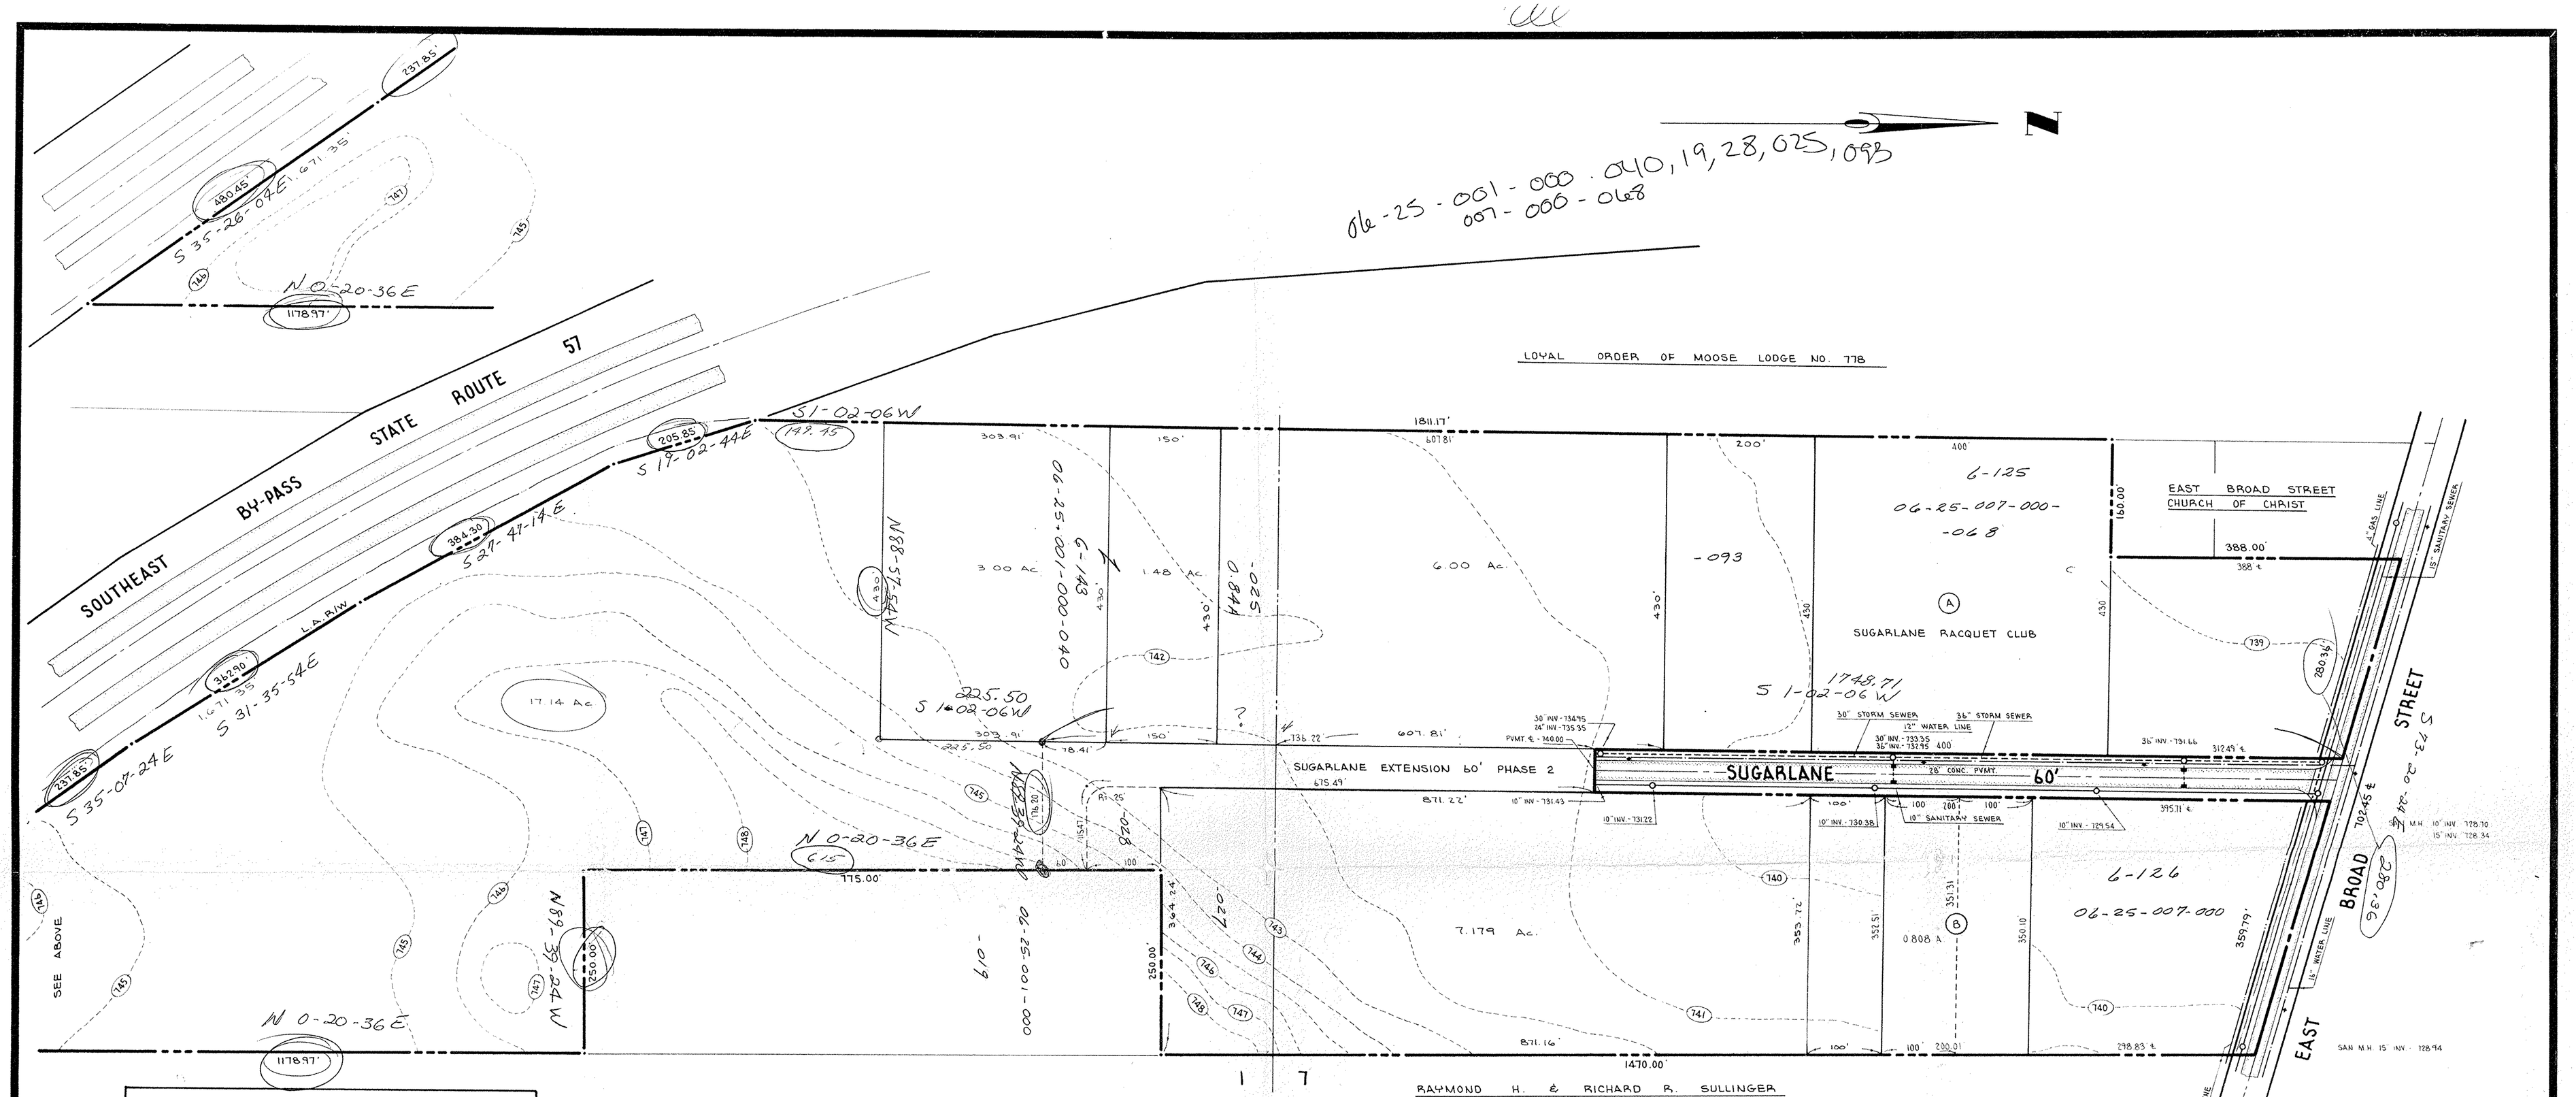

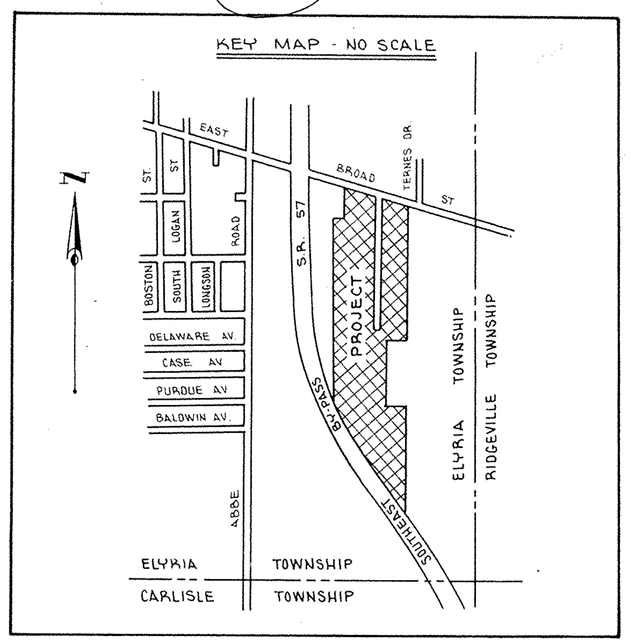

GENERAL NOTES:

1) TOTAL ACREAGE ORIGINAL PARCEL
   25.045 - O.L.1
   25.888 - O.L.7
   50.933 - TOTAL BY SURVEY

2) ENTIRE PARCEL ZONED "M-1" LIGHT INDUSTRIAL DISTRICT.

3.) A TEMPORARY TURNAROUND WILL BE CONSTRUCTED UNTIL SUCH TIME AS A FINAL DECISION IS MADE AS TO THE CONTINUATION OF SUGAR LANE.

ACREAGE TABULATION

PARCEL	TOTAL	O.L. 1	O.L. 7
SUGARLANE DEDICATED PV. 27 P. 67	1.383		
PARCEL "A"	3.949		
PARCEL "B"	1.613		
PROPOSED SUGARLANE EXTENSION	1.176	0.594	0.582

712.49
807.81
1520.50

871.16

No.	Date	Description	By
3.	5-7-74	ADD PCLS. & ACREAGES	D.C.
2.	3-21-74	ADD ELY. EXTENSION	
1.	3-18-74	REMOVE PCLS. [illegible]	

REVISIONS

PROJECT

PRELIMINARY PLAN - SUGARLANE

PART OF ORIGINAL ELYRIA TOWNSHIP LOTS Nos 1 & 7
EAST OF BLACK RIVER

CITY OF ELYRIA — COUNTY OF LORAIN — STATE OF OHIO

PREPARED FOR:

DALE YOST — ELYRIA OHIO

LESTER DRAGE — ELYRIA OHIO

Drawn by:
Checked by:
App. by:
Scale: 1" = 100'
Date: FEB. 28, 1974

SCHMIDT and Associates
Elyria, Ohio
Norwalk, Ohio
SURVEYORS and CONSULTANTS in LAND PLANNING

REFERENCES

SHEET NO. 1 of 1

JOB NO. 69287