06-25-006-108

#14514

LAUNDON • SIMON • CAHL and ASSOC.
ENGINEERS — SURVEYORS
504 MIDDLE AVE. — ELYRIA, OHIO 4035

FOR: ROBERT TARRY REAL ESTATE

TOWNSHIP ELYRIA	VILLAGE	DATE JAN. 25, 1982
ORIG. LOT or SEC. 6 & 14 E. OF R.	COUNTY LORAIN	SCALE 1" = 50
CITY ELYRIA	STATE OHIO	JOB NO. 82-1101 F.B. 103/5

SUNSET PARK ALLOT.
P.V. 10 P. 9

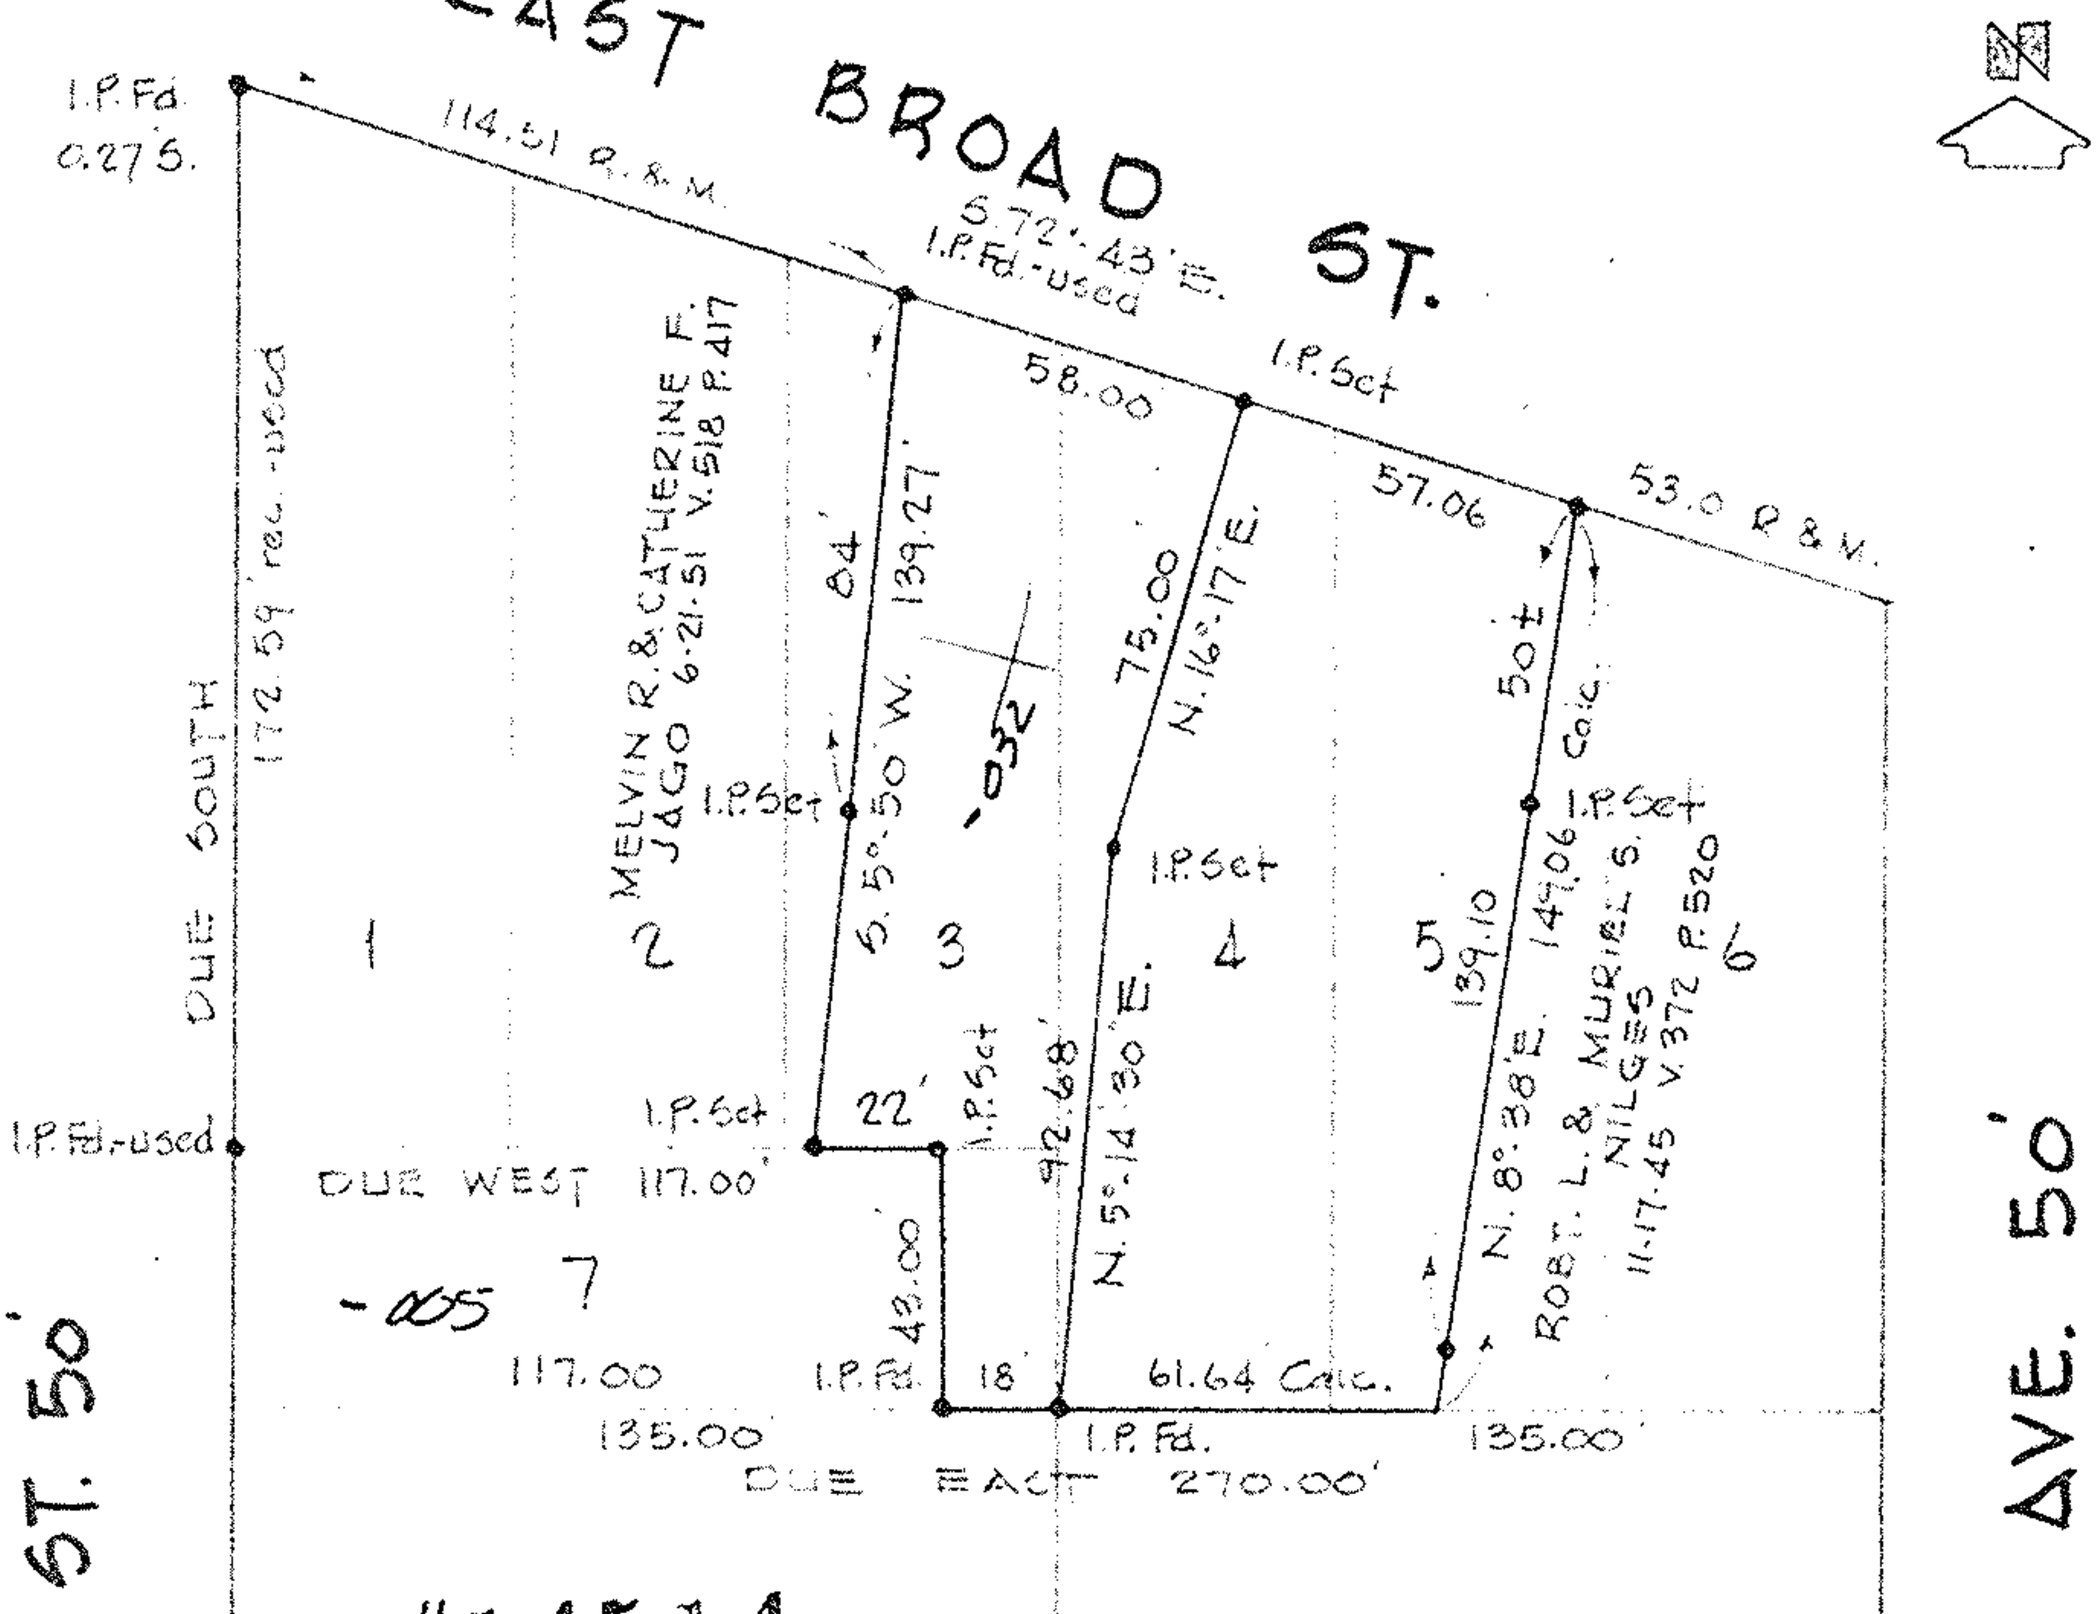

#14514
APPROVED
LORAIN CO.
MAP DEPT.
DATE 2-5-82
PAGE 6.123
BY T. McNair
VOID AFTER

06-25-006-108-005,032

6.123

JAN 25 1982