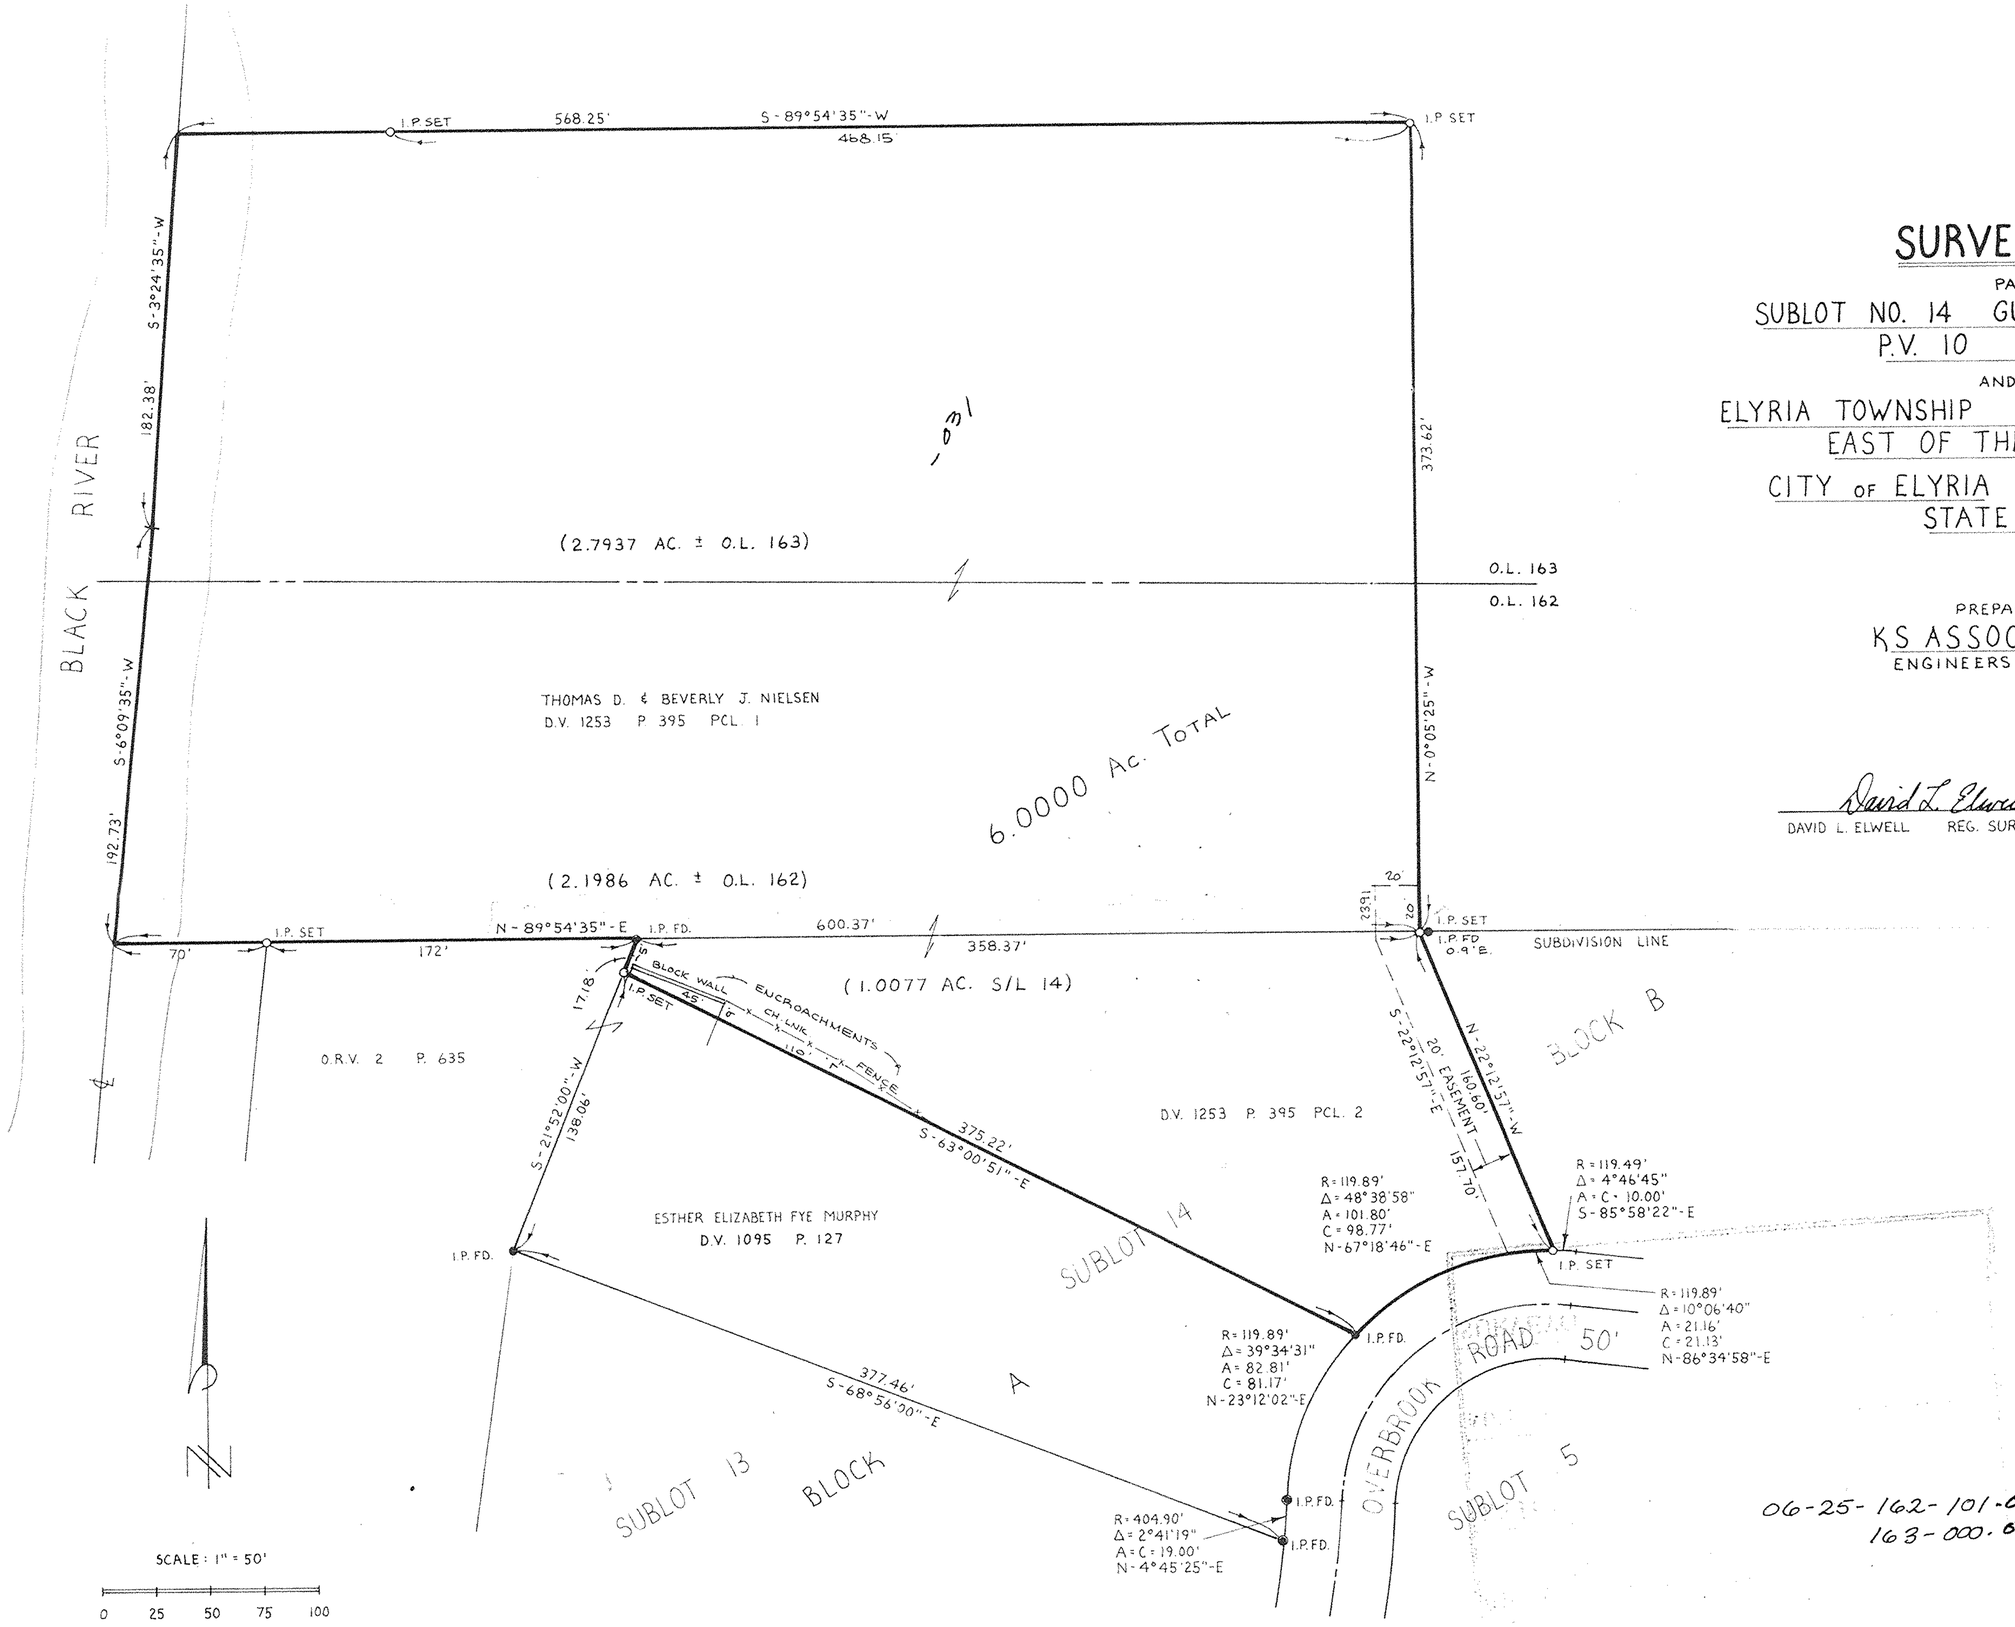


# SURVEY MAP

PART OF

SUBLOT NO. 14 GULF FARMS ALLOTMENT

P.V. 10 PP. 24 & 25

AND PART OF

ELYRIA TOWNSHIP ORIGINAL LOTS 162 & 163

EAST OF THE BLACK RIVER

CITY OF ELYRIA COUNTY OF LORAIN

STATE OF OHIO

PREPARED BY:

KS ASSOCIATES INC.

ENGINEERS & SURVEYORS

David L. Elwell

DAVID L. ELWELL REG. SURVEYOR NO. 6333

STATE OF OHIO
DAVID L. ELWELL
6333
REGISTERED SURVEYOR

06-25-162-101-024054
163-000.031

#18851

APPROVED
LORAIN CO.
MAP DEPT.

DATE 2-22-90

PAGE 6-66 & 6-67

BY CAROLYN FRANCIS

VOID AFTER # 18851

REV. 1-30-90 ESMT. REVISED
REV. 1-29-90 : ESMT. REVISED
REV. 1-23-90 : PINS SET & ENCROACHMENT.

89-558