(-032)

BEVERLY J. NIELSEN

15.68 ± AC. Rem.

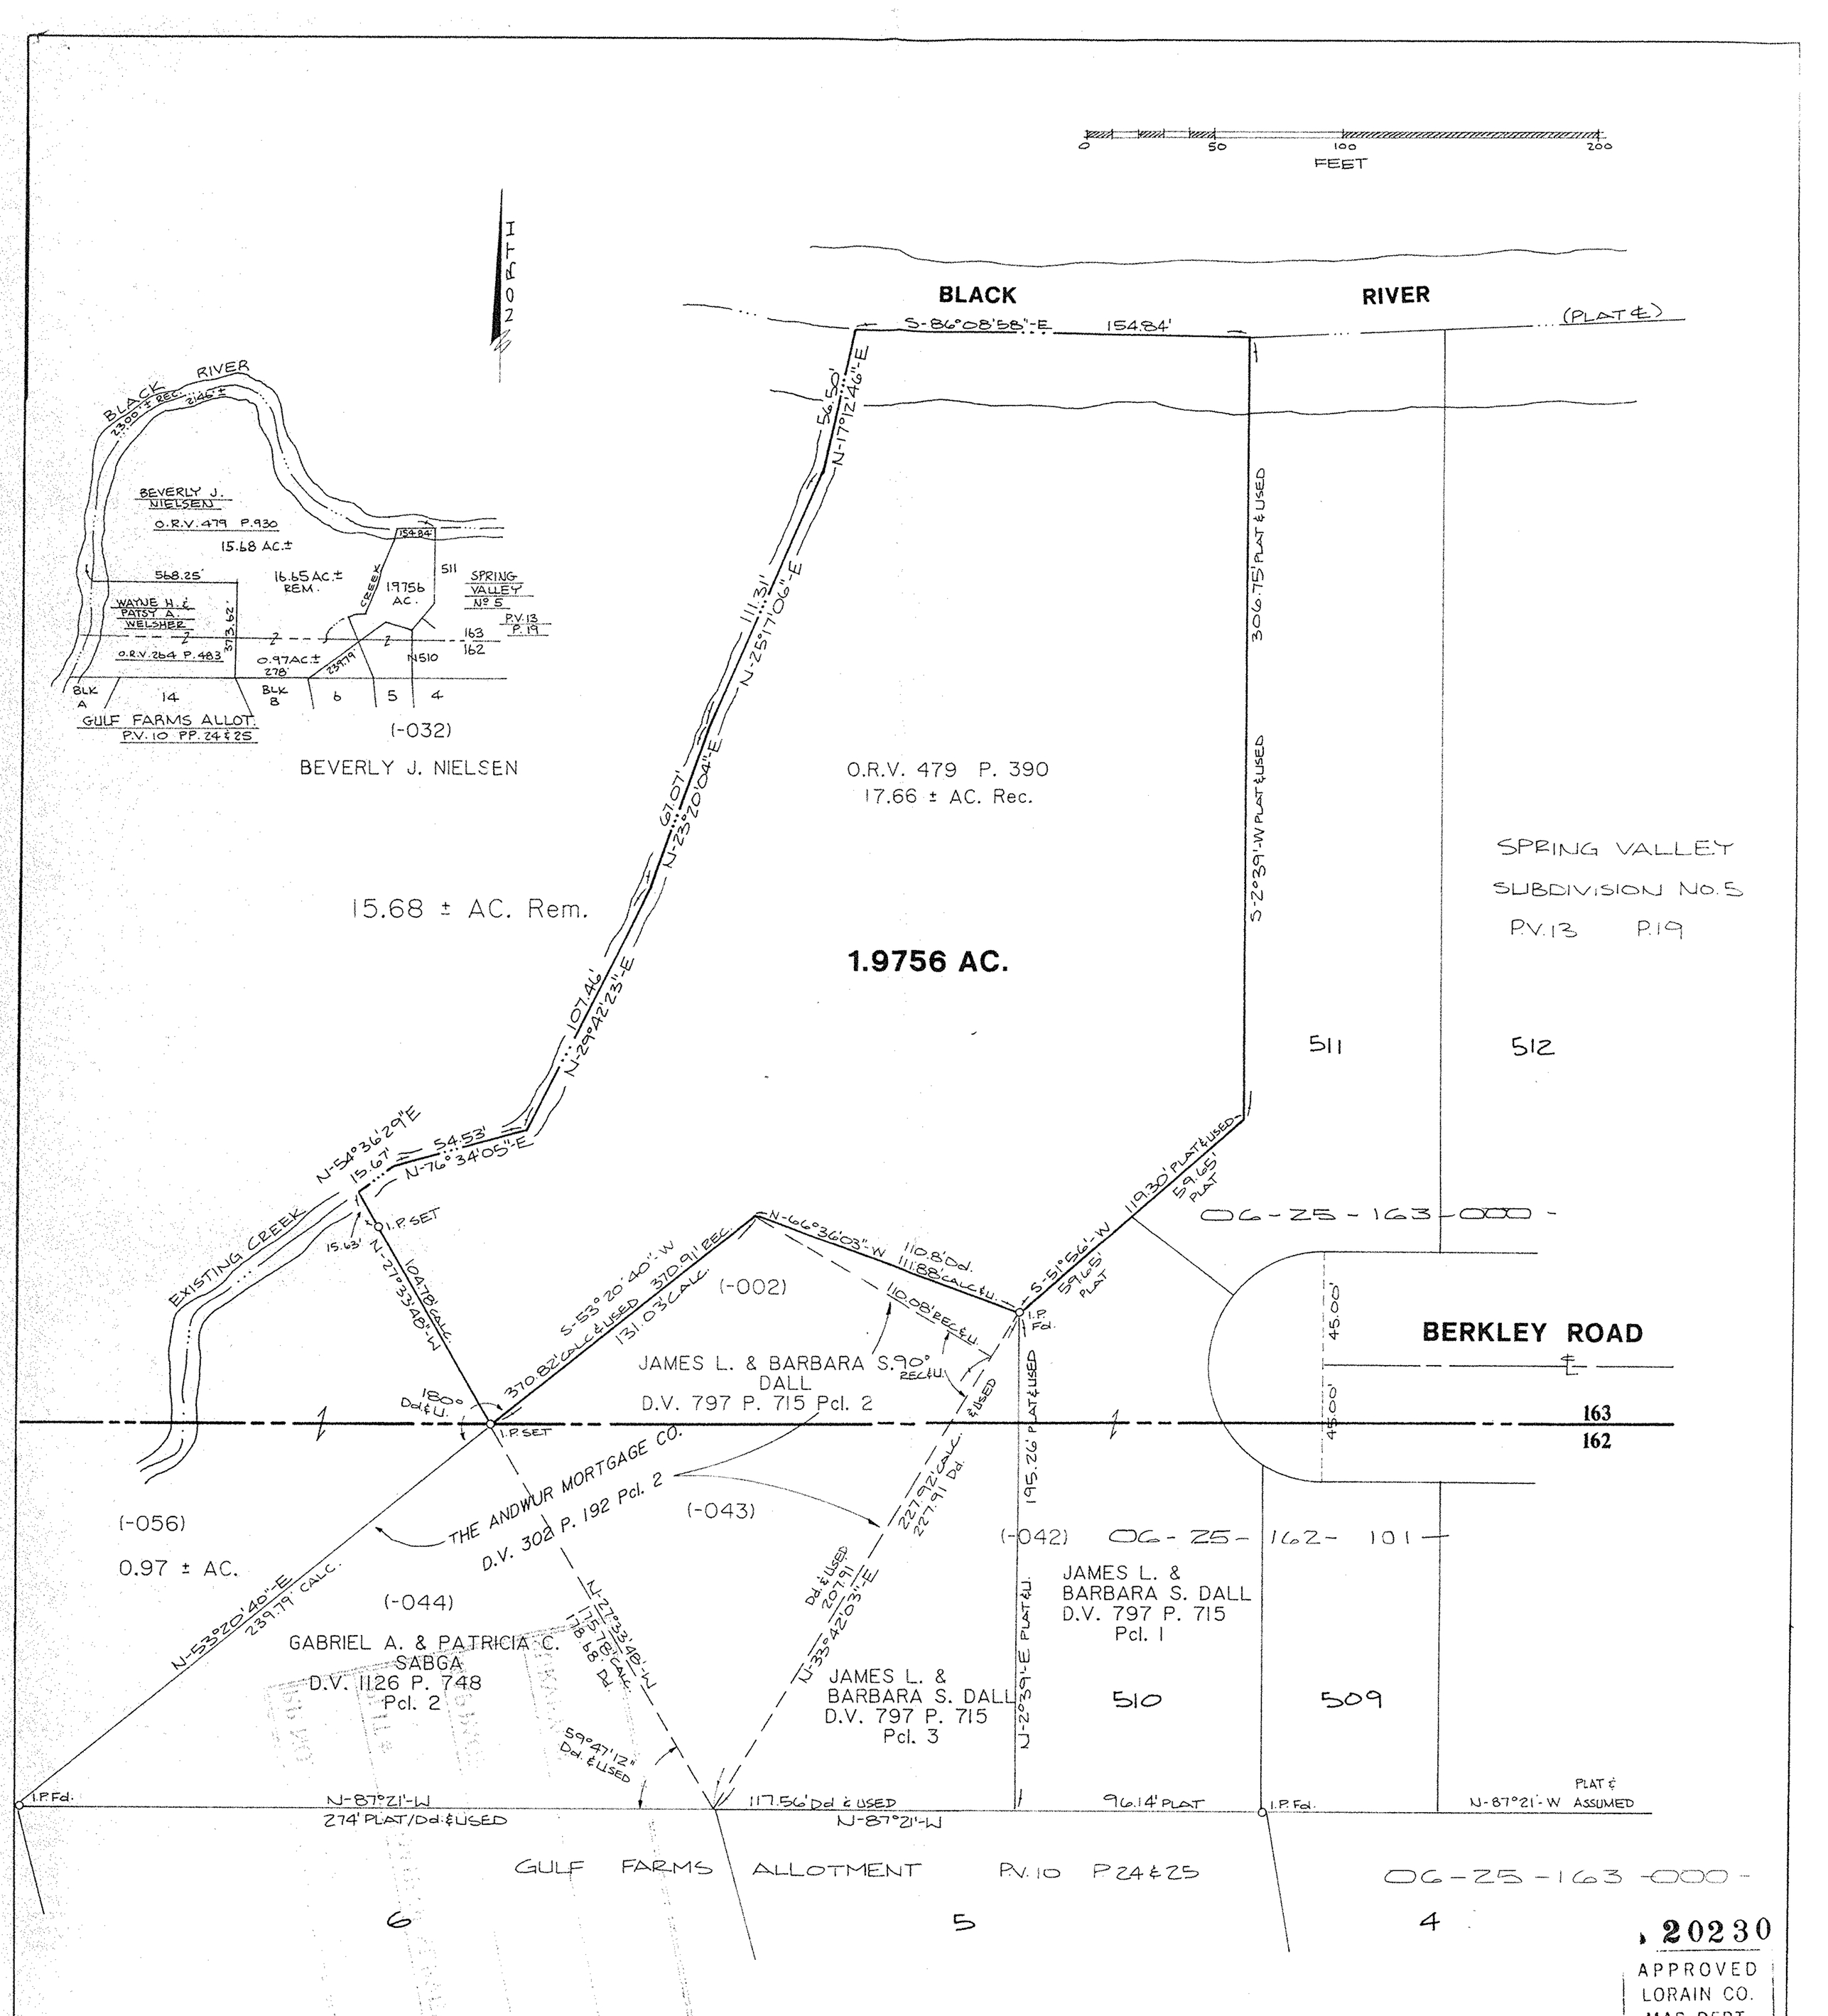

BOUNDARY SURVEY

OF PART OF

ELYRIA TOWNSHIP ORIGINAL LOTS 162 & 163
EAST OF BLACK RIVER
CITY OF ELYRIA COUNTY OF LORAIN
STATE OF OHIO

SCALE: 1" = 40'

NOV. 24, 1992

06-25-163-000-002
162-101-042, 043, 044

David L. Elwell
REG. SURVEYOR, NO. 6333

PREPARED BY:

KS ASSOCIATES INC.
ENGINEERS SURVEYORS

STATE OF OHIO
DAVID L. ELWELL
6333
REGISTERED
SURVEYOR

APPROVED
LORAIN CO.
MAP DEPT.
DATE 1-22-93
PAGE 6660 6-67
BY CAROLYN FRANCIS
VOID AFTER # 20230

20230

92-514