SURVEY NOTES

1.) D.V. 1101, P. 256, CALLS TO STONE MONUMENT AT SE. CORNER.

2.) D.V. 1262, P. 324, CALLS TO THE STONE MONUMENT AT ANGLE POINT IN W'LY LINE.

3.) DEEDS FOR AREAS ① & ②, SHOWN BELOW, AND SURVEY PINS FOUND CREATE OVERLAPPING AREAS. TITLE IS UNCLEAR AND OWNERSHIP HAS NOT BEEN DETERMINED BY THIS SURVEY.

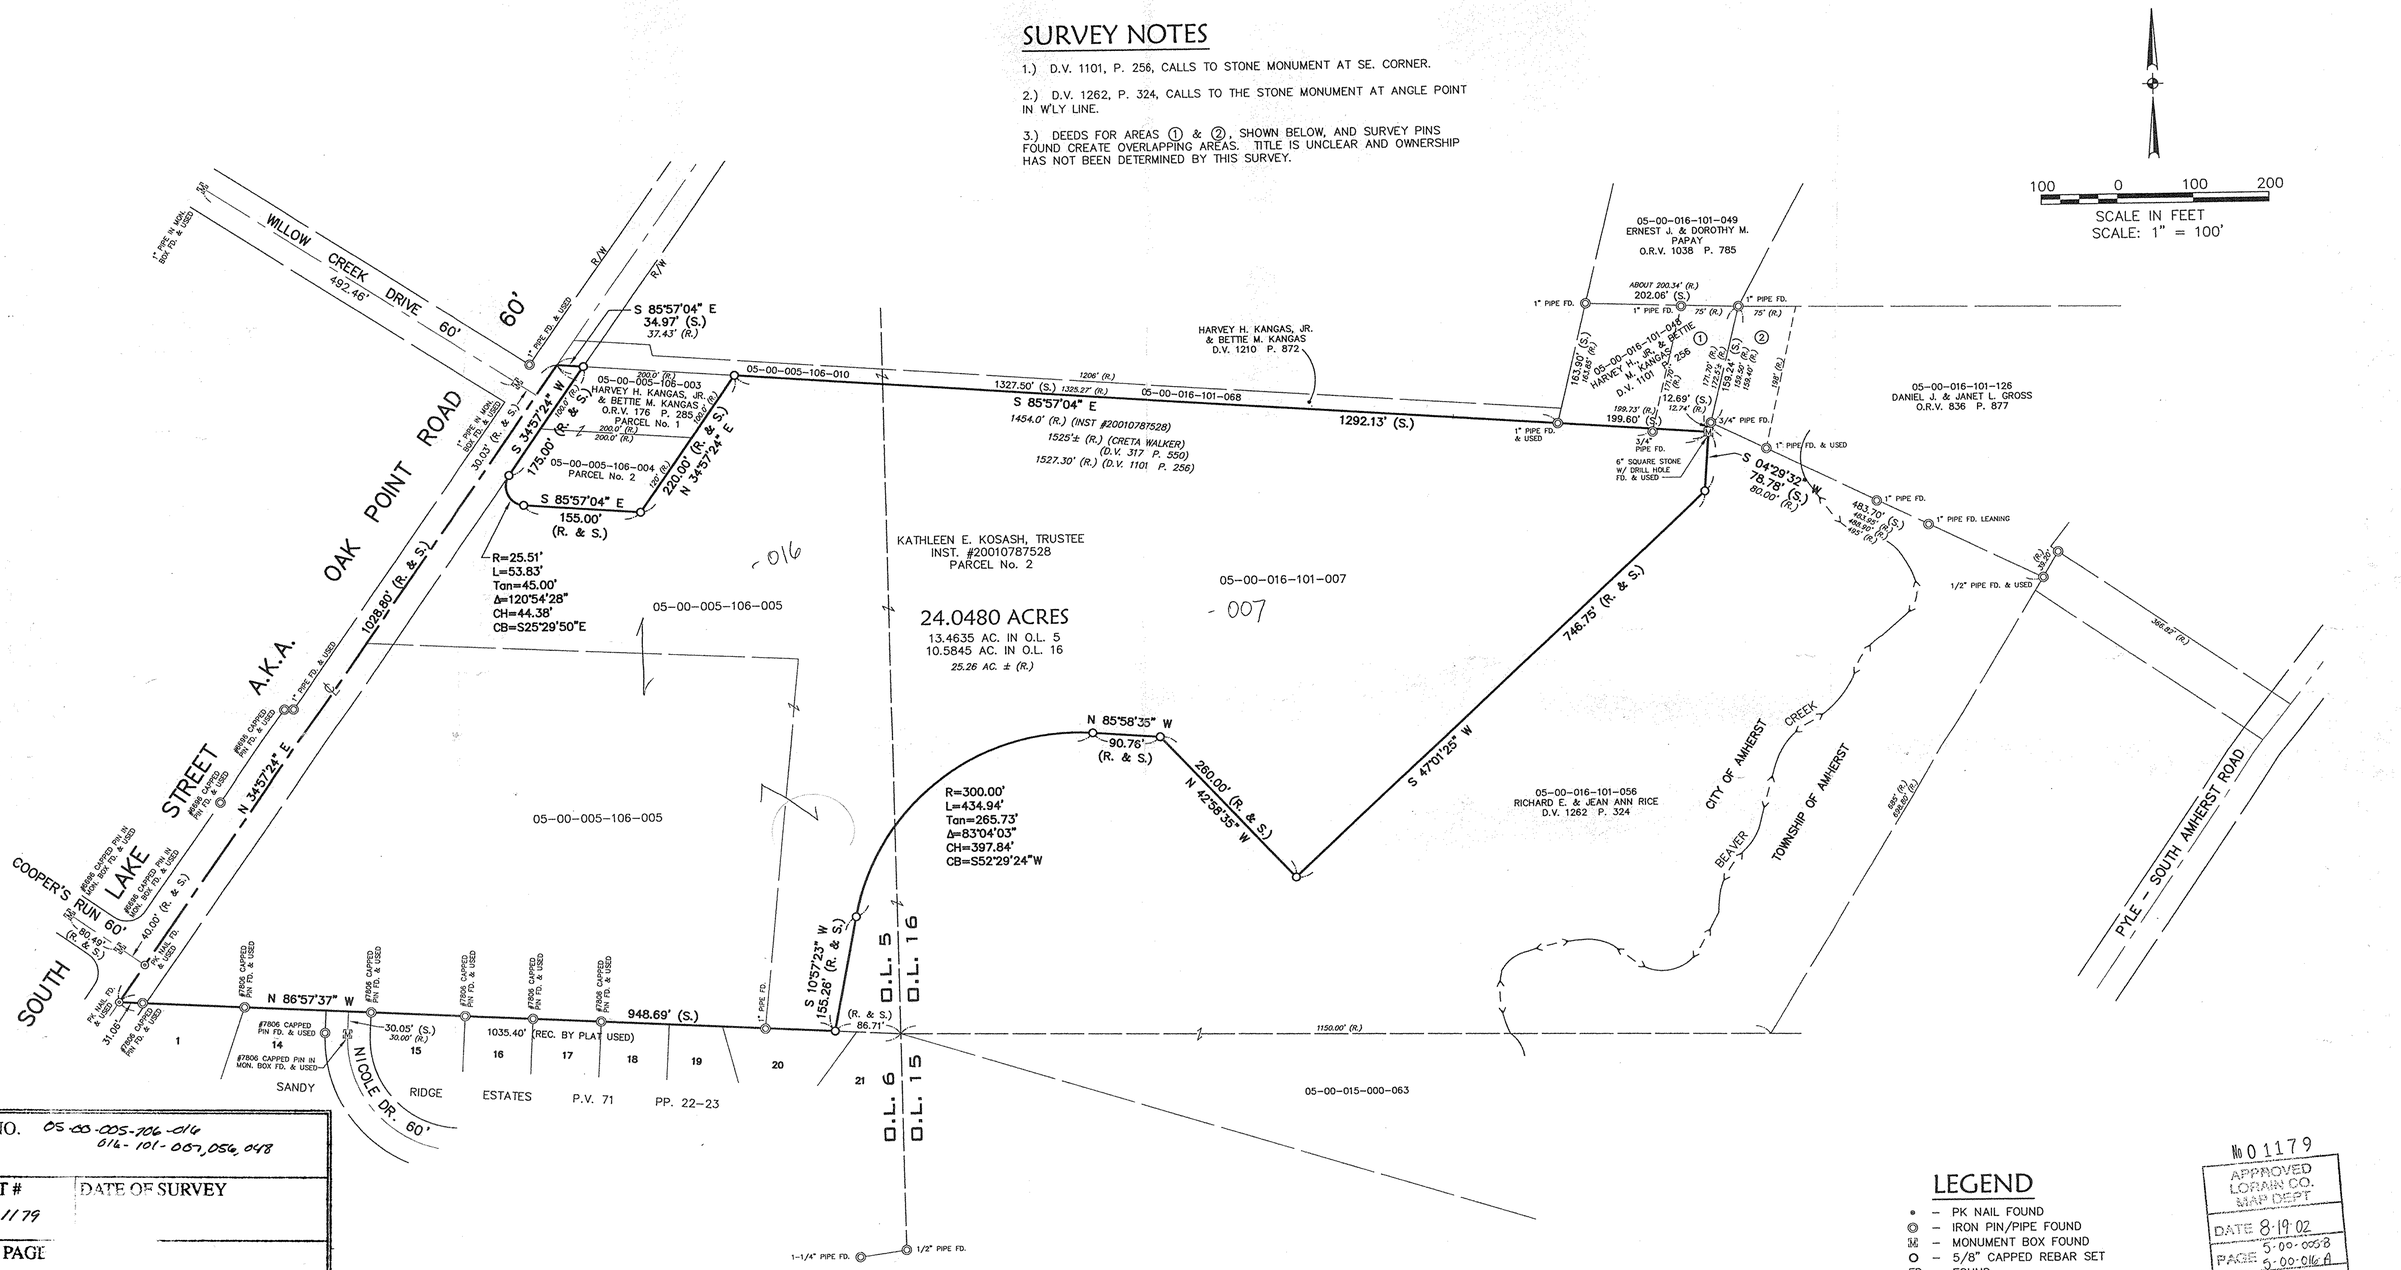

P.P. NO.	05-00-005-106-016 016-101-007, 056, 048
SPLIT # 01179	DATE OF SURVEY
MAP PAGE	5-00-005-B 016-A
SURVEYOR	David L. Elwell

LEGEND

- • – PK NAIL FOUND
- ◎ – IRON PIN/PIPE FOUND
- ⊠ – MONUMENT BOX FOUND
- O – 5/8" CAPPED REBAR SET
- FD. – FOUND
- R. – RECORD
- S. – SURVEYED
- U. – USED

№ 01179
APPROVED
LORAIN CO.
MAP DEPT
DATE 8-19-02
PAGE 5-00-005-B
5-00-016-A
BY JHatfield
02-01179

David L. Elwell 3-28-02
DAVID L. ELWELL, REG. SURVEYOR No. 6333

STATE OF OHIO
DAVID L. ELWELL
6333
REGISTERED
SURVEYOR

DATE:	3-27-02
DRAWN BY:	ABR
CH'D BY:	
DWG. NAME:	0-BASE01
PATH:	02040
F.B.	593

REVISIONS

DATE	DESCRIPTION	BY
3-28-02	ORIGINAL ISSUE	ABR

KS ASSOCIATES
KS ASSOCIATES, INC.
260 Burns Road, Suite 100
P.O. Box 569
Elyria, Ohio 44036
Phone (440) 365-4730
Fax (440) 365-4790
mailroom@ksassoc.com
www.ksassoc.com

BOUNDARY SURVEY

OF PART OF
ORIGINAL AMHERST TOWNSHIP LOTS NOS. 5 & 16
~~TOWNSHIP~~ CITY OF AMHERST COUNTY OF LORAIN STATE OF OHIO

SHEET 1 OF 1
JOB NO. 02040