LAND SUBDIVISION

VILLAGE OF SOUTH AMHERST ÷ LORAIN COUNTY ÷ OHIO

PART OF ORIGINAL SOUTH AMHERST TOWNSHIP LOT No. 9

MAY 1988
SCALE: 1" = 50'

MONUMENTS WERE FOUND OR SET AS SHOWN. DISTANCES ARE IN FEET AND DECIMALS. BEARINGS ARE FOR ANGLE CALCULATIONS ONLY. ALL OF WHICH WE CERTIFY TO BE CORRECT.

Vincent C. McGervey

CONSULTING ENGINEER & SURVEYOR
No. 4289

STATE OF OHIO — VINCENT C. McGERVEY — REGISTERED PROFESSIONAL ENGINEER

STATE OF OHIO — VINCENT C. McGERVEY 4289 — REGISTERED SURVEYOR

VINCENT C. McGERVEY
CIVIL ENGR. & SURVEYOR
2643 JOSEPH ST.
AVON OHIO 44011
937-5353

FOR
CLEVELAND QUARRIES CO.
AND
JAMES & PATRICIA LAMBERT

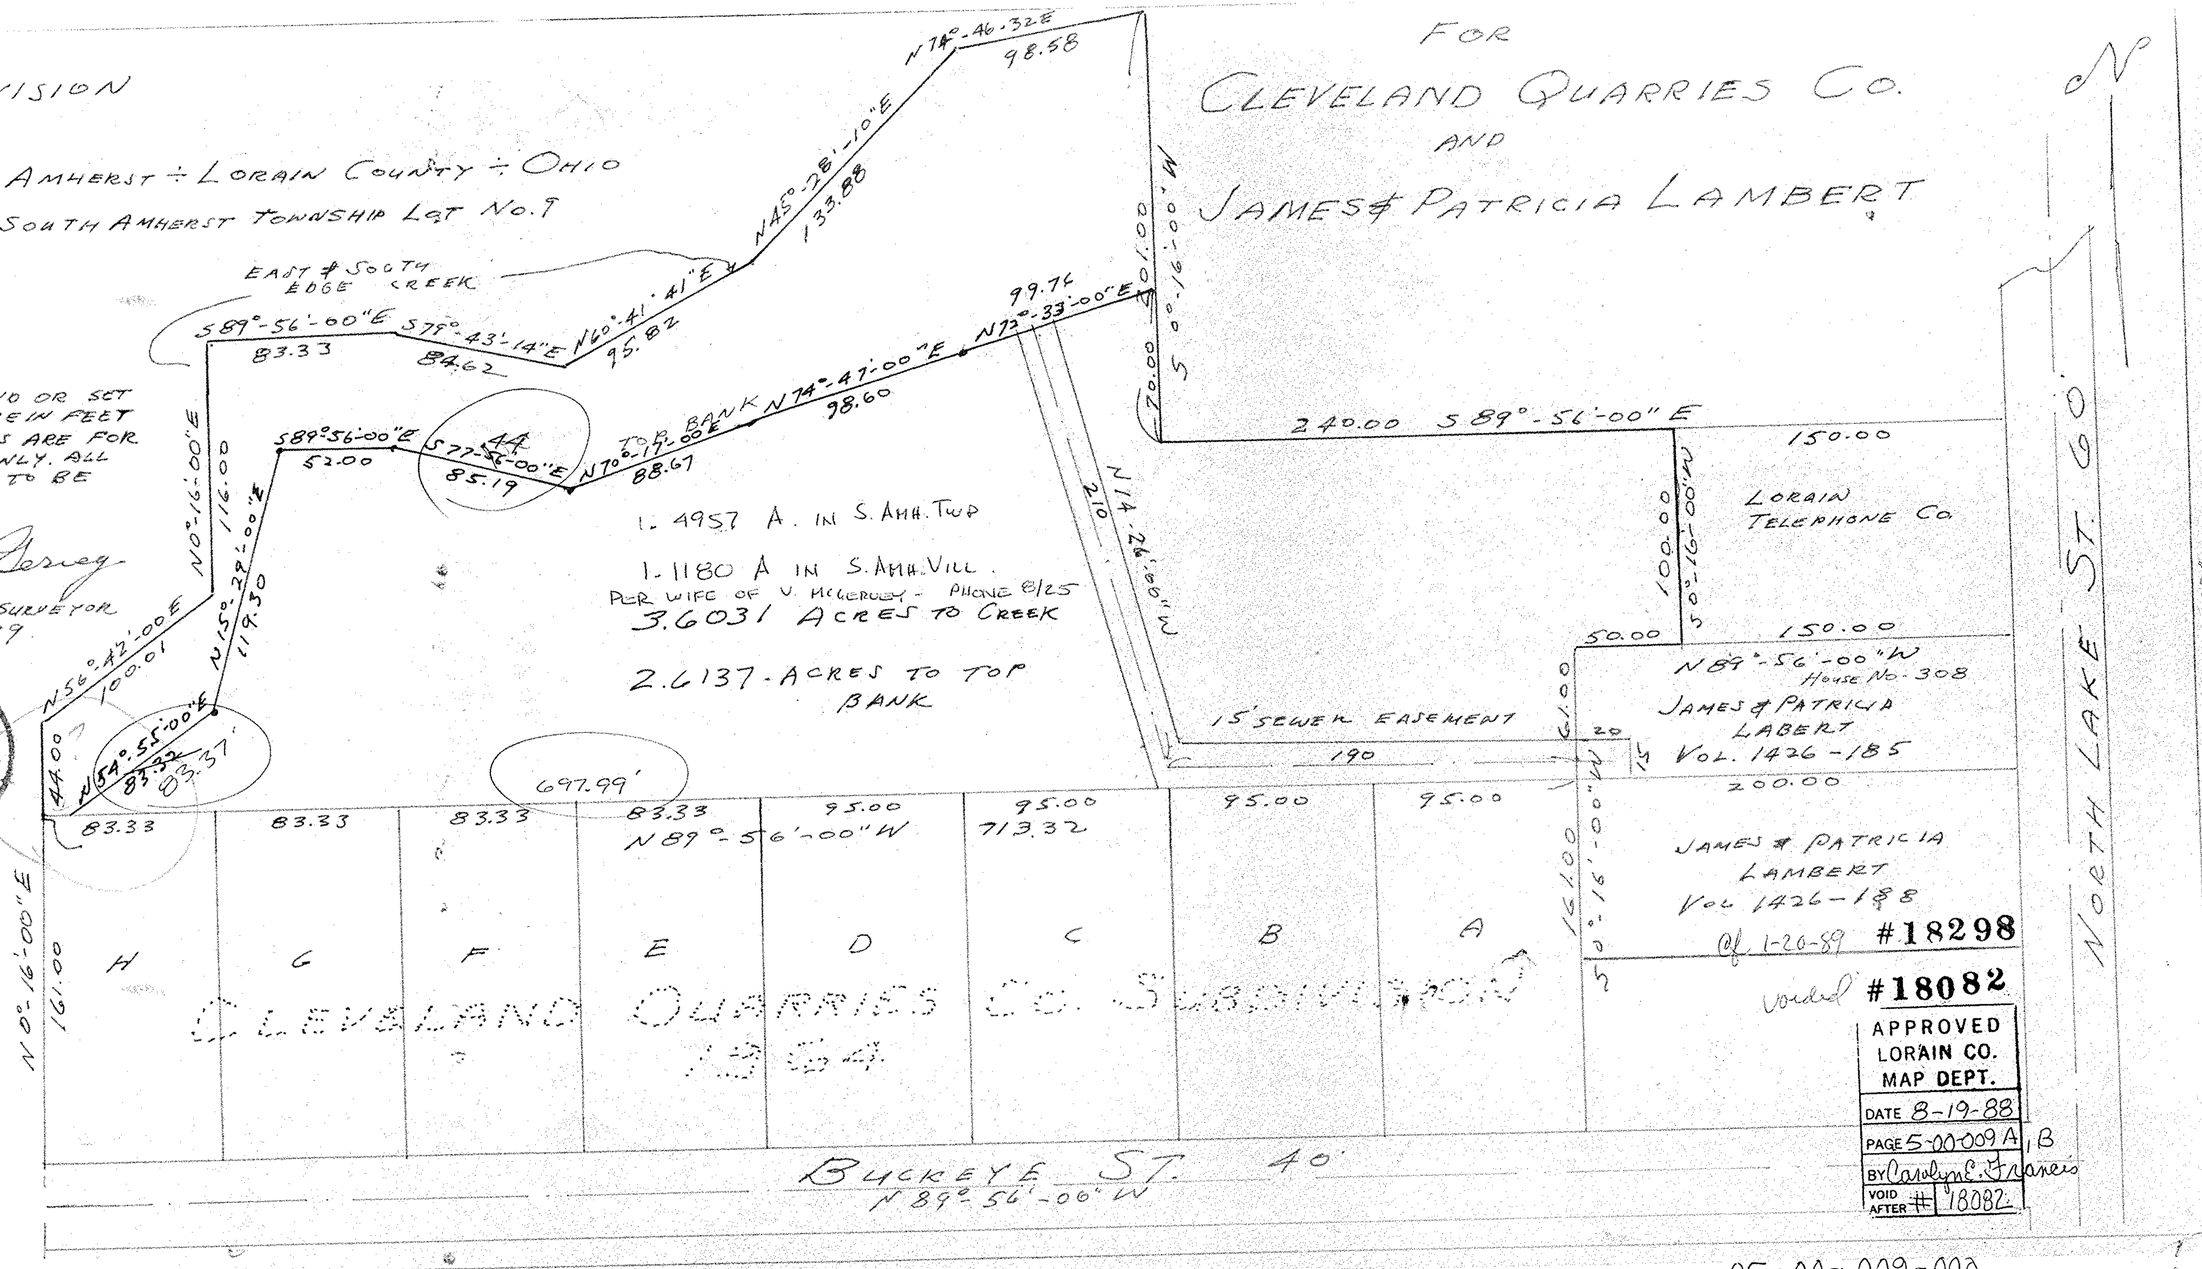

Cf. 1-20-89 #18298

Voided #18082

APPROVED
LORAIN CO.
MAP DEPT.
DATE 8-19-88
PAGE 5-00-009 A, B
BY Carolyn E. Francis
VOID AFTER # 18082

05-00-009-000

041056 059-052 054