DANE A. HAPONEK • Engineers & Surveyors
34100 Center Ridge Road • NORTH RIDGEVILLE, OHIO 44039 (216) 327-4776 • Lorain 288-4400

05-00-012-A

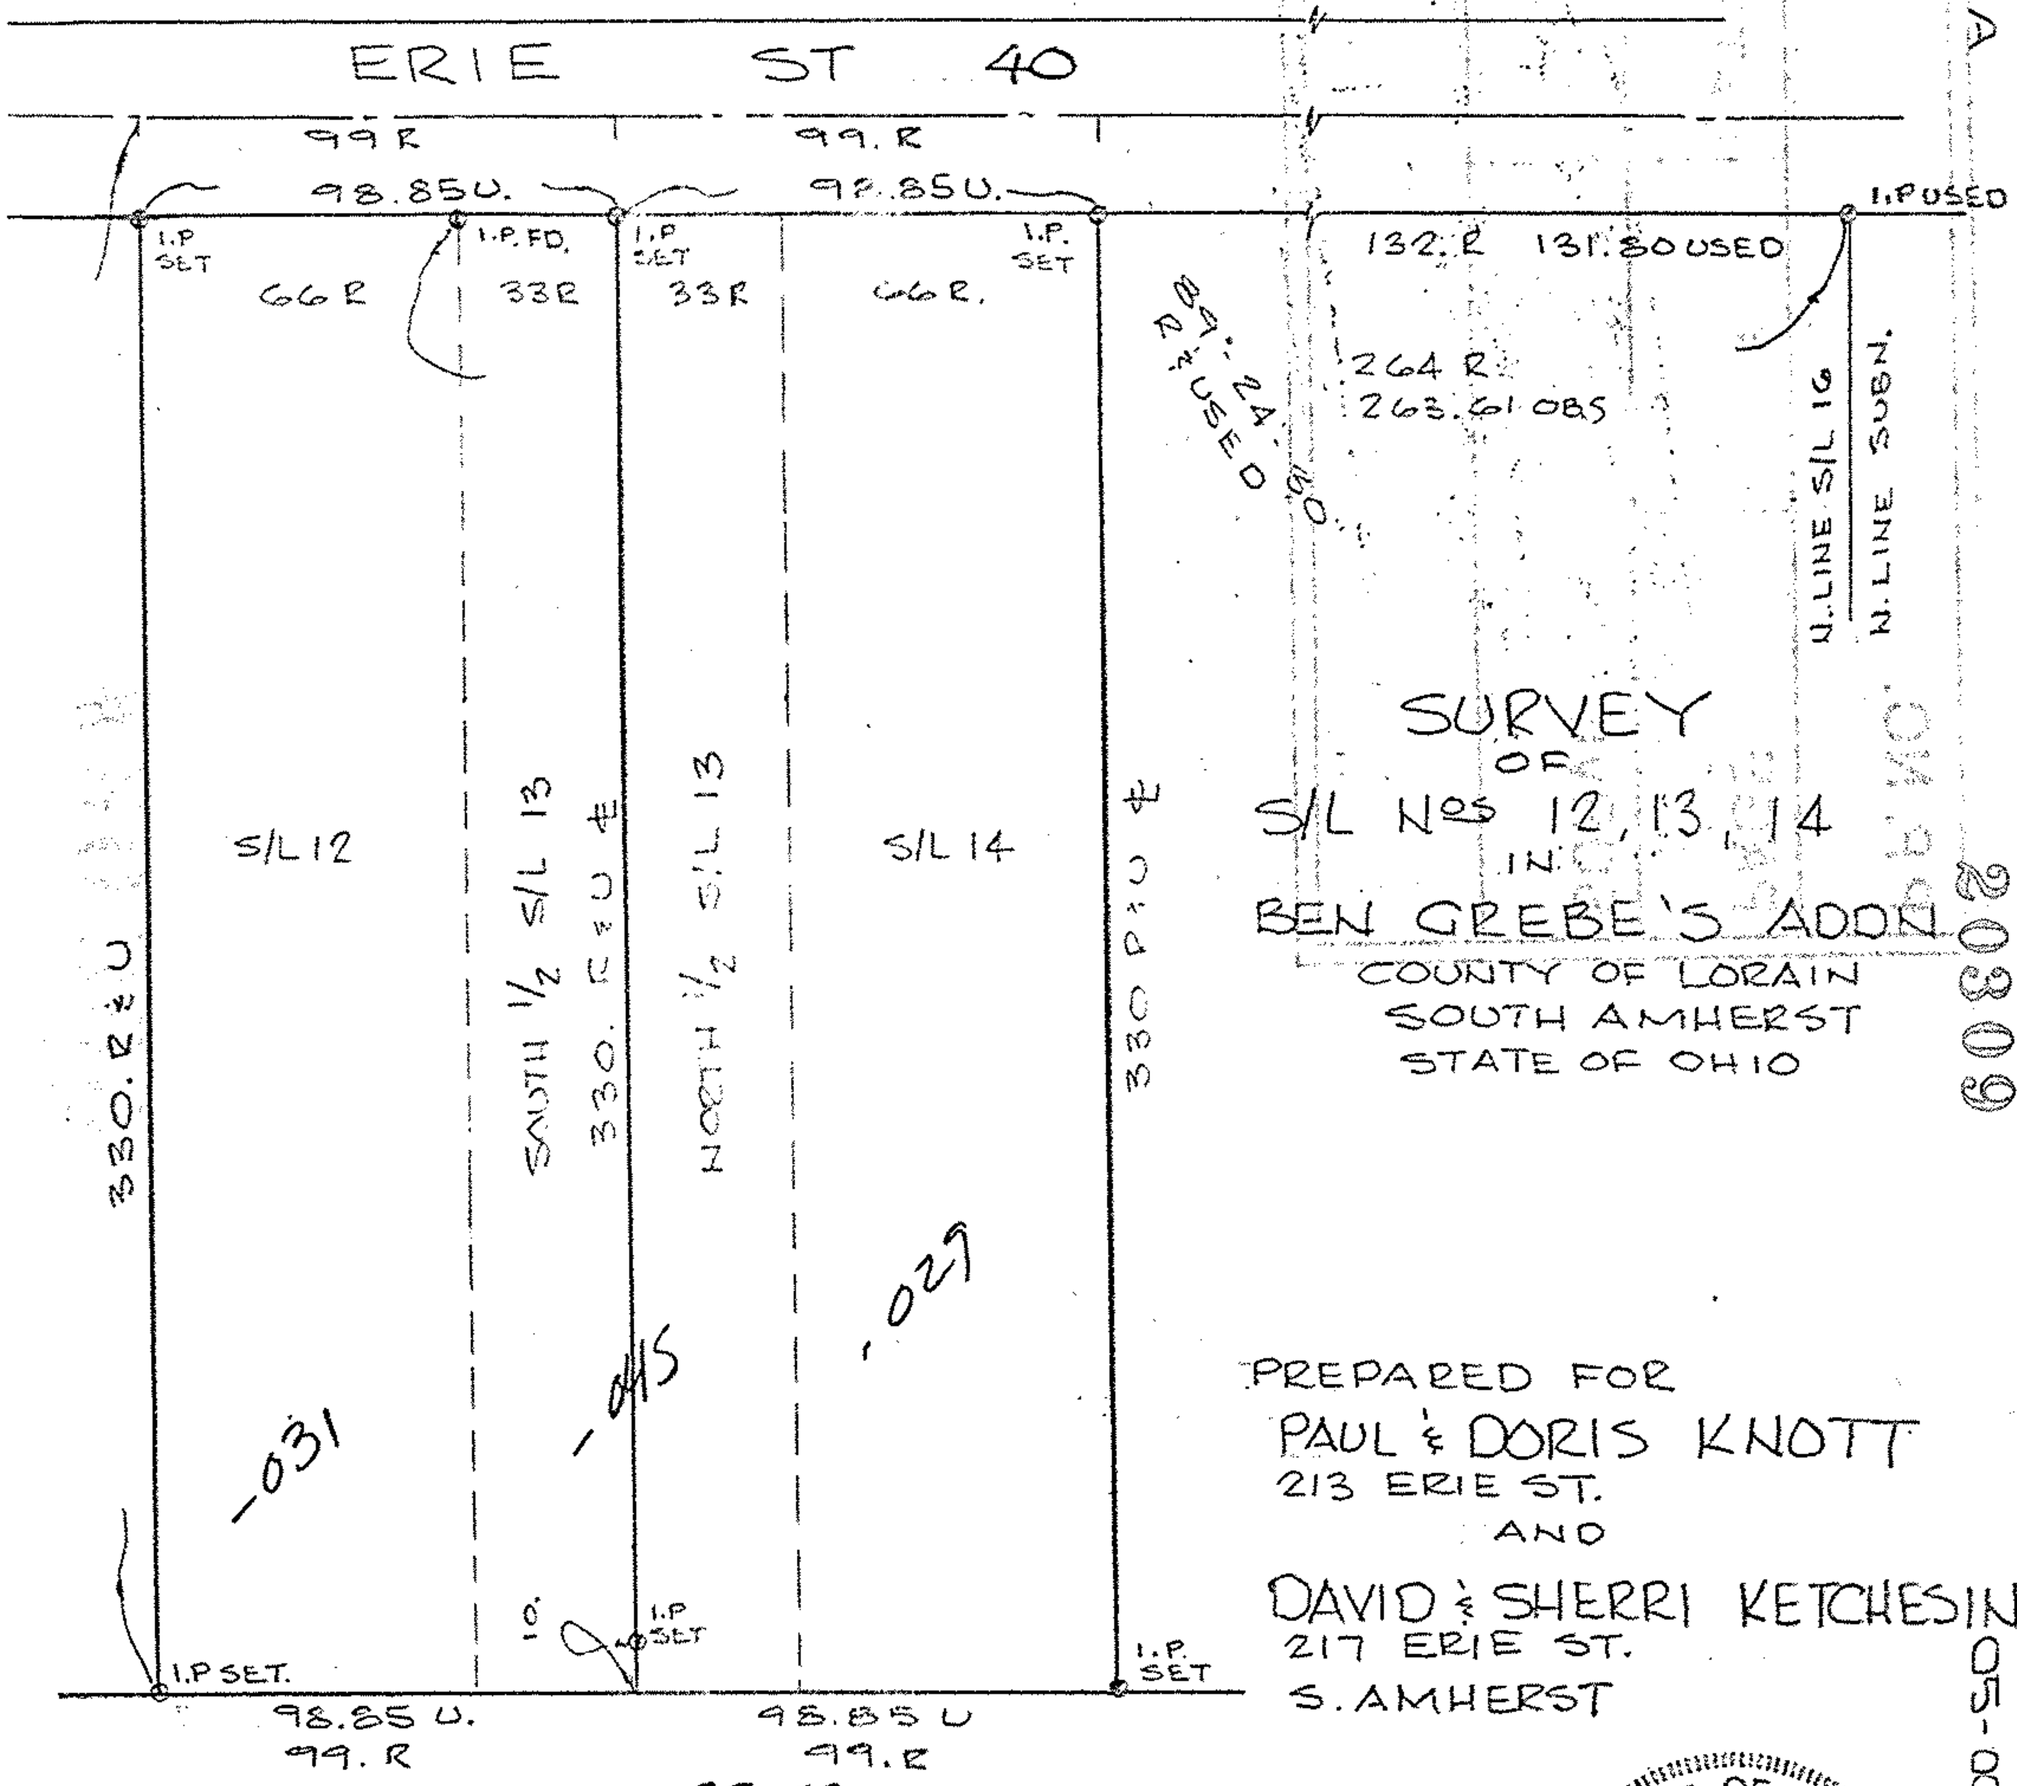

SURVEY
OF
S/L Nos 12, 13, 14
IN
BEN GREBE'S ADDN
COUNTY OF LORAIN
SOUTH AMHERST
STATE OF OHIO

PREPARED FOR
PAUL & DORIS KNOTT
213 ERIE ST.
AND
DAVID & SHERRI KETCHESIN
217 ERIE ST.
S. AMHERST

05-00-012-101-031, 029 & 015

APPROVED
LORAIN CO.
MAP DEPT.
DATE 3-25-93
PAGE 5-00-012-A
BY CAROLYN FRANCIS
VOID AFTER # 20309

20309

DATE: FEB 1993
SCALE: 1" = 50'

STATE OF OHIO
DANE A. HAPONEK
S-6211
REGISTERED SURVEYOR

05-00-012-101

20309