05-00-024-111

RECORD DRAWING OF PART OF ORIGINAL LOT NO. 24 AMHERST TOWNSHIP LORAIN COUNTY STATE OF OHIO

SCALE: 1" = 50'

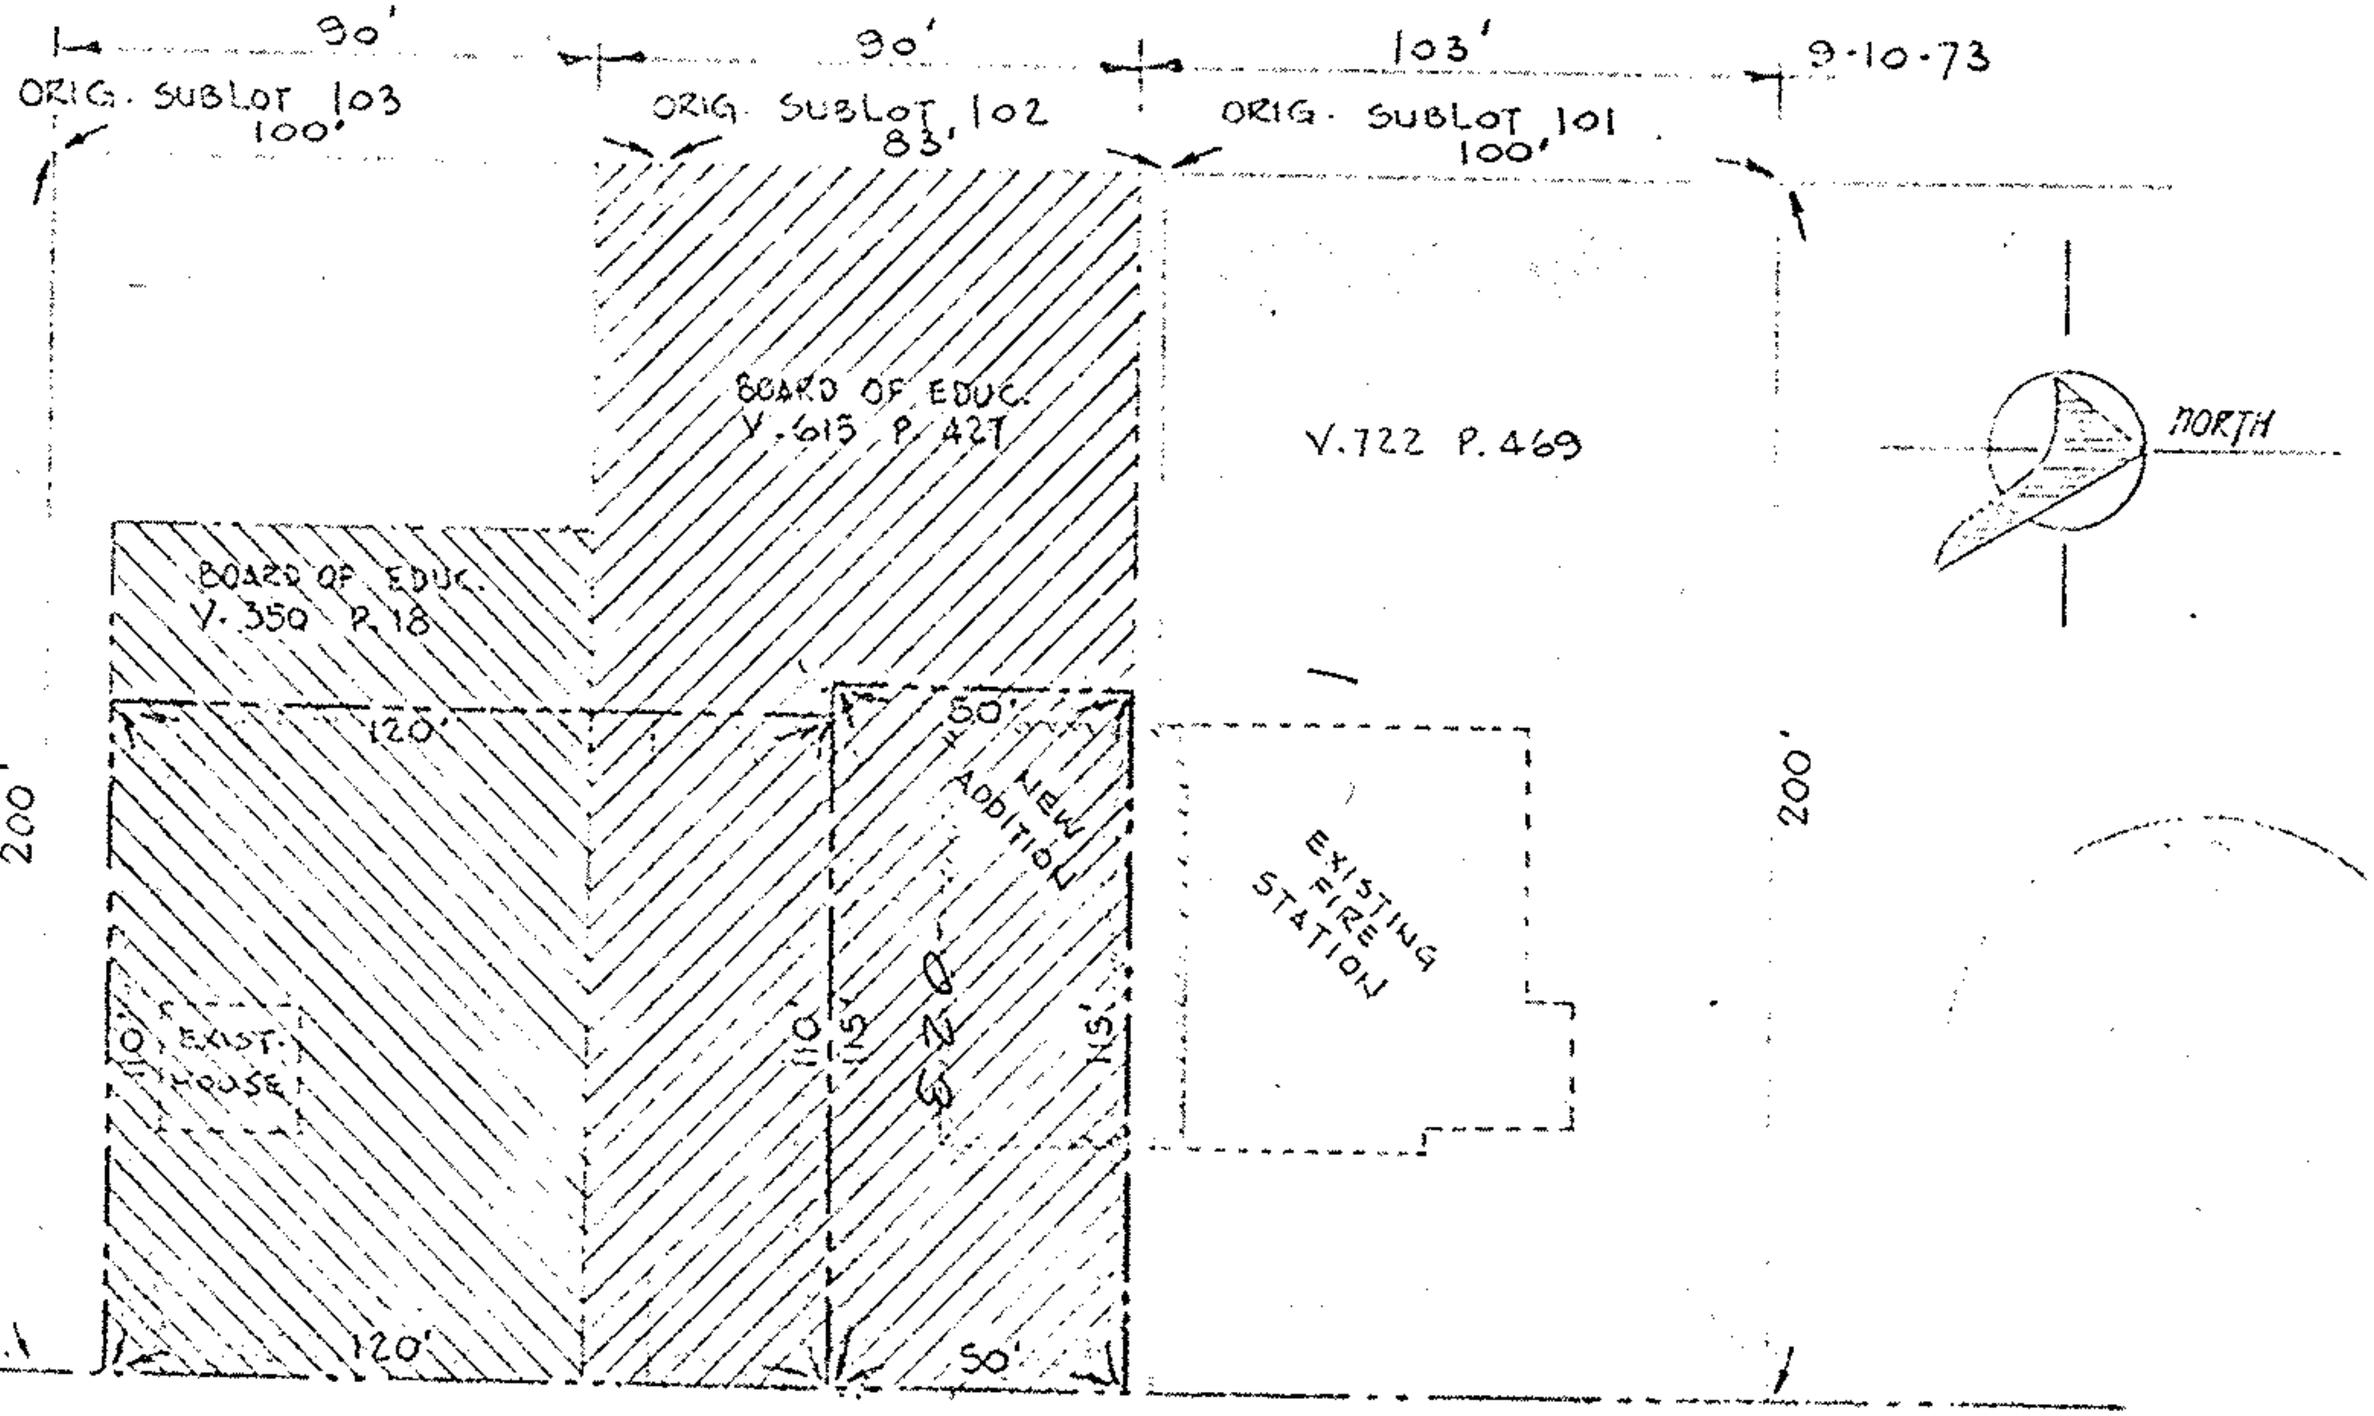

05-00-024-111-023

PREPARED BY
R.E. WARNER & ASSOCIATES
ENGINEERS & SURVEYORS
SEPT. 1973

Amherst #8146
Lot 24

7-20-00-5