50 0 50 100

SCALE IN FEET

SCALE: 1" = 50'

BEARINGS ARE BASED ON THE CENTERLINE OF PARK AVENUE (N 89°52'00" E) AS RECORDED IN O.R.V. 938 P. 82

LEGEND

◎ IRON PIN/PIPE FOUND

○ 5/8"x30" CAPPED REBAR SET

ABBREVIATIONS

FND. = FOUND
REC. = RECORD
O.L. = ORIGINAL LOT
SURV. = SURVEYED

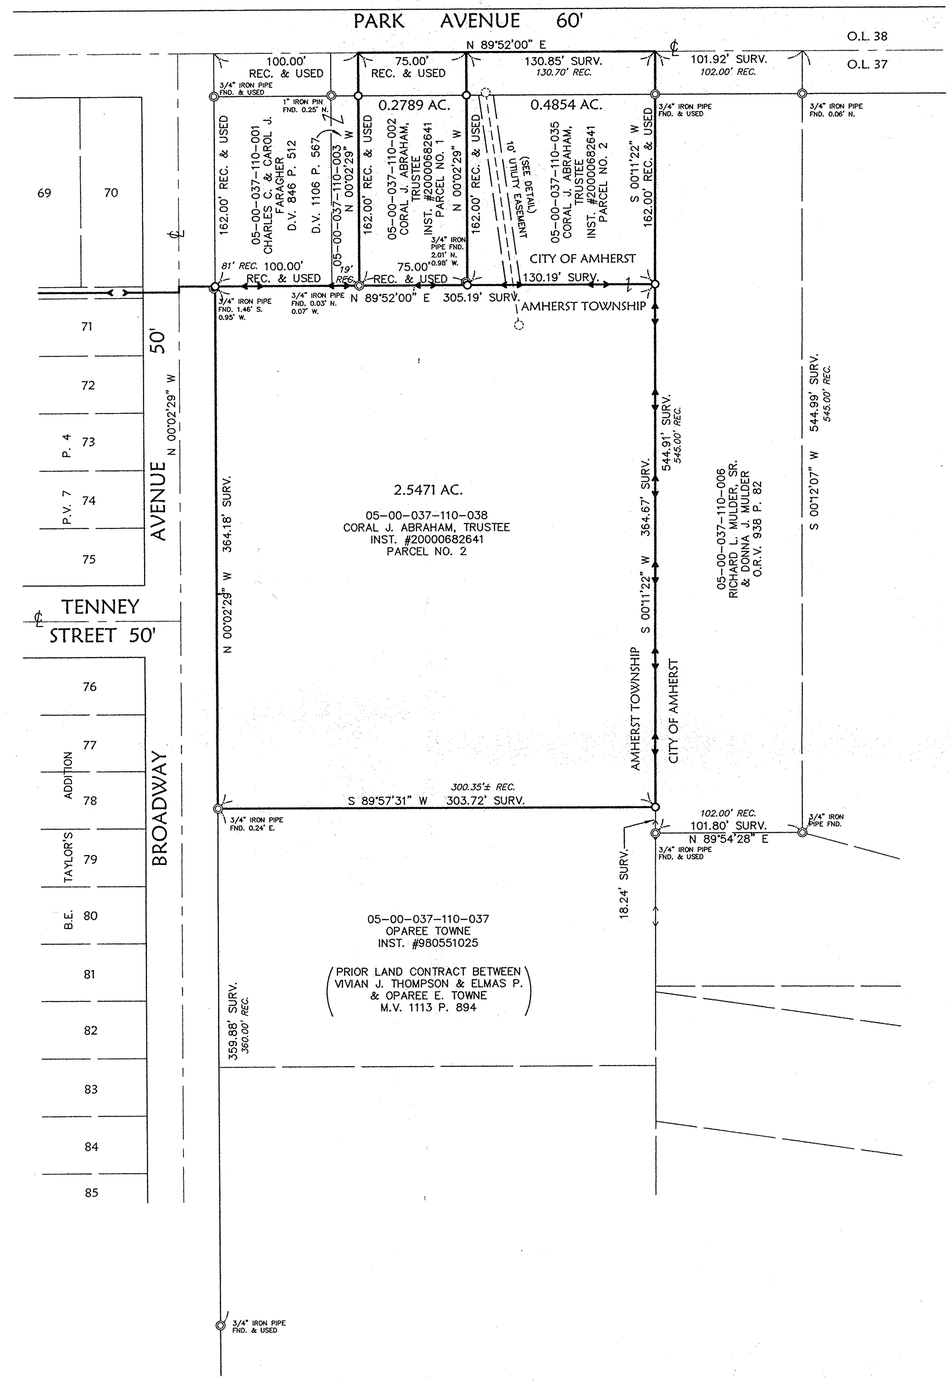

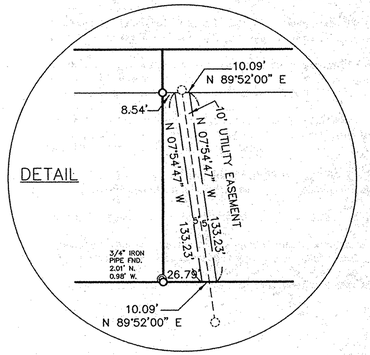

P.P. NO. 05-00-037-110-002, 035, 038

SPLIT # #04-010064-A

SURVEY Feb. 2001

MAP PAGE 05-00-037-A

SURVEYOR David L. Elwell

APPROVED LORAIN CO. MAP DEPT

DATE 10/21/04

PAGE 05-00-037-A

BY D. Holland #04-010064-A

David L. Elwell

DAVID L. ELWELL, REG. SURVEYOR NO. 6333

STATE OF OHIO DAVID L. ELWELL 6333 REGISTERED SURVEYOR

DATE: 2-02-01
DRAWN BY: AMK
CH'D BY: TAB
DWG. NAME: 0-SURV01
PATH: 98000\98135-00\LDDT\
F.B. 556

REVISIONS	DATE	DESCRIPTION	BY

KS ASSOCIATES

KS ASSOCIATES, INC.
260 Burns Road, Suite 100
P.O. Box 569
Elyria, Ohio 44036
Phone (440) 365-4730
Fax (440) 365-4790
mailroom@ksassoc.com
www.ksassoc.com

BOUNDARY SURVEY MAP

OF PART OF
ORIGINAL AMHERST TOWNSHIP LOT NO. 37
CITY & TOWNSHIP OF AMHERST COUNTY OF LORAIN STATE OF OHIO

SHEET 1 OF 1

JOB NO. 98135-00