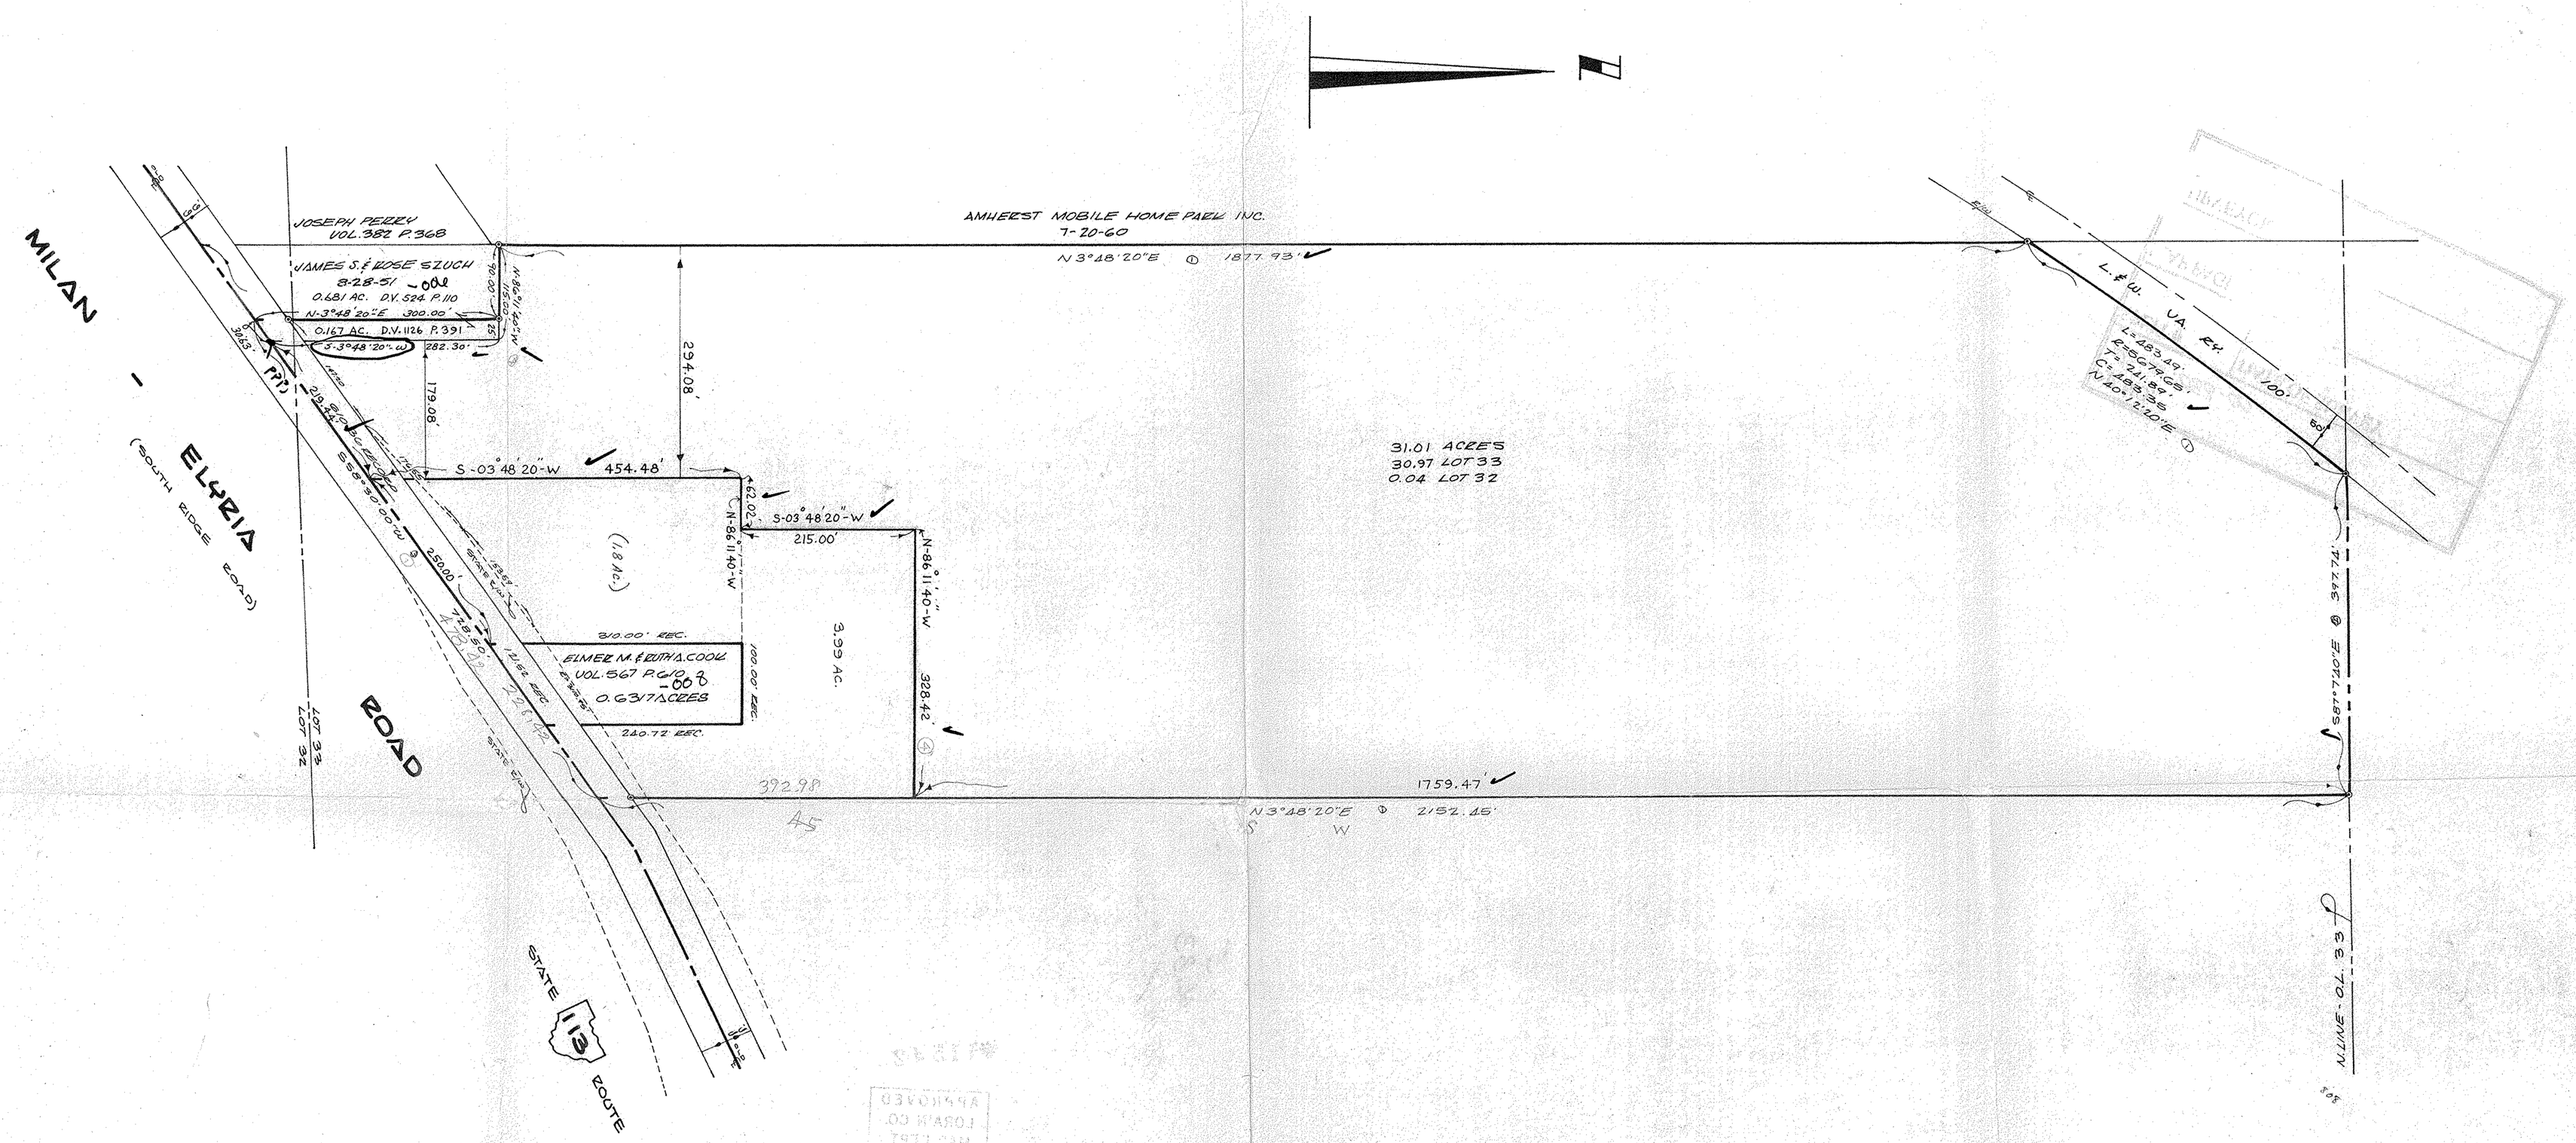

SURVEY
PART OF
ORIGINAL AMHERST TOWNSHIP
LOTS NUMBERS 33 & 32
COUNTY OF LORAIN STATE OF OHIO

PREPARED FOR
ELMER M. COOK
ELYRIA OHIO

PREPARED BY
JAMES H. SCHMIDT
REGISTERED SURVEYOR
ELYRIA OHIO

JANUARY, 1971
REVISED MAR. 17, 1975
REVISED MAR. 9, 1978 K.V.S.

SCALE: 1"=100'

P.P. NO. 05-00-033-000-008,006	
SPLIT # 11542	DATE OF SURVEY Jan. 1971
MAP PAGE 05-00-033-B	
SURVEYOR James H. Schmidt	

70402