MAP OF SURVEY AND LOT SPLIT

PREPARED FOR

DALE L. AND JOYCE E. HARLAN

SITUATED IN THE TOWNSHIP OF LAGRANGE, COUNTY OF LORAIN, STATE OF OHIO AND BEING KNOWN AS PART OF ORIGINAL LAGRANGE TOWNSHIP LOT 95 AND BEING ALL OF PARCEL 1 DEEDED TO DALE L. AND JOYCE E. HARLAN IN DEED O.R. VOLUME 916, PAGE 373 OF LORAIN COUNTY DEED RECORDS.

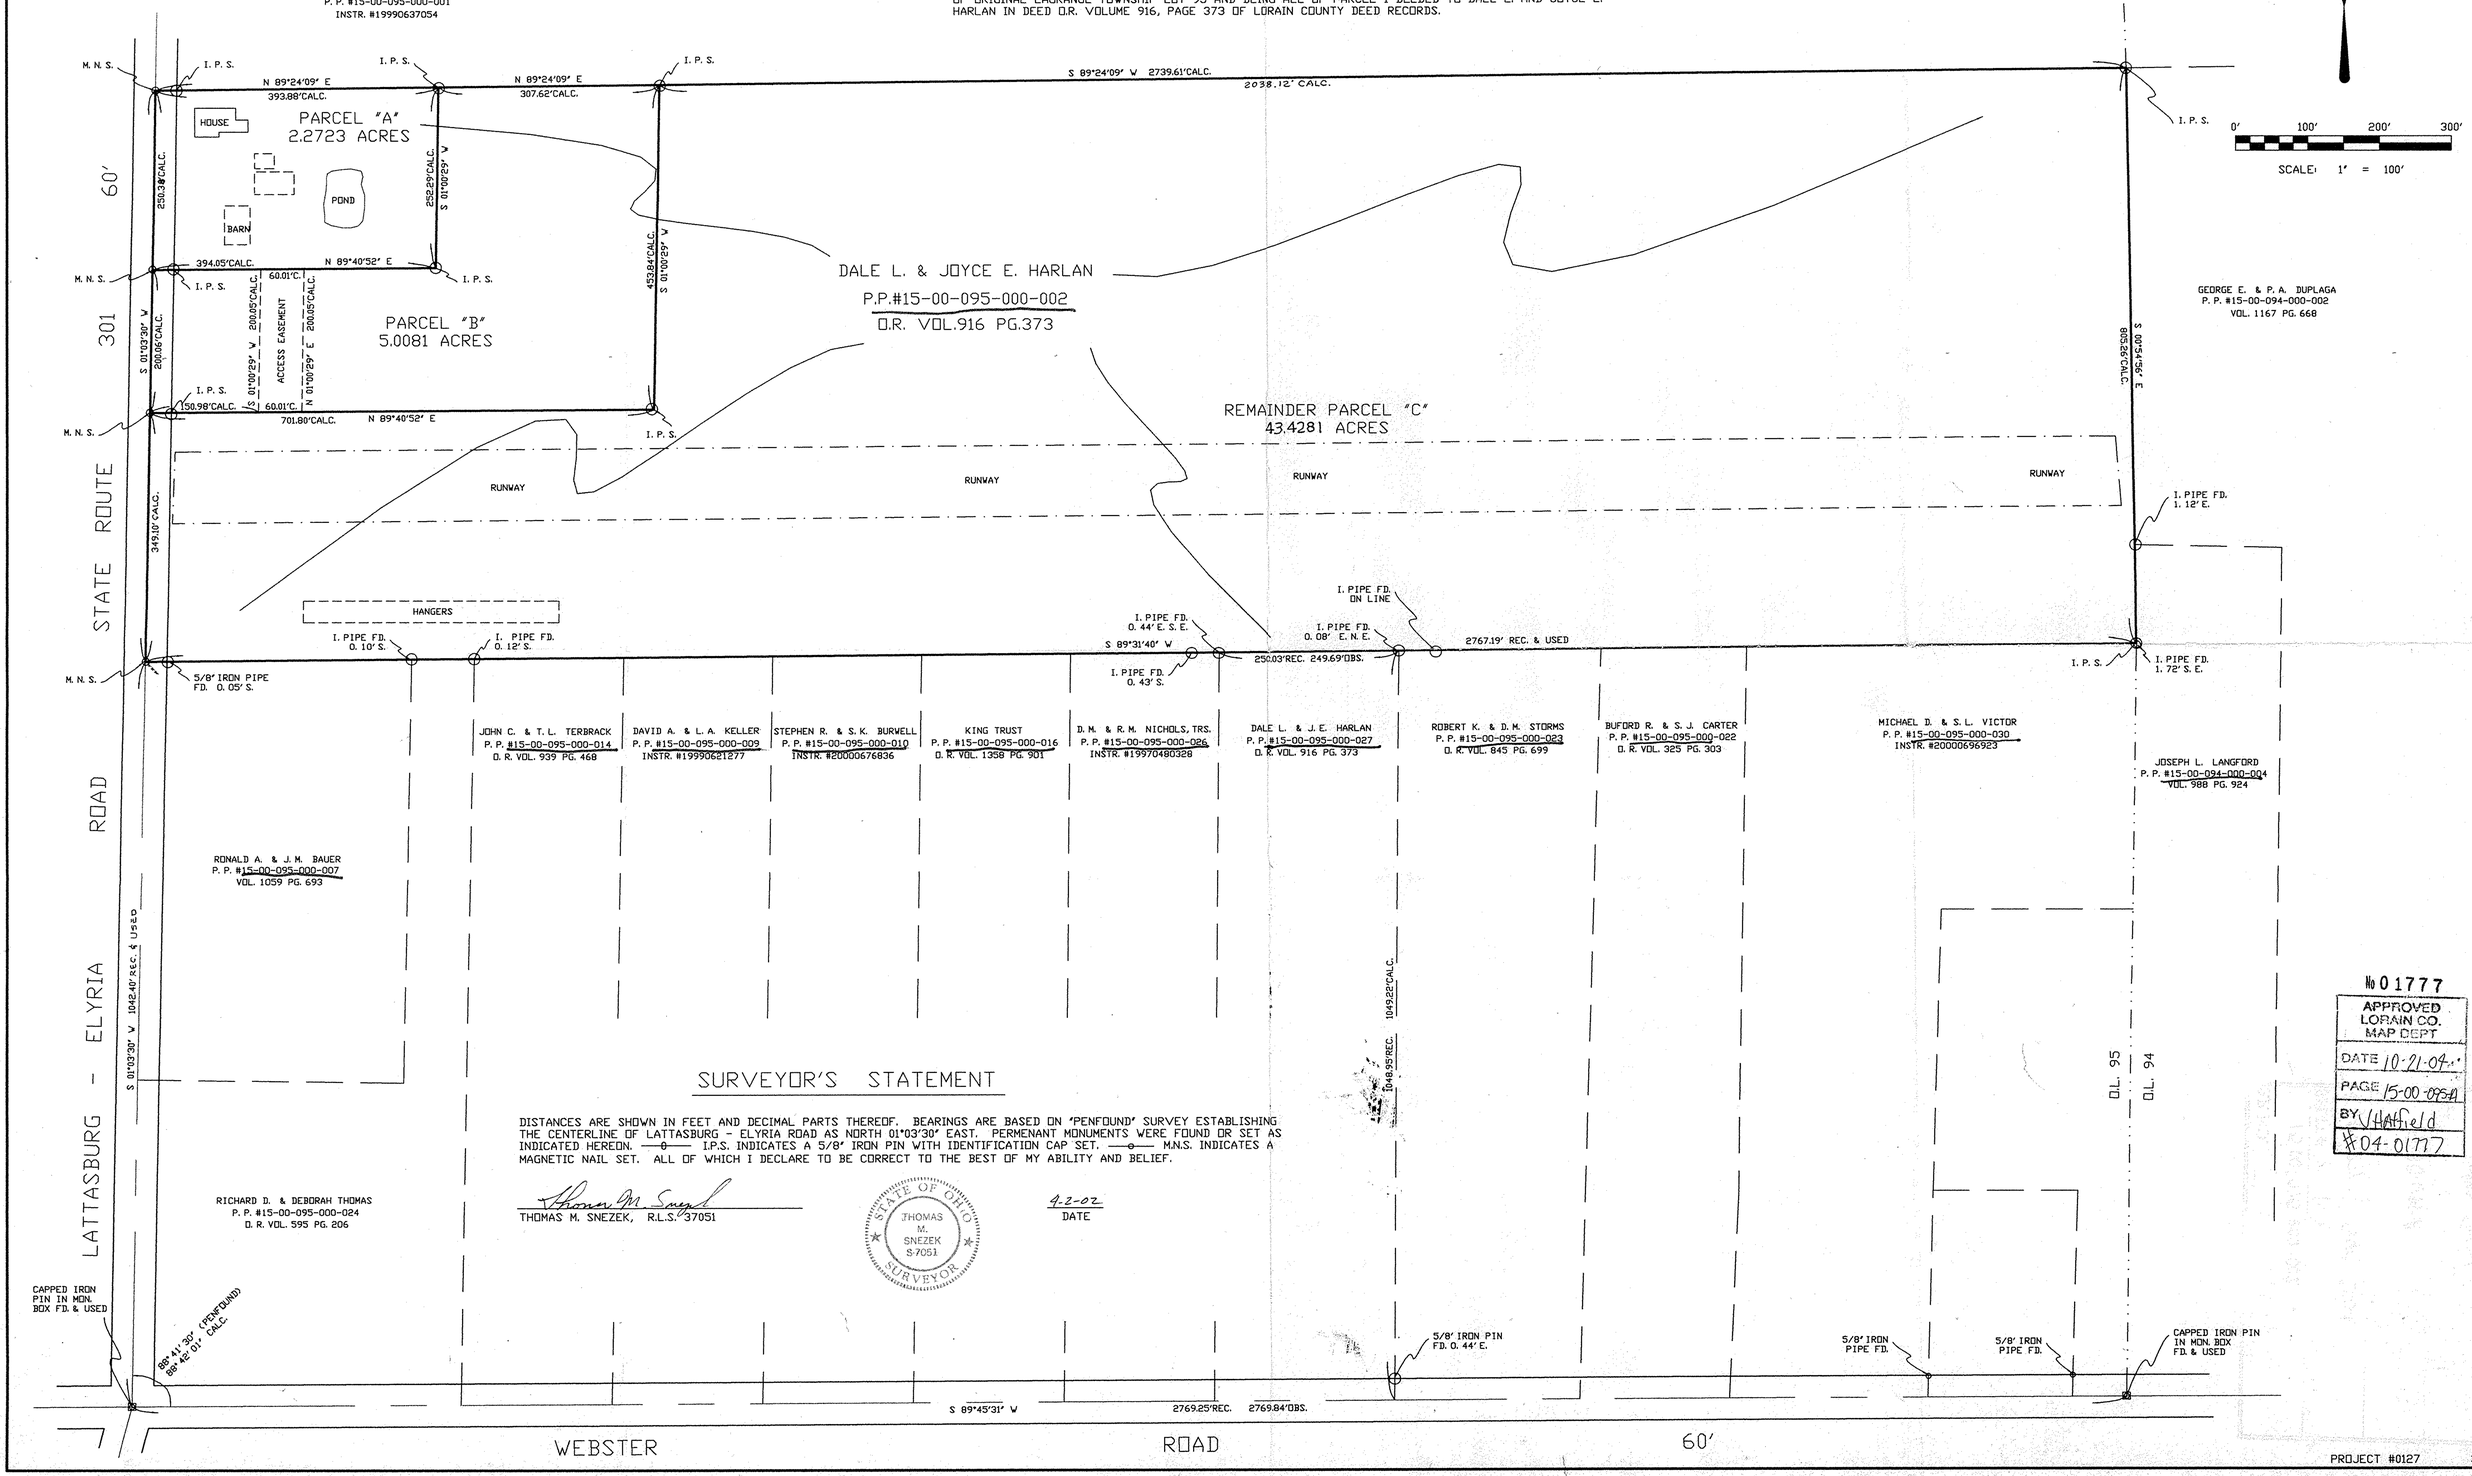

SURVEYOR'S STATEMENT

DISTANCES ARE SHOWN IN FEET AND DECIMAL PARTS THEREOF. BEARINGS ARE BASED ON 'PENFOUND' SURVEY ESTABLISHING THE CENTERLINE OF LATTASBURG - ELYRIA ROAD AS NORTH 01°03'30" EAST. PERMENANT MONUMENTS WERE FOUND OR SET AS INDICATED HEREON. —o— I.P.S. INDICATES A 5/8" IRON PIN WITH IDENTIFICATION CAP SET. —●— M.N.S. INDICATES A MAGNETIC NAIL SET. ALL OF WHICH I DECLARE TO BE CORRECT TO THE BEST OF MY ABILITY AND BELIEF.

Thomas M. Snezek

THOMAS M. SNEZEK, R.L.S. 37051

STATE OF OHIO — THOMAS M. SNEZEK S-7051 — SURVEYOR

4-2-02
DATE

No 01777
APPROVED
LORAIN CO.
MAP DEPT
DATE 10-21-04
PAGE 15-00-095A
BY VHatfield
#04-01777

PROJECT #0127 3/25/02