05-00-033-000

Scale 1" = 100'
By Arnold F. Koepp Reg. Surveyor

July 7, 1983

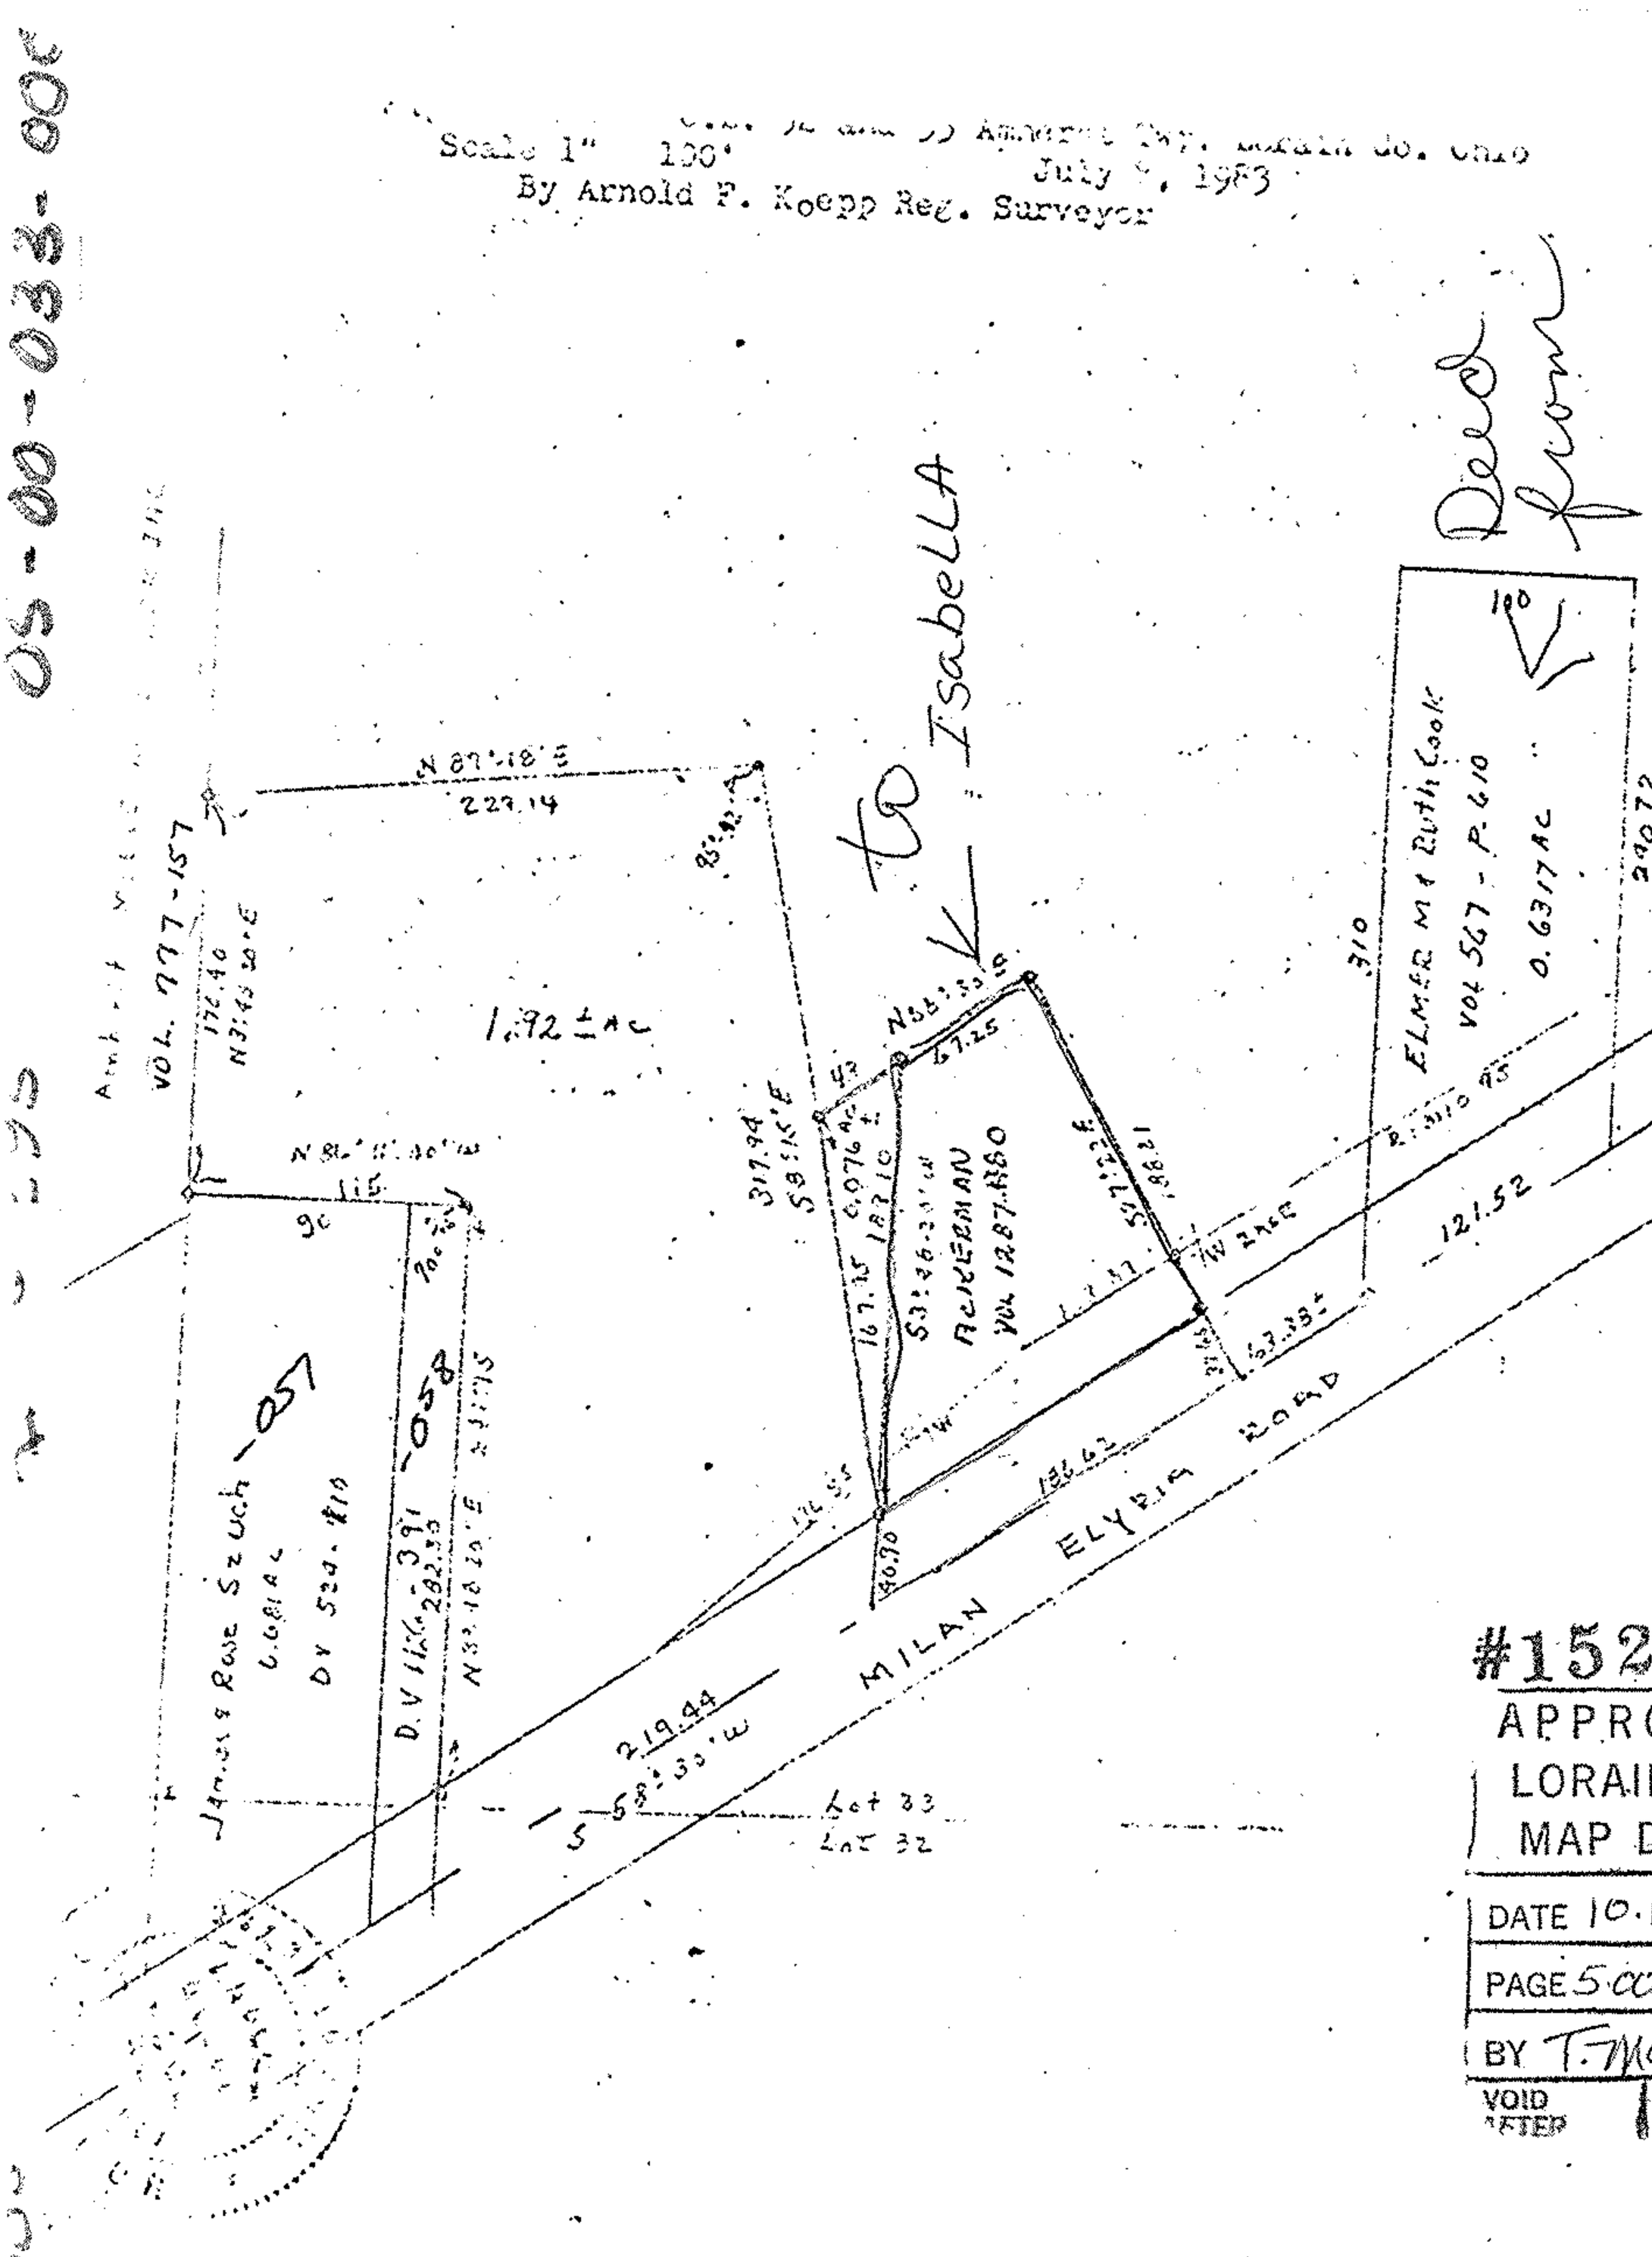

#15295
APPROVED
LORAIN CO.
MAP DEPT.
DATE 10-12-83
PAGE 5-00-033-B
BY T. McNair
VOID AFTER

05-00-033-000-049, 057, 058, 061, 008
Split 15295
Page 5-00-033-B

Split # 14683

Split # 15204 - 048 2.76 acres remain

Tax map page 05-00-033
B.