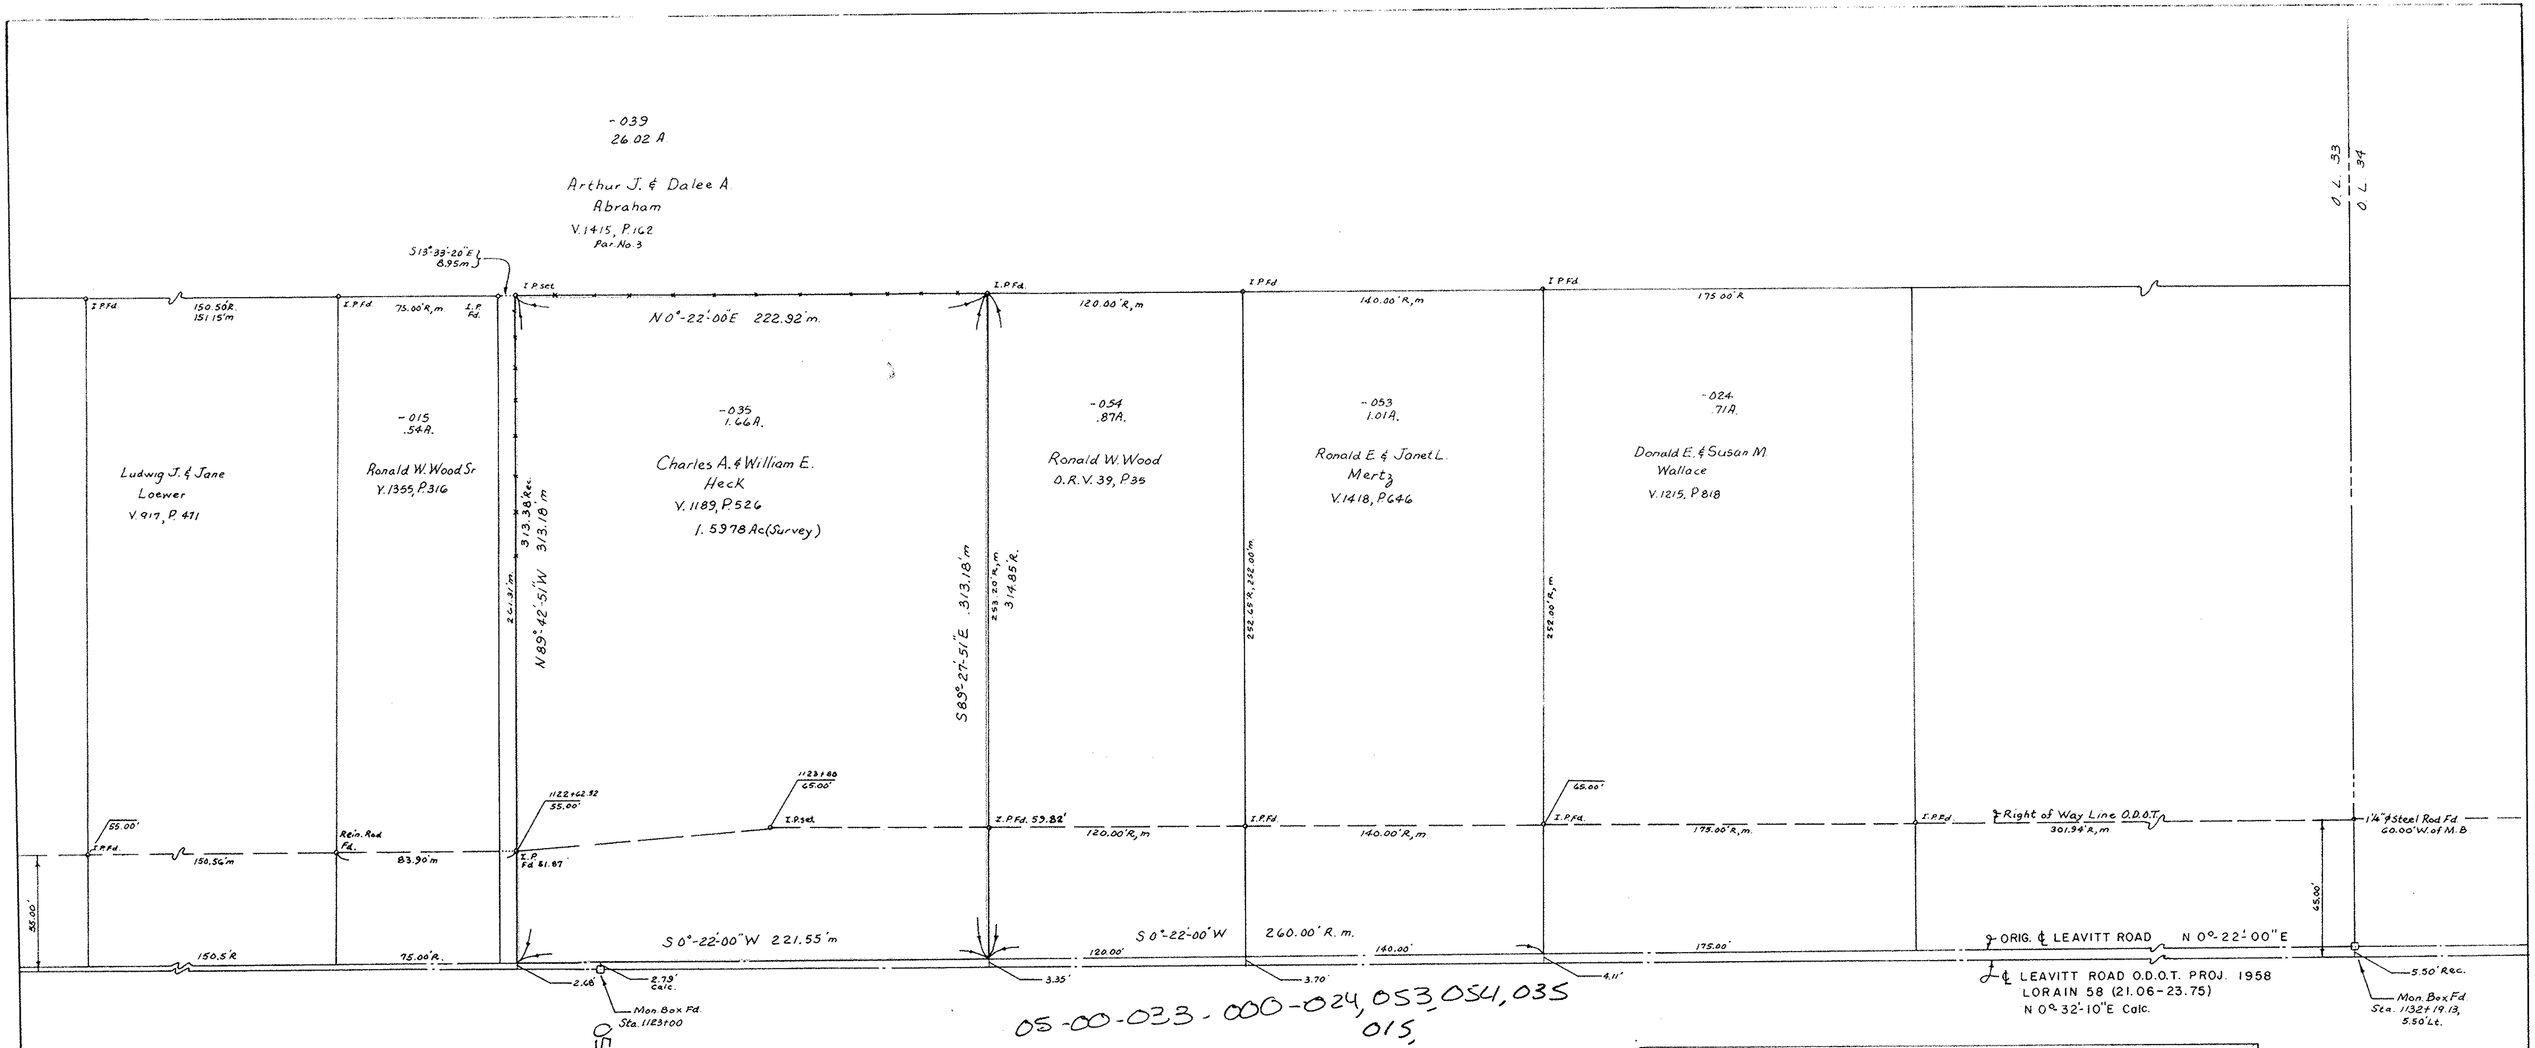

05-00-033-000-024,053,054,035
015,

05-00-033-000

LEGEND
Iron Pins Found
or Set shown thus: ⊙

APPROVED
LORAIN CO.
MAP DEPT.
DATE 8-4-88
PAGE 5-00-033.B
BY Carol Ferris
VOID AFTER #18062-A

#18062-A

NORTH
Assumed Meridian

Scale
1" = 50'

Charles P. Waryu
CHARLES P. WARYU
Registered Surveyor
No. 5029

MAP OF SURVEY OF LANDS 1.5978 ACRES

ORIG. LOT NO. 33, AMHERST TWP., LORAIN CO., OH.

Made at request of William E. Heck

By Charles P. Waryu, Reg. Surveyor No. 5029
June 27, 1988