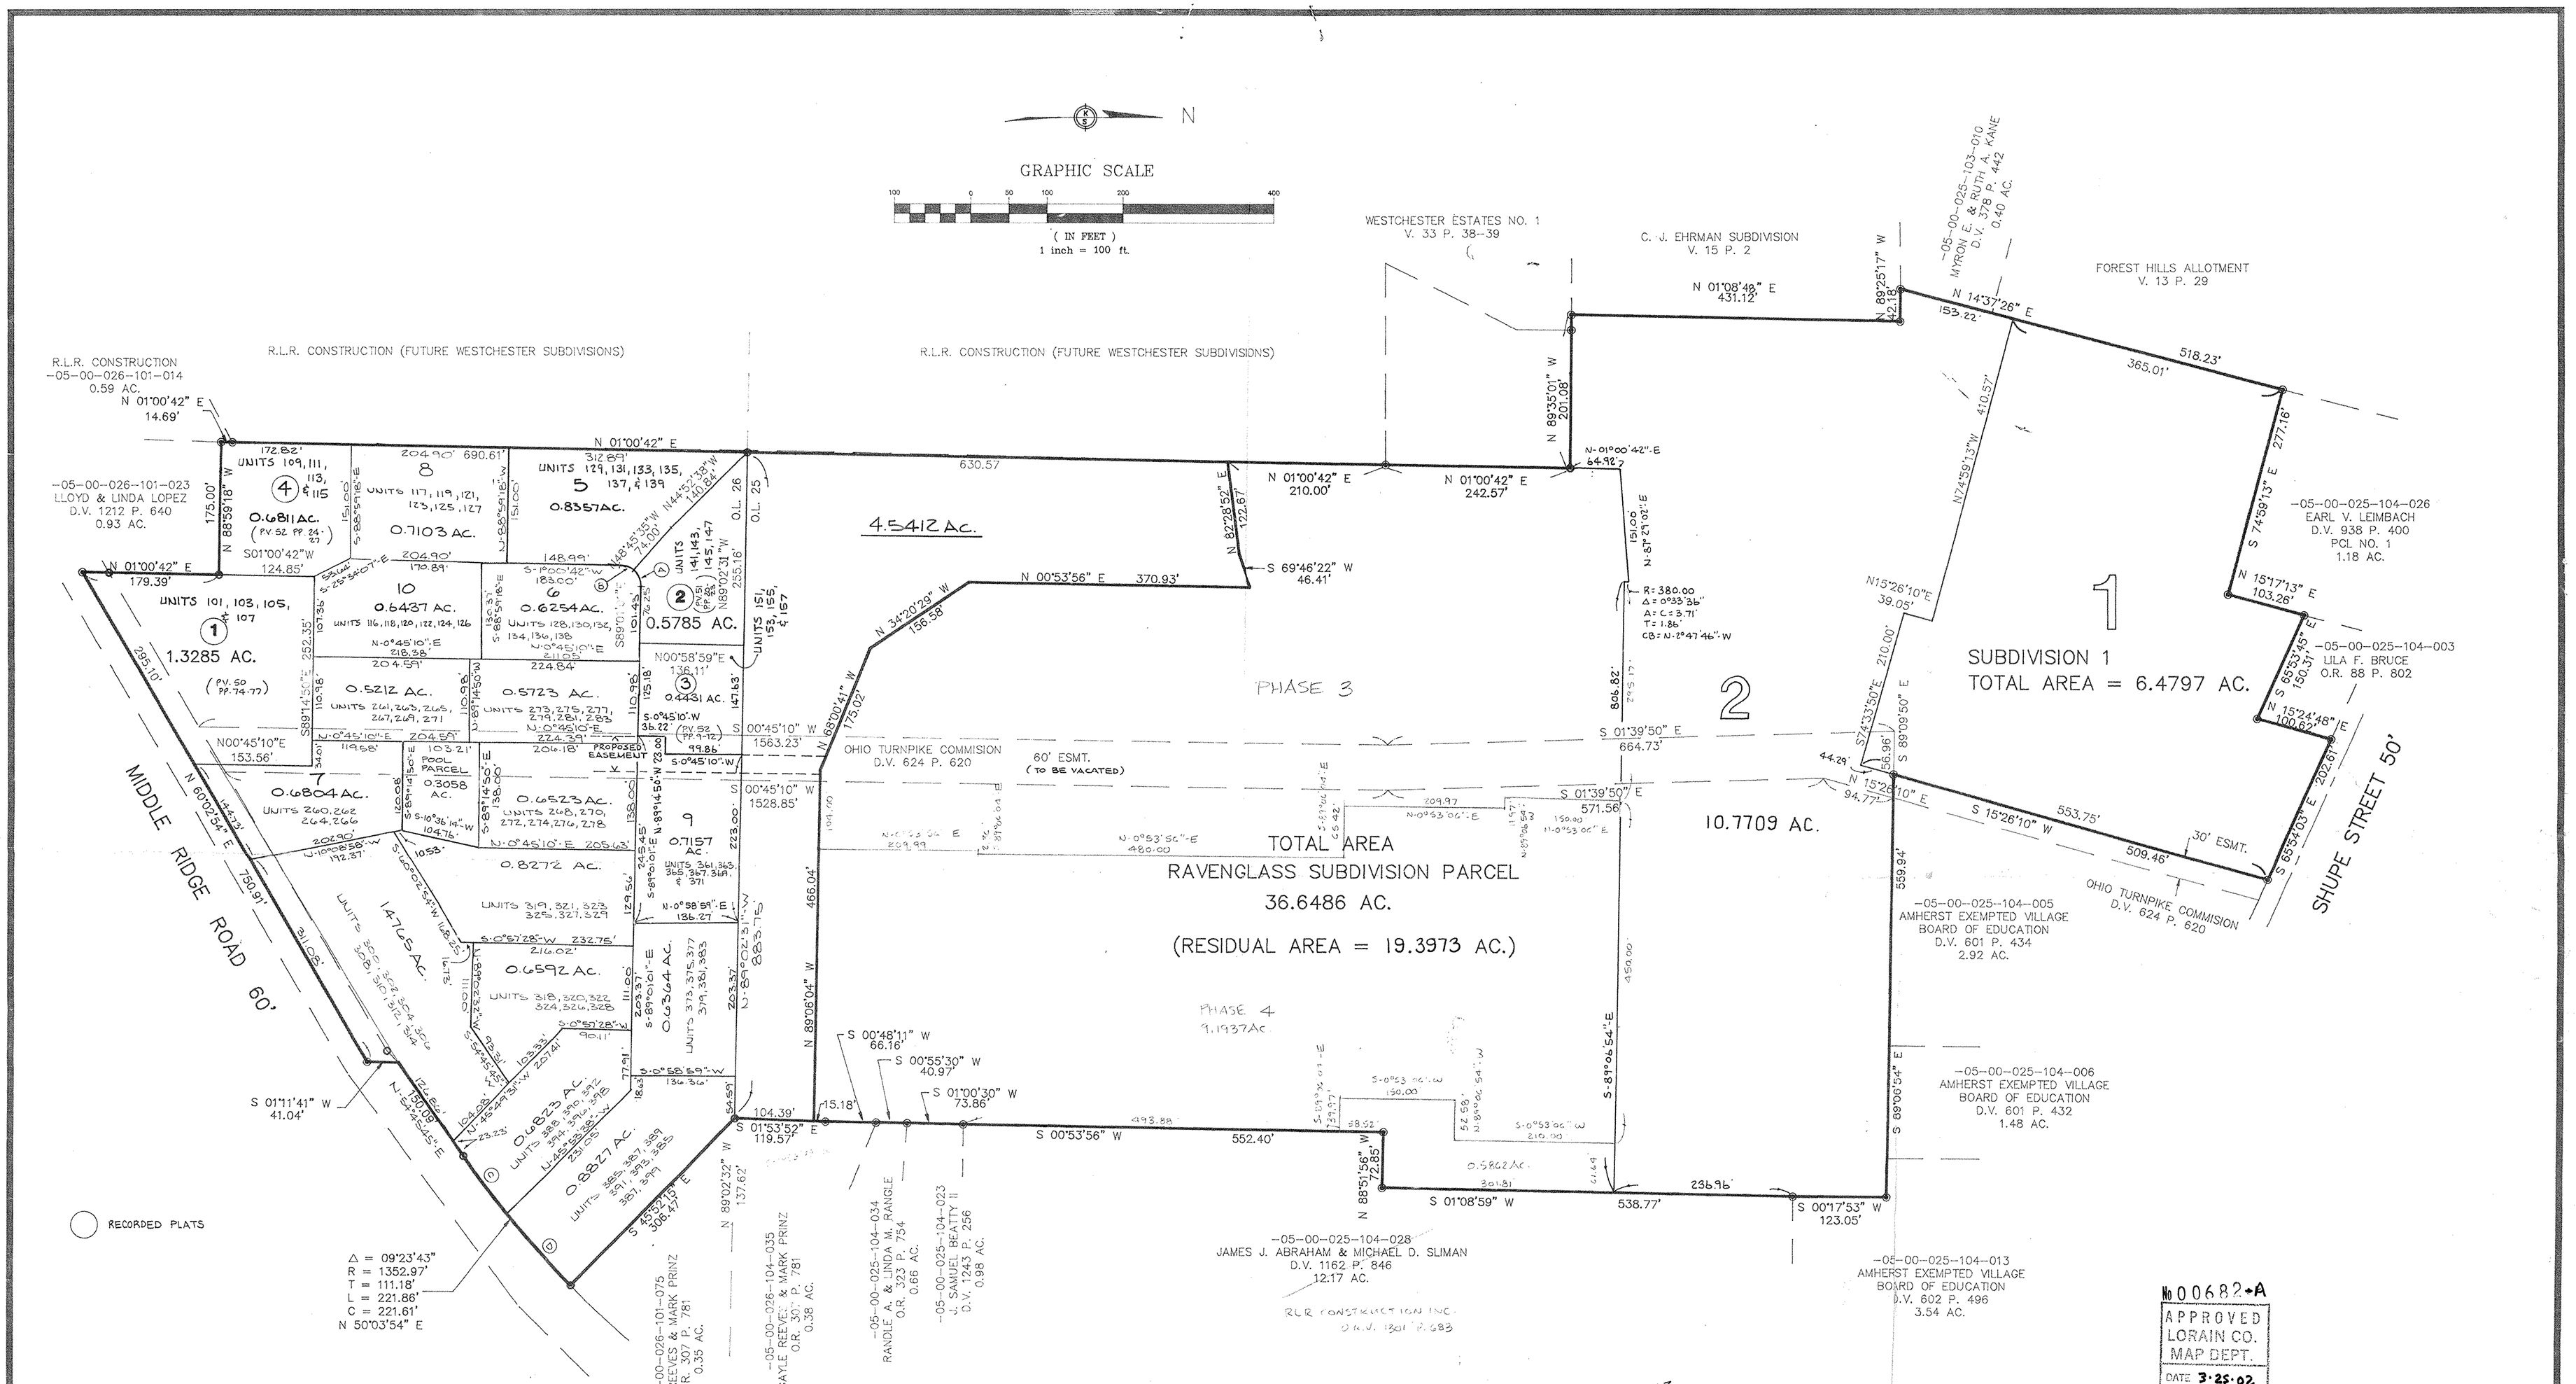

CURVE	RADIUS	DELTA	ARC	CHORD	BEARING
A	28.00'	49°44'34"	24.31'	23.55'	S 66°06'42" W
B	28.00'	40°12'43"	19.66'	19.26'	S 21°01'34" W
C	1352.97'	4°07'48"	97.53'	97.50'	N 52°41'51" E
D	1352.97'	5°15'55"	124.33'	124.29'	N 47°59'56" E

No 00682-A
APPROVED
LORAIN CO.
MAP DEPT.
DATE 3-25-02
PAGE 5-00-025-B 5-00-026-B
BY R. MAINES
VOID AFTER 02- 00682-A

DAVID L. ELWELL REG. SURV. No. 6333

STATE OF OHIO
DAVID L. ELWELL
6333
REGISTERED SURVEYOR

DATE: 4-30-93
DRAWN BY: K.V.S.
CH'D BY: D.L.E.
F.B.
DWG. NAME: \89224\DLE

REVISIONS

1-26-2000	COMMUNITY BLDG. PCL. REV. 0.3058 AC.
7-13-94	ADDED 0.5212 AC., 0.5723 AC., 0.6523 AC., 0.4423 AC.
3-03-94	PARCELS 9 & 10 ENG LAKES
10-26-93	4.5412 ACRE (NO. ENG. LAKES AREA)
10-15-93	PHASE 8 ENG LAKES CONDO
10-4-93	PHASE 6 & 7 ENG. LAKES CONDO
8-19-93	PHASE 5 ENG. LAKES CONDO
7-13-93	PHASE 4 ENG. LAKES CONDO
5-3-93	PHASE 3 ENG. LAKES CONDO.

SURVEY & PARCEL MAP
ENGLISH LAKES / RAVENGLASS SUBDIVISIONS

R.L.R. CONSTRUCTION, INC.

PART OF AMHERST TWP. O.L. 25 & 26
CITY OF AMHERST•COUNTY OF LORAIN•STATE OF OHIO

KS ASSOCIATES, INC.
ENGINEERS/SURVEYORS
424 Middle Avenue
P.O. Box 89
Elyria, Ohio 44036
ELYRIA (216) 322-6317 * LORAIN (216) 244-5757
ENGINEERS/SURVEYORS
KS ASSOCIATES INCORPORATED

SHEET 1 OF 1
JOB NO. 89224PCL