5-00-024 A

5-00-024 A

05-00-024-102

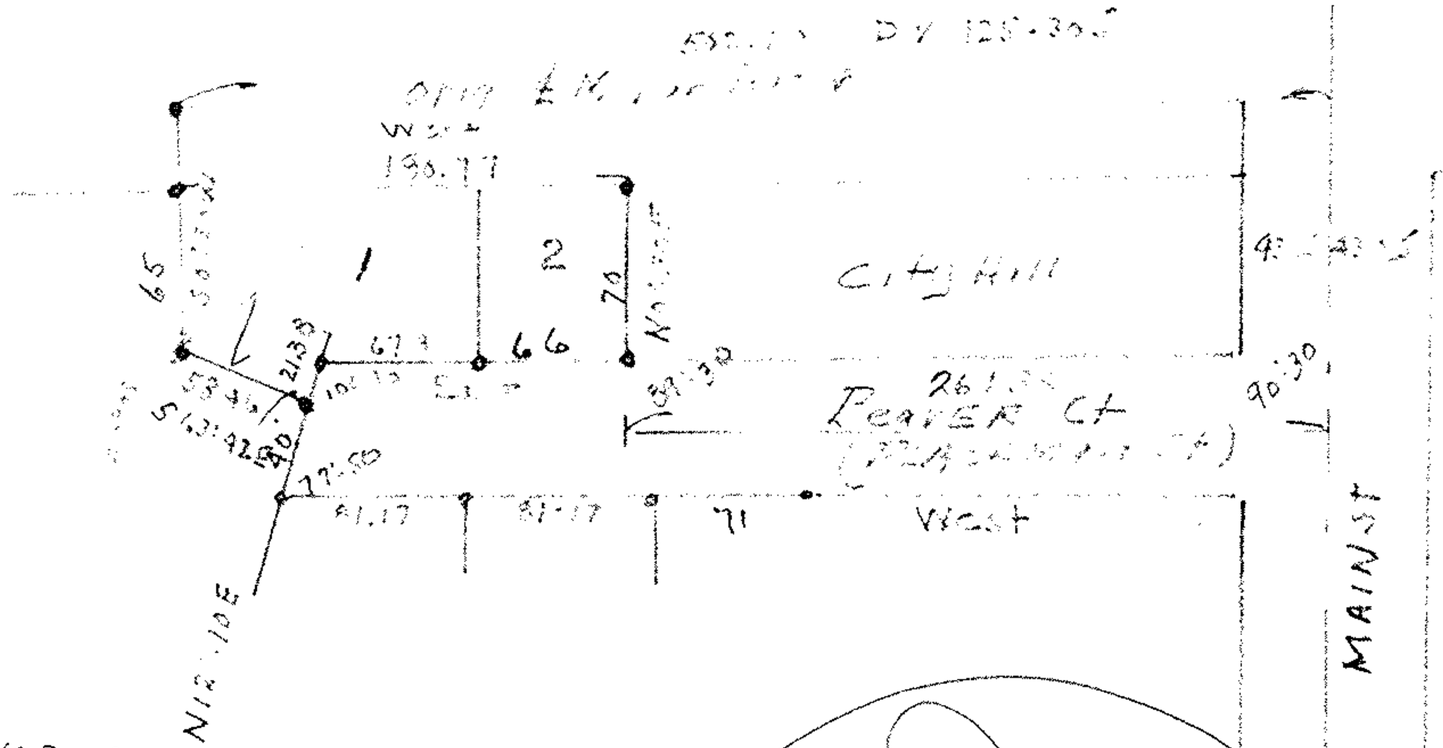

Survey of Part of Lot 1 and all Lot 2
Original Town Plat of Amherstville
Scale 1" 100' June 21, 1969

By Arnold F. Koepp Registered Surveyor

05-00-024-102-001,002

5-00-024-A

5-00-024