


5-00-023-B

05-00-023-105

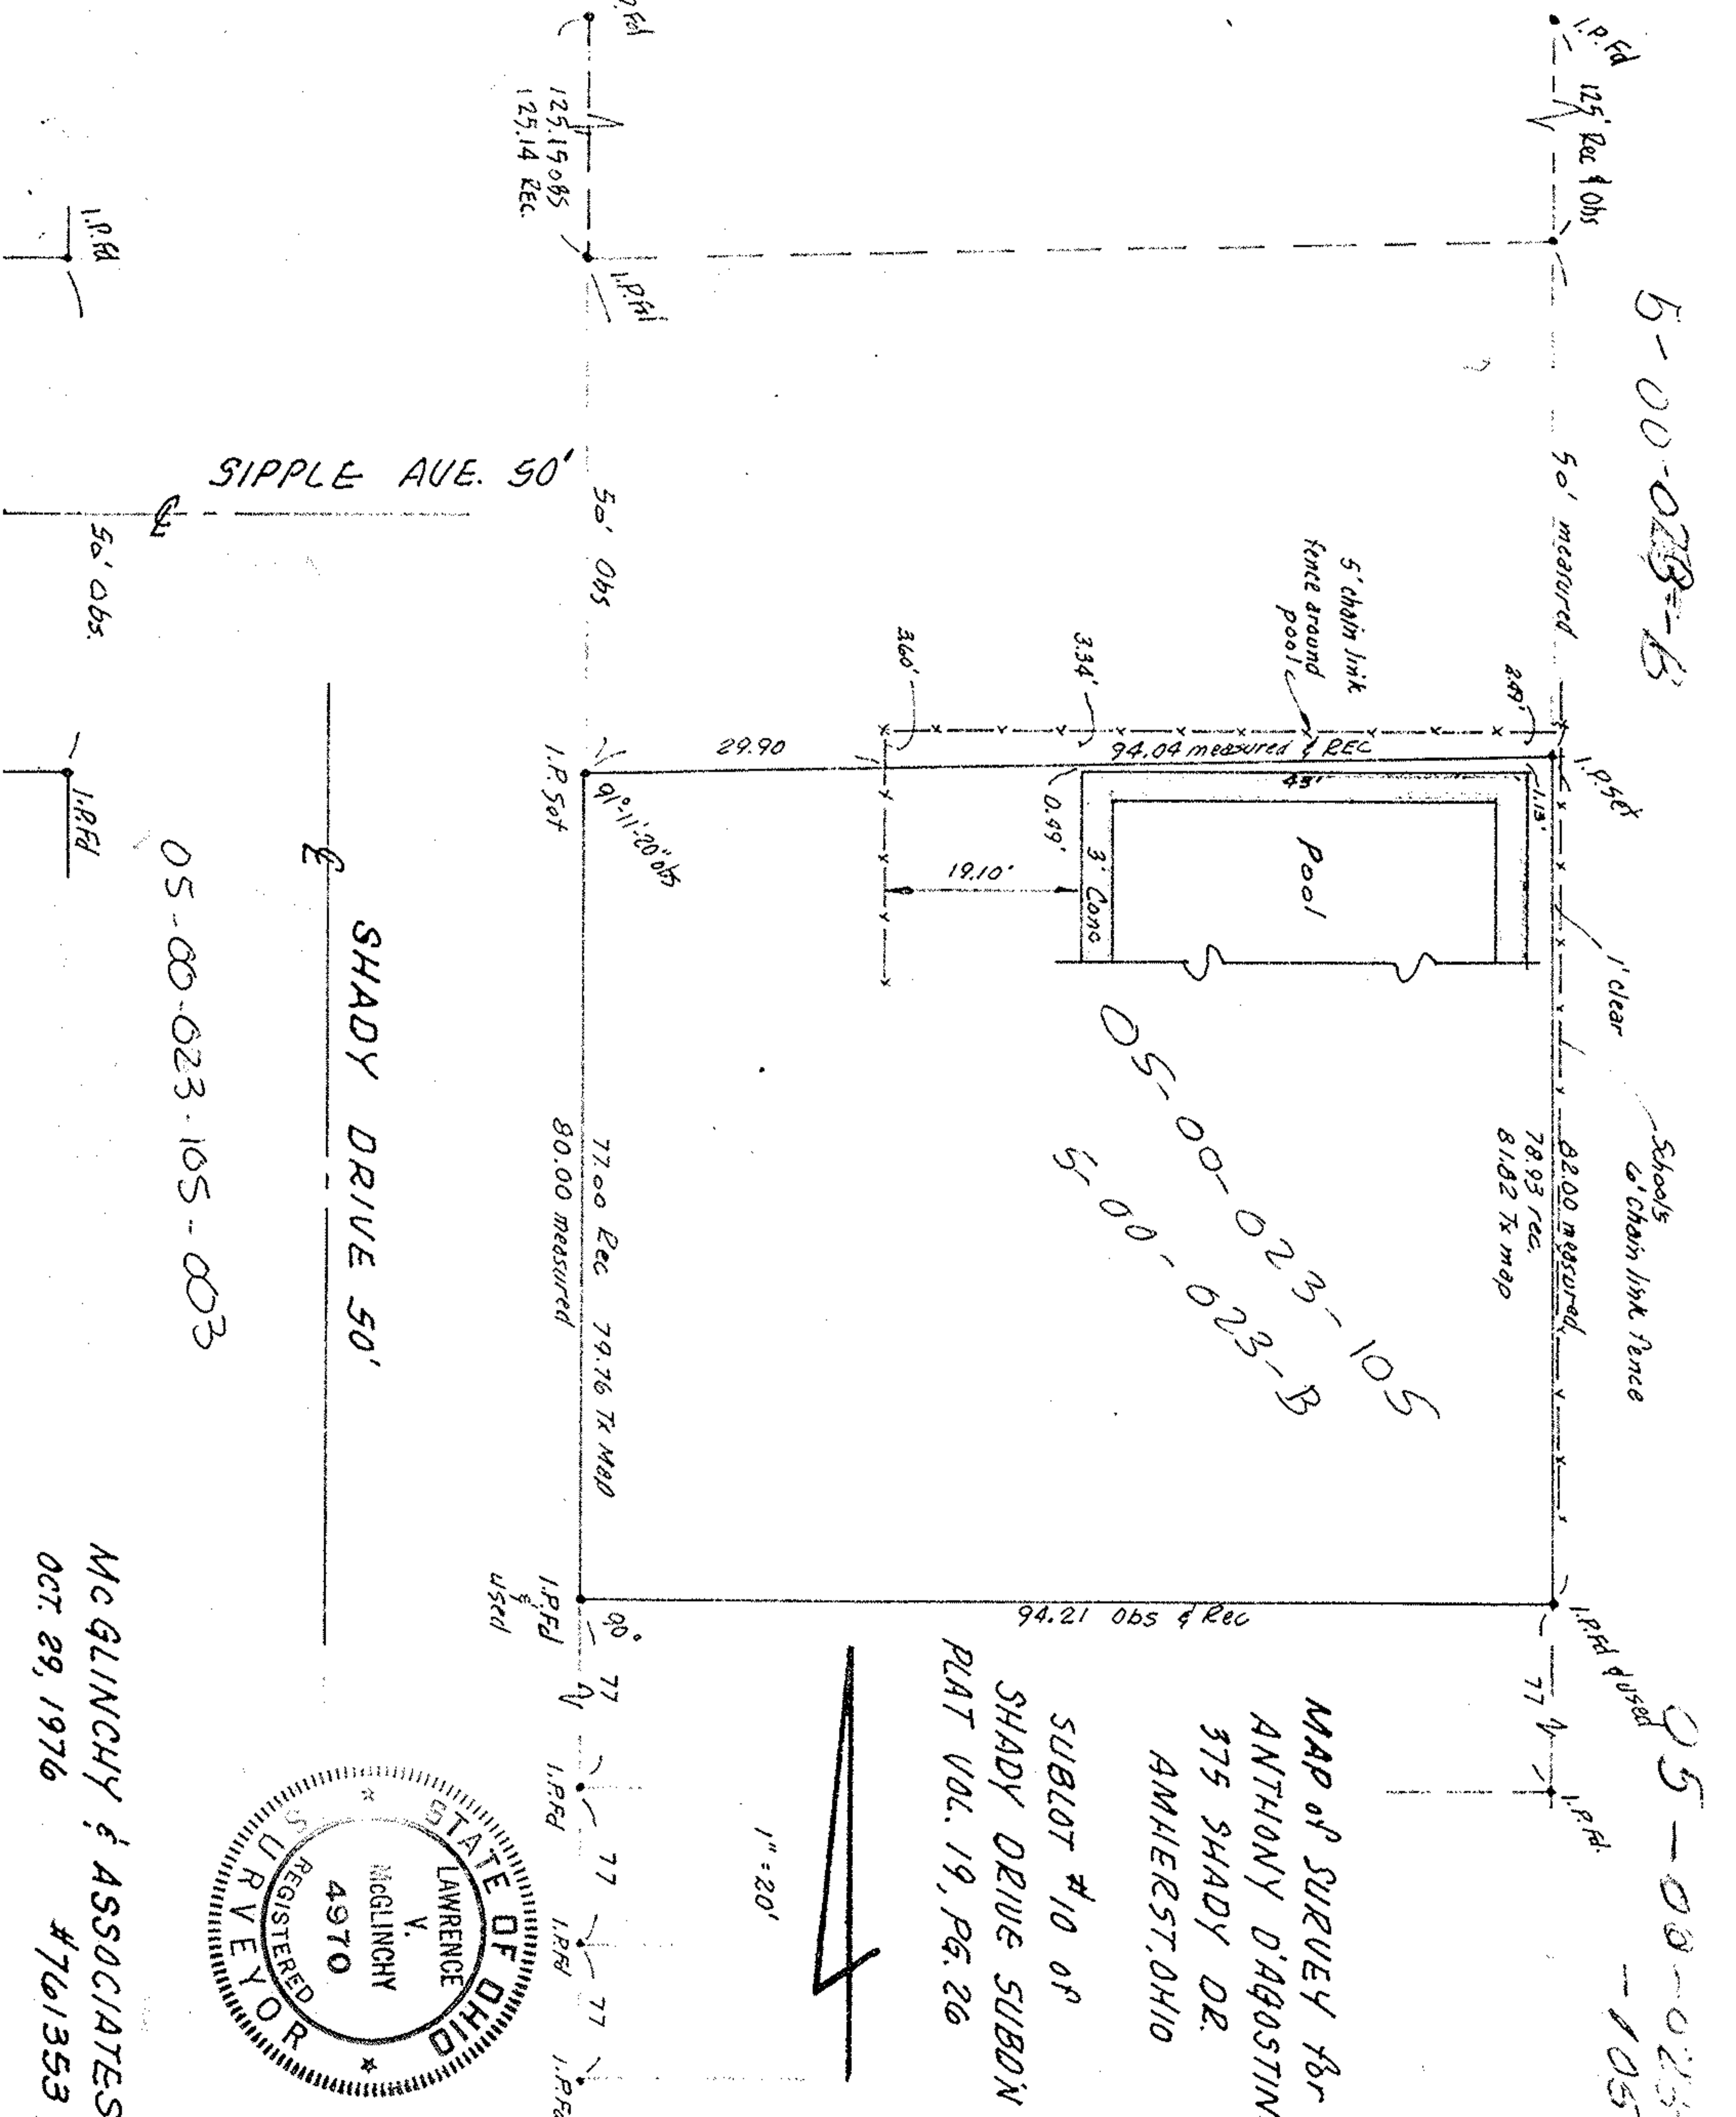


SIPPLE AVE. 50'

SHADY DRIVE 50'

05-00-023-105-003

MAP OF SURVEY FOR
 ANTHONY DIAGOSTIN
 375 SHADY DR.
 AMHERST, OHIO
 SUBLOT #10 OF
 SHADY DRIVE SUBDIV
 PLAT VOL. 19, PG. 26

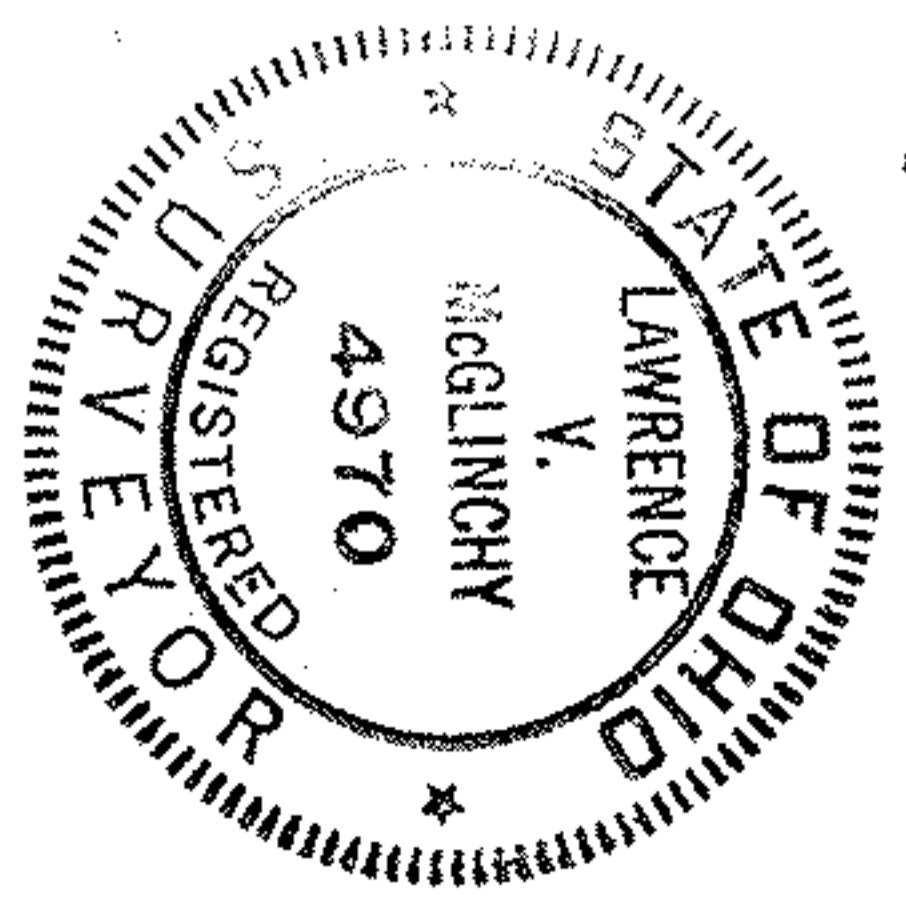

MCGLINCHY & ASSOCIATES
 OCT. 29, 1976
 #761353