05-00-042-104

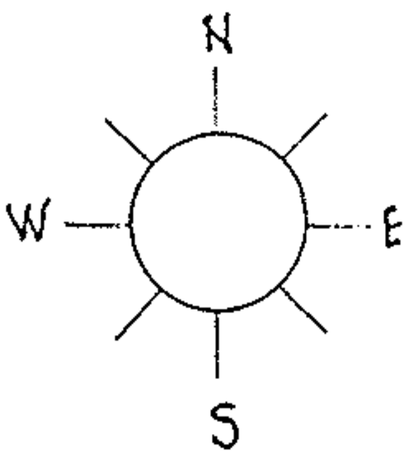

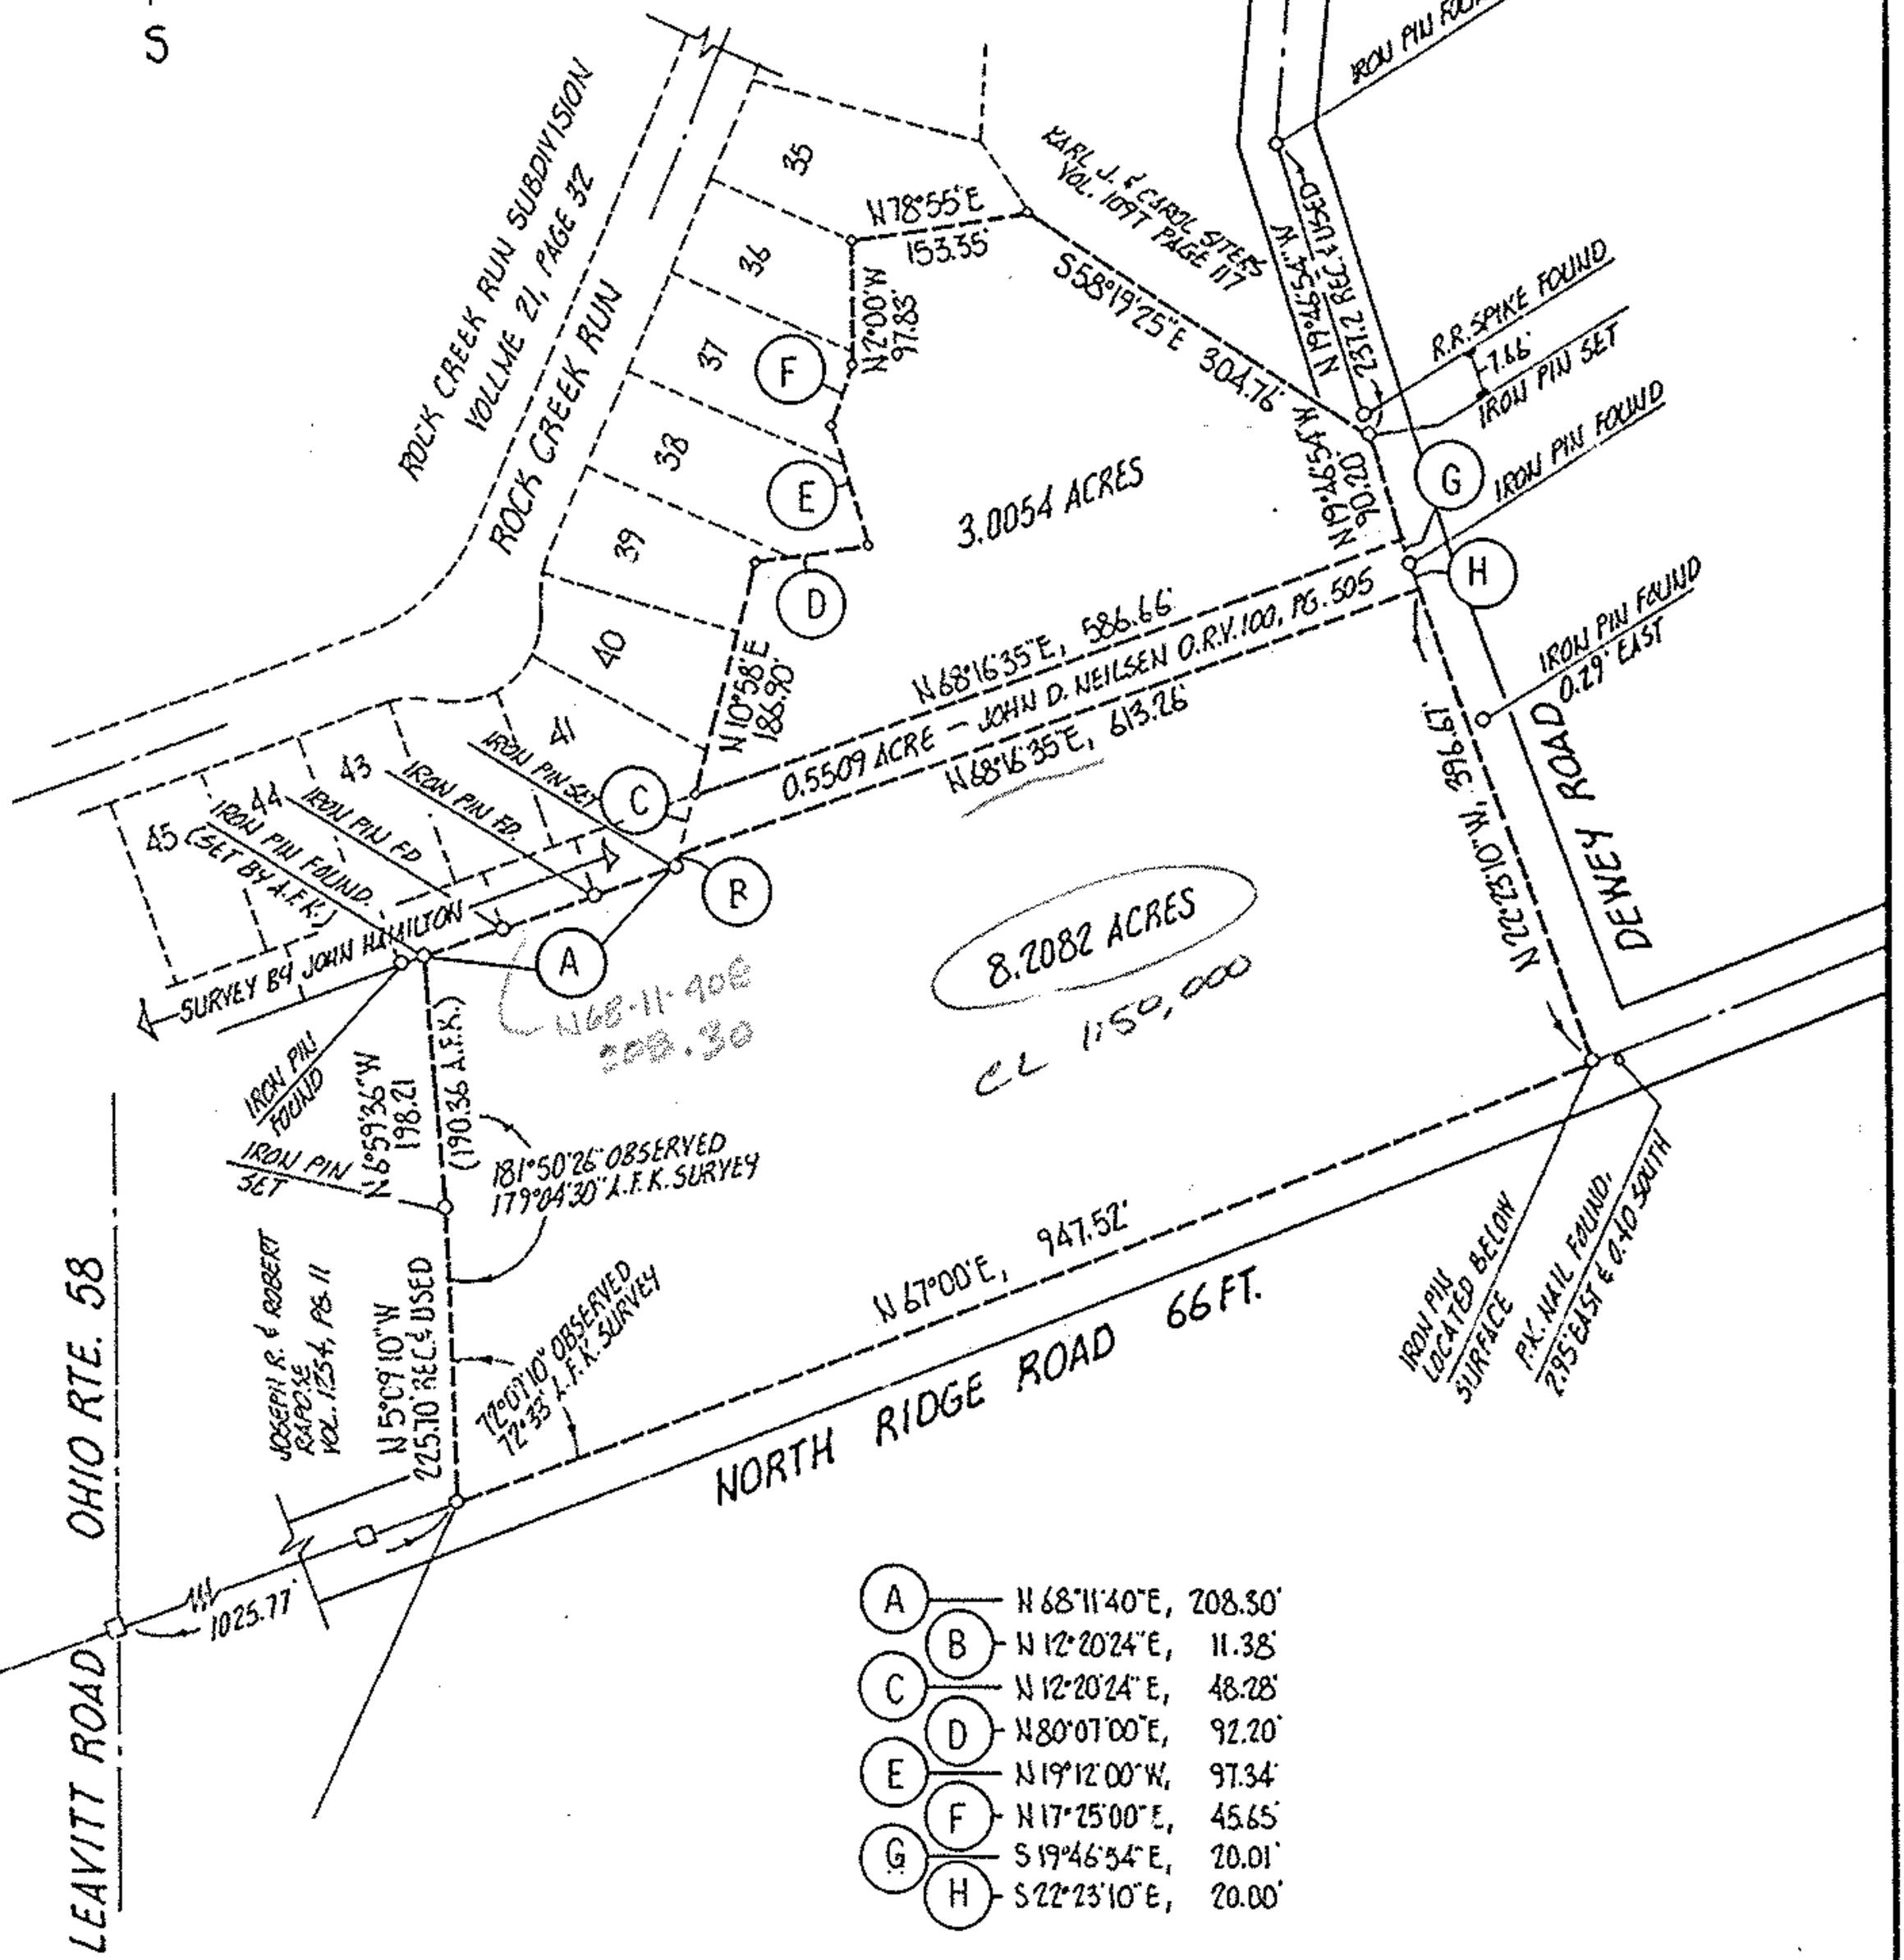

A	N 68°11'40"E,	208.30'
B	N 12°20'24"E,	11.38'
C	N 12°20'24"E,	48.28'
D	N 80°07'00"E,	92.20'
E	N 19°12'00"W,	97.34'
F	N 17°25'00"E,	45.65'
G	S 19°46'54"E,	20.01'
H	S 22°23'10"E,	20.00'

05-00-042-104-087
-096
088

ACREAGE 11.2136
DATE APR-91 REVISED JUL-91
DRAWN MGH
SCALE 1" = NONE ft.

STATE OF OHIO
MICHAEL G. HURA
No. 4712
REGISTERED SURVEYOR

PREPARED FOR ATTY MARTIN COURY & MARILYN JENNE

MICHAEL G. HURA registered surveyor
12706 MASON ROAD, VERMILION, OHIO [216] 965-4040

PERIMETER SURVEY

SUBLOT _____ OF _____
_____ Volume ____ Page ____ of PLATS
PART OF O.L. 42 TRACT ____ SECTION _____ OF
AMHERST TOWNSHIP LORAIN CO., OHIO
Perm. Parcel No _____ Ref. deed:

CITY OF AMHERST, OHIO

05-00-042 A