H. F. & SADIE MISCHKA
3-15-45 D.V. 351 Pg. 94

#8657

ROBERT C. & B. E. MASOWICH
11-19-68 D.V. 975 Pg. 730

DEC 31 1975

AUTO PALLETS BOXES INC.
Aug. 4, 1967 D.V. 949 Pg. 570
35.0505 AC.

APR 2 1975

AUTO PALLETS BOXES INC.
2-25-69 D.V. 980 Pg. 506
12.4075 AC.

05-00-044

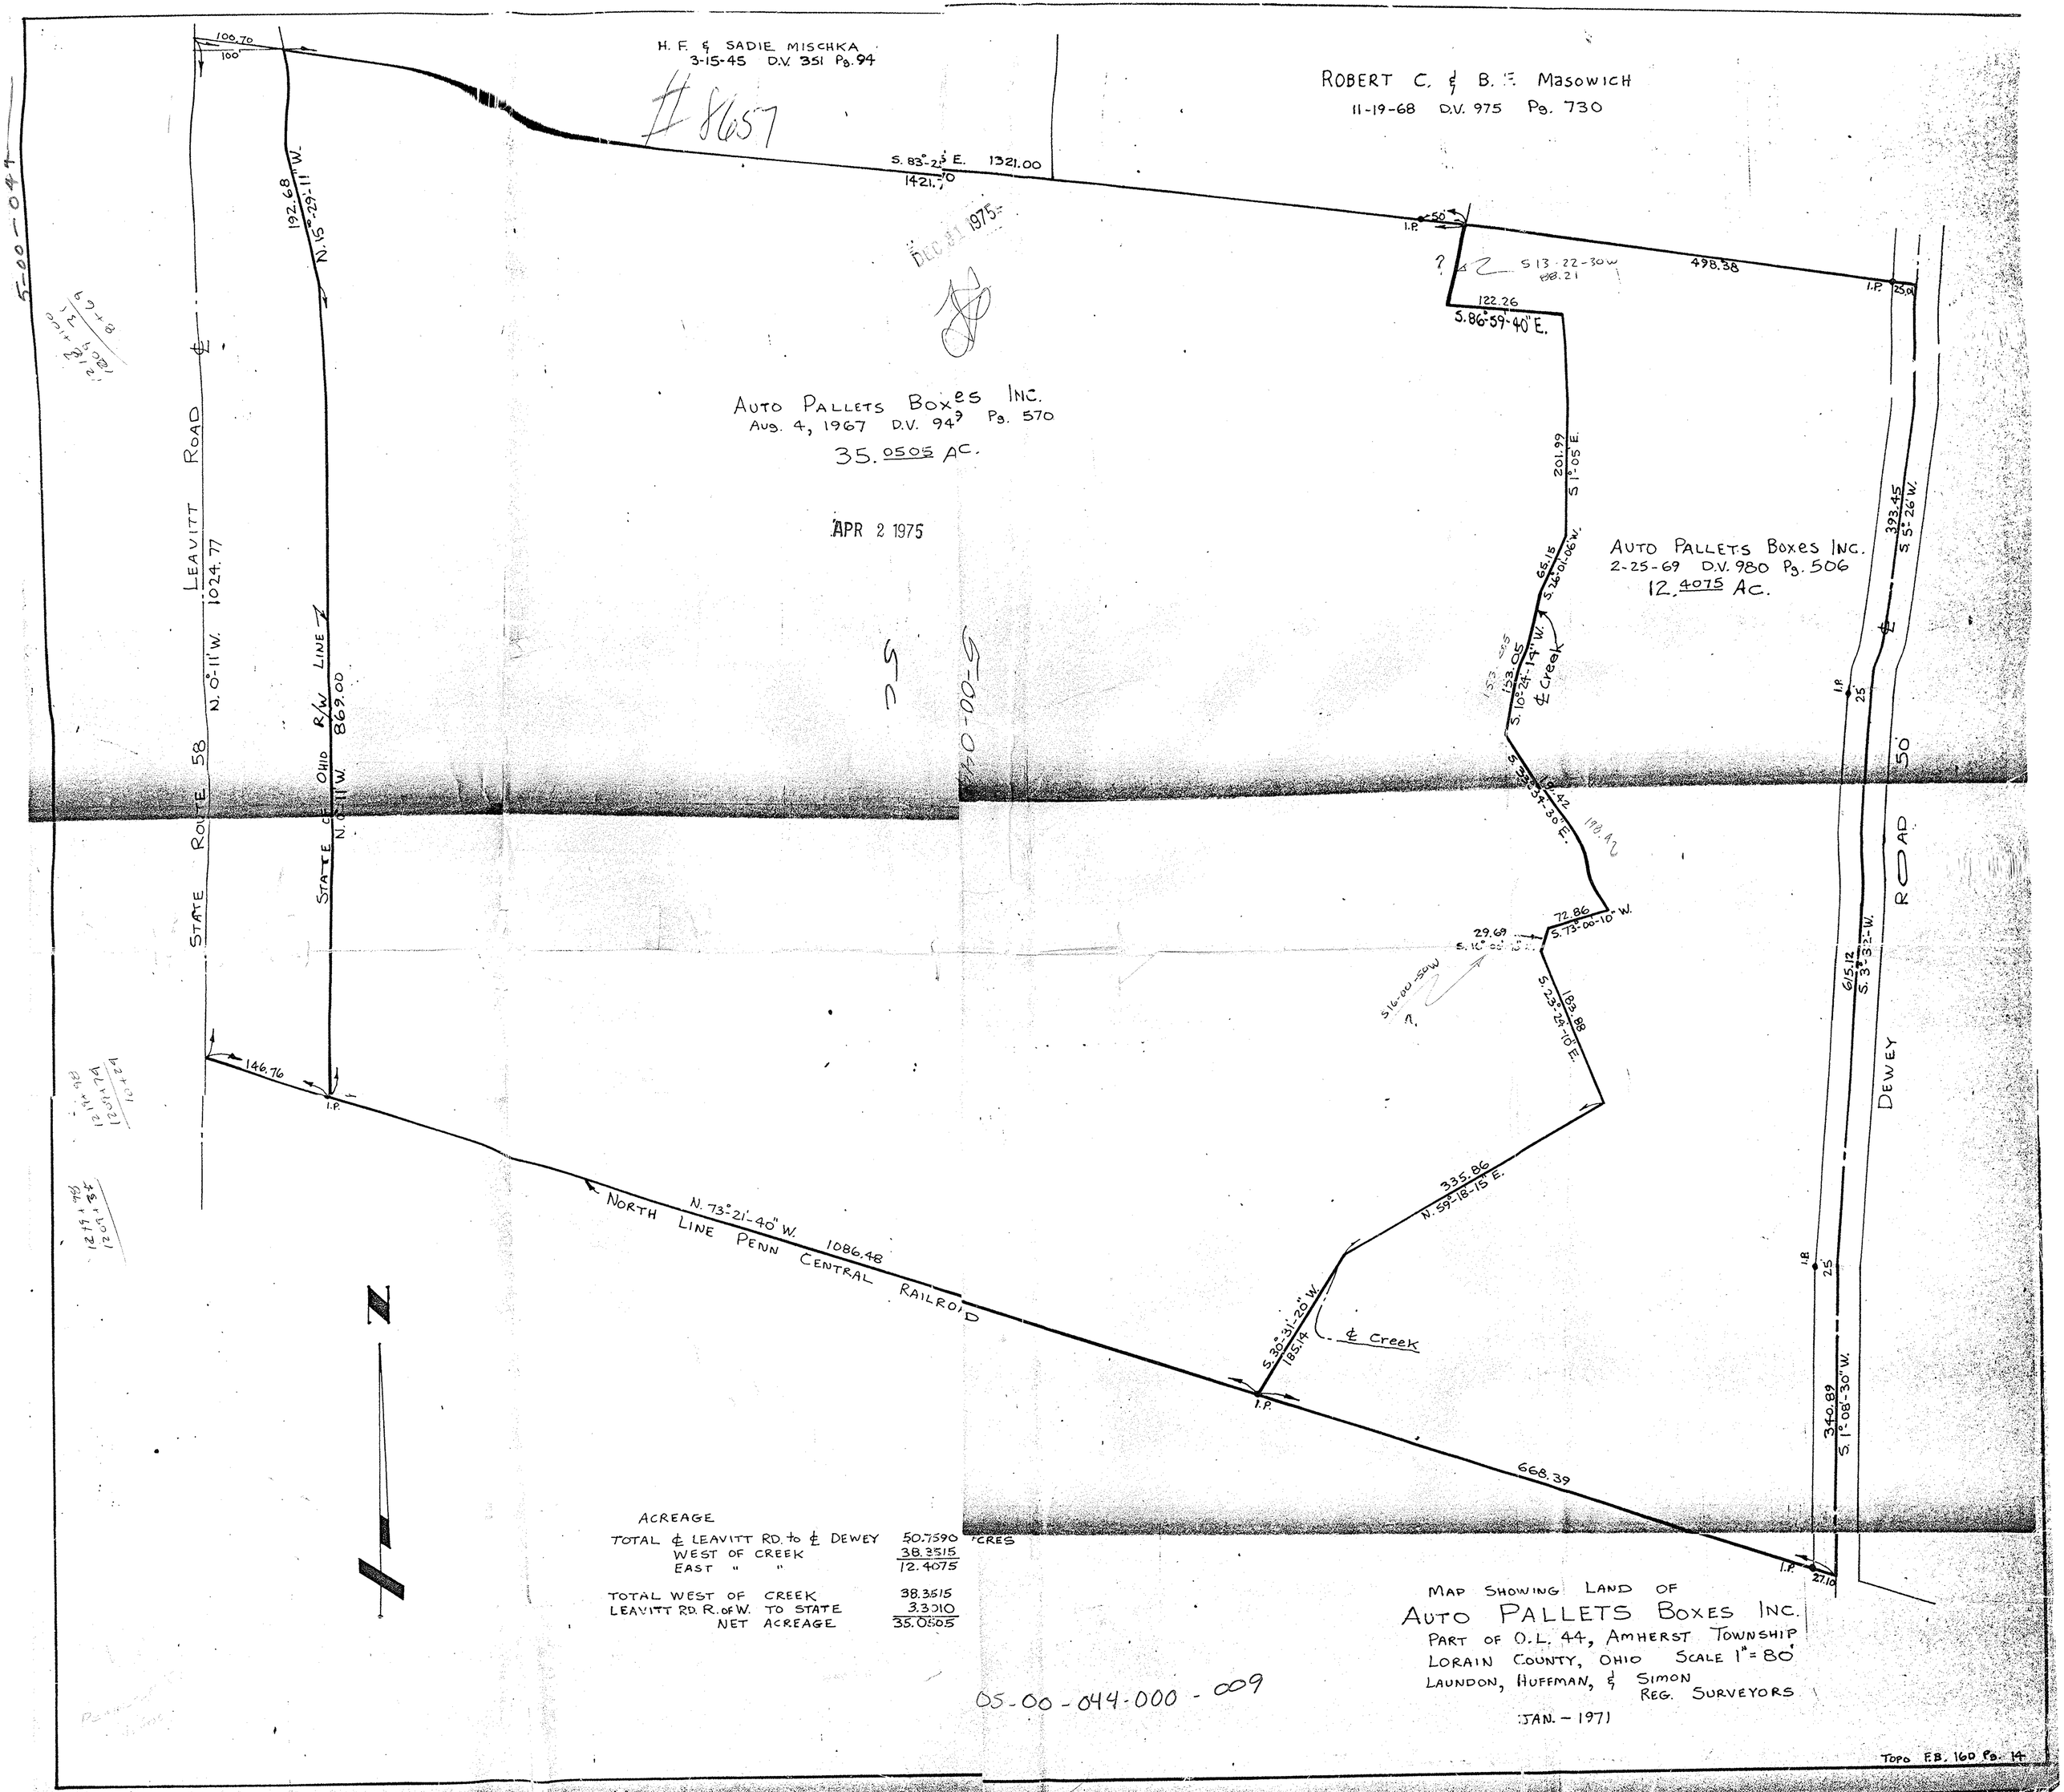

ACREAGE

TOTAL ℄ LEAVITT RD. to ℄ DEWEY	50.7590 ACRES
WEST OF CREEK	38.3515
EAST " "	12.4075
TOTAL WEST OF CREEK	38.3515
LEAVITT RD. R. of W. TO STATE	3.3010
NET ACREAGE	35.0505

05-00-044-000-009

MAP SHOWING LAND OF
AUTO PALLETS BOXES INC.
PART OF O.L. 44, AMHERST TOWNSHIP
LORAIN COUNTY, OHIO SCALE 1" = 80'
LAUNDON, HUFFMAN, & SIMON
REG. SURVEYORS
JAN. - 1971

TOPO F.B. 160 Pg. 14