LAUNDON • SIMON • CAHL & ASSOC. INC.
CONSULTING ENGINEERS & SURVEYORS
ELYRIA, OHIO 44035

SURVEY FOR
RUBY ROBART

Orig. Lot 45	City of	Date FEB. '85 Scale 1" = 100'
Orig. Sec	Village of	Dwn. by R.G.S. Chkd. by J.C.
Tract	County of LORAIN	Job No. 85-1346 F.B. 98 P.41
Township of AMHERST	State of OHIO	Printed

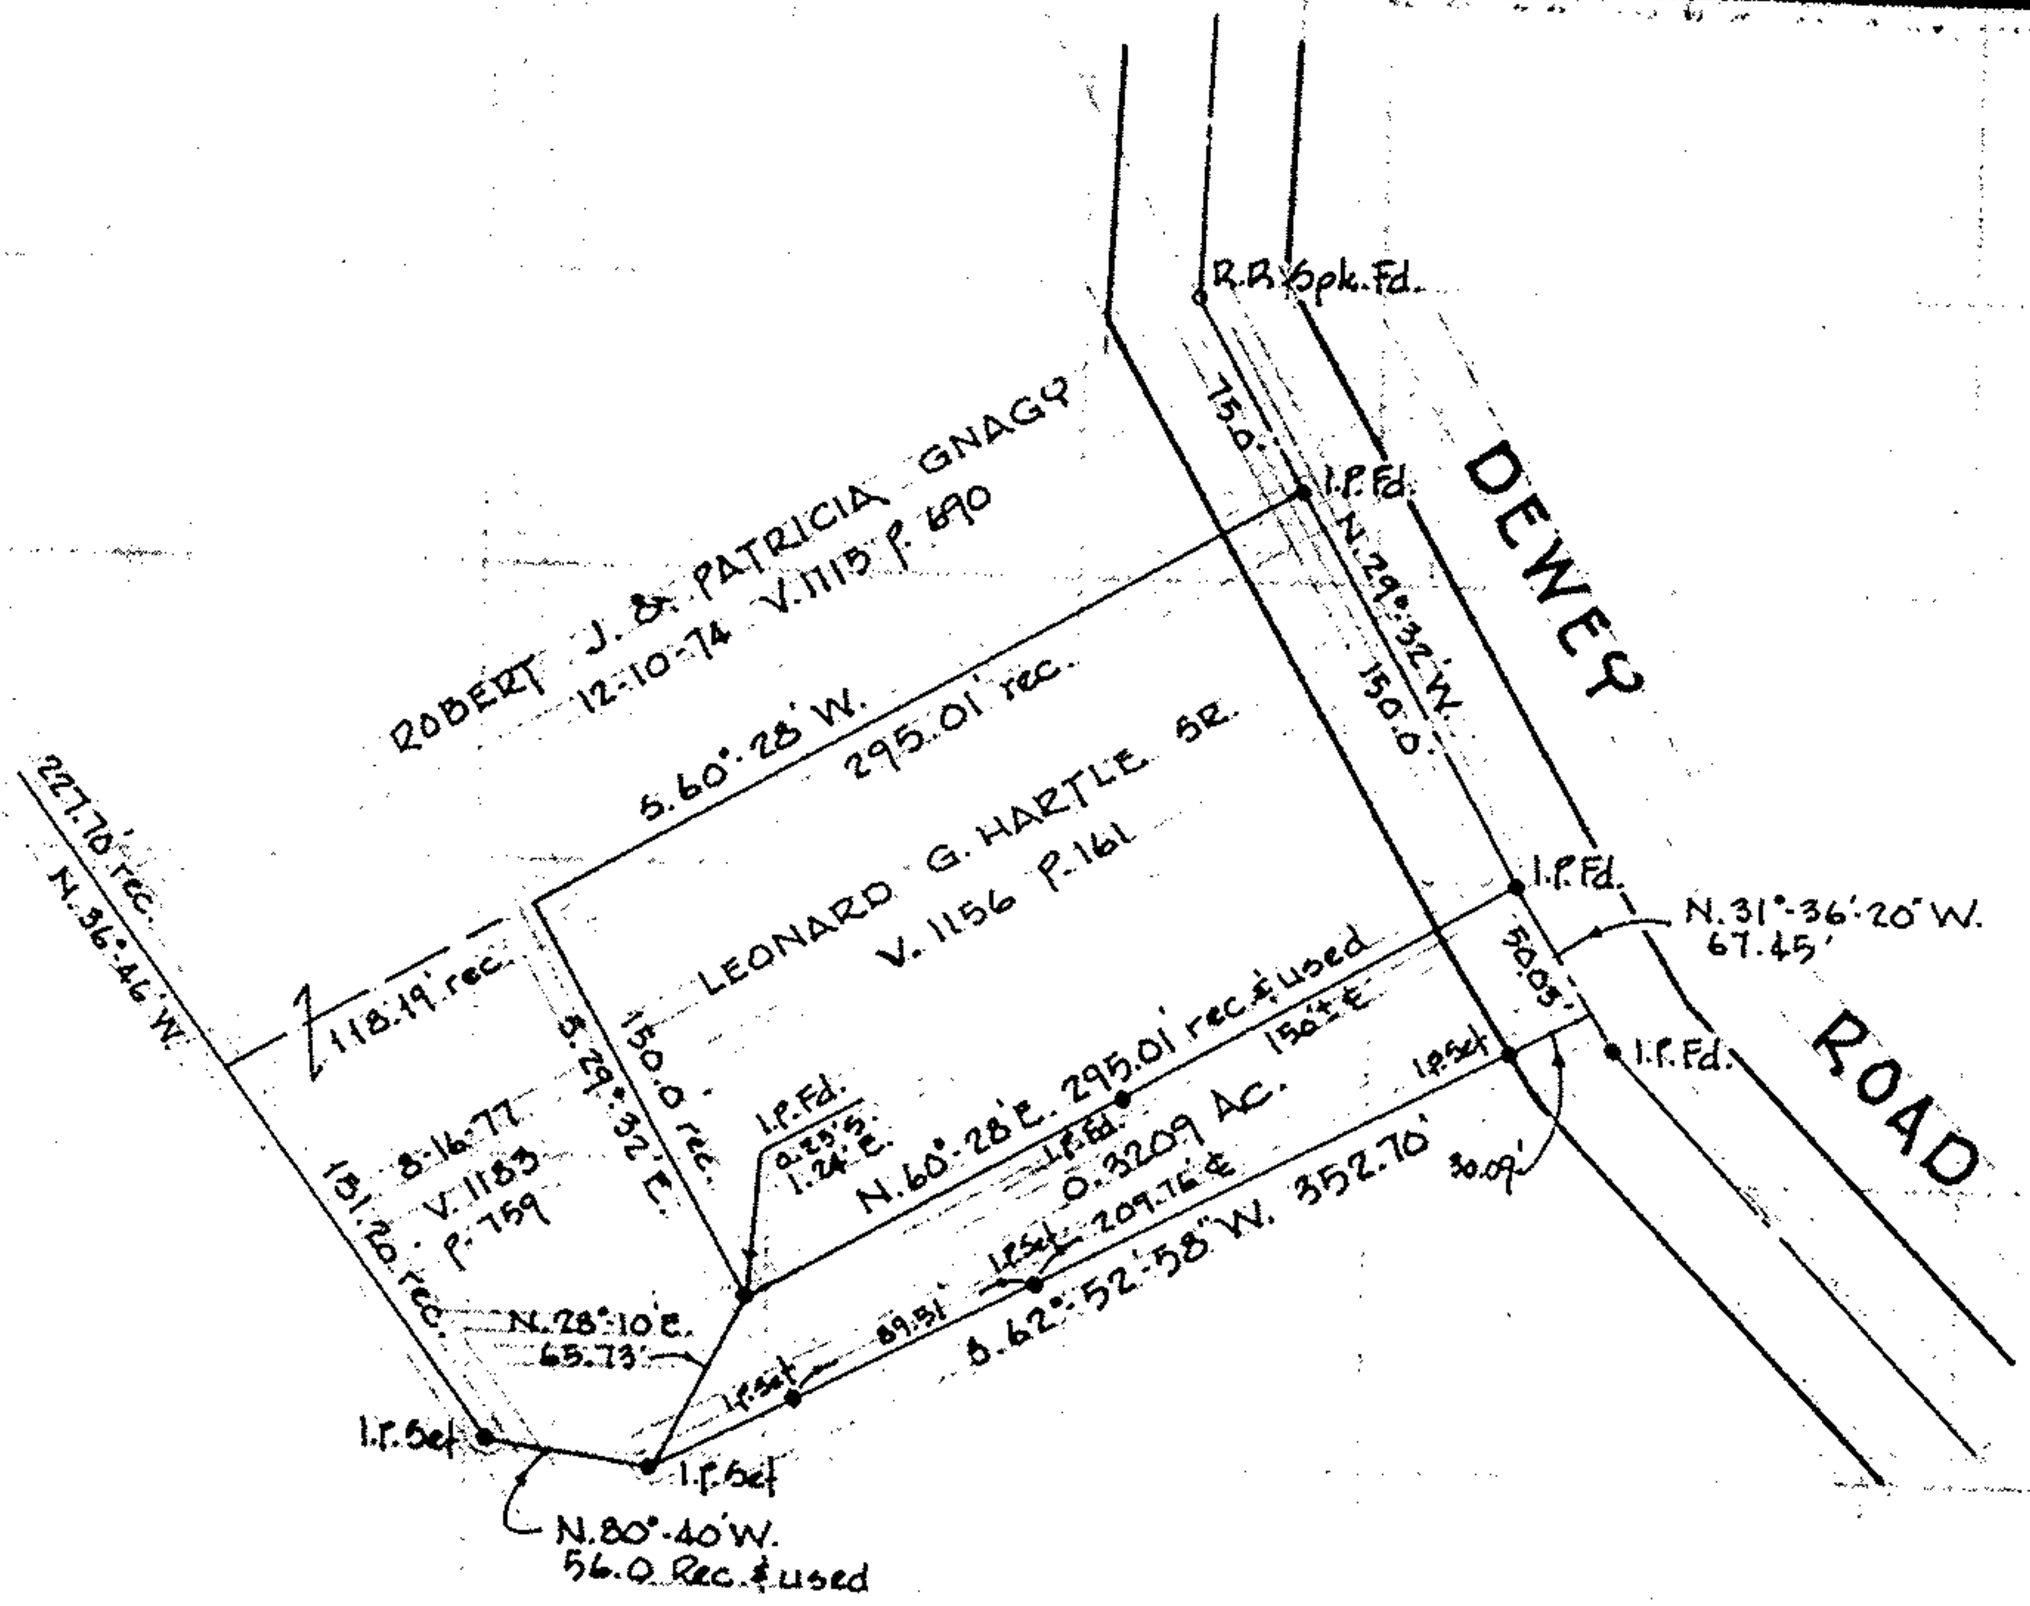

WM. W. & AGATHA DONGES
V.432 P.15

05-00-045-000-074, 061, 014