P.P. NO. 05-00-044-000-070,075,076	
SPLIT # 03-00797-U	DATE SURVEYED Jan. 2003
MAP PAGE 05-00-044-A & B	
SURVEYOR Phillip A. Rosebeck	

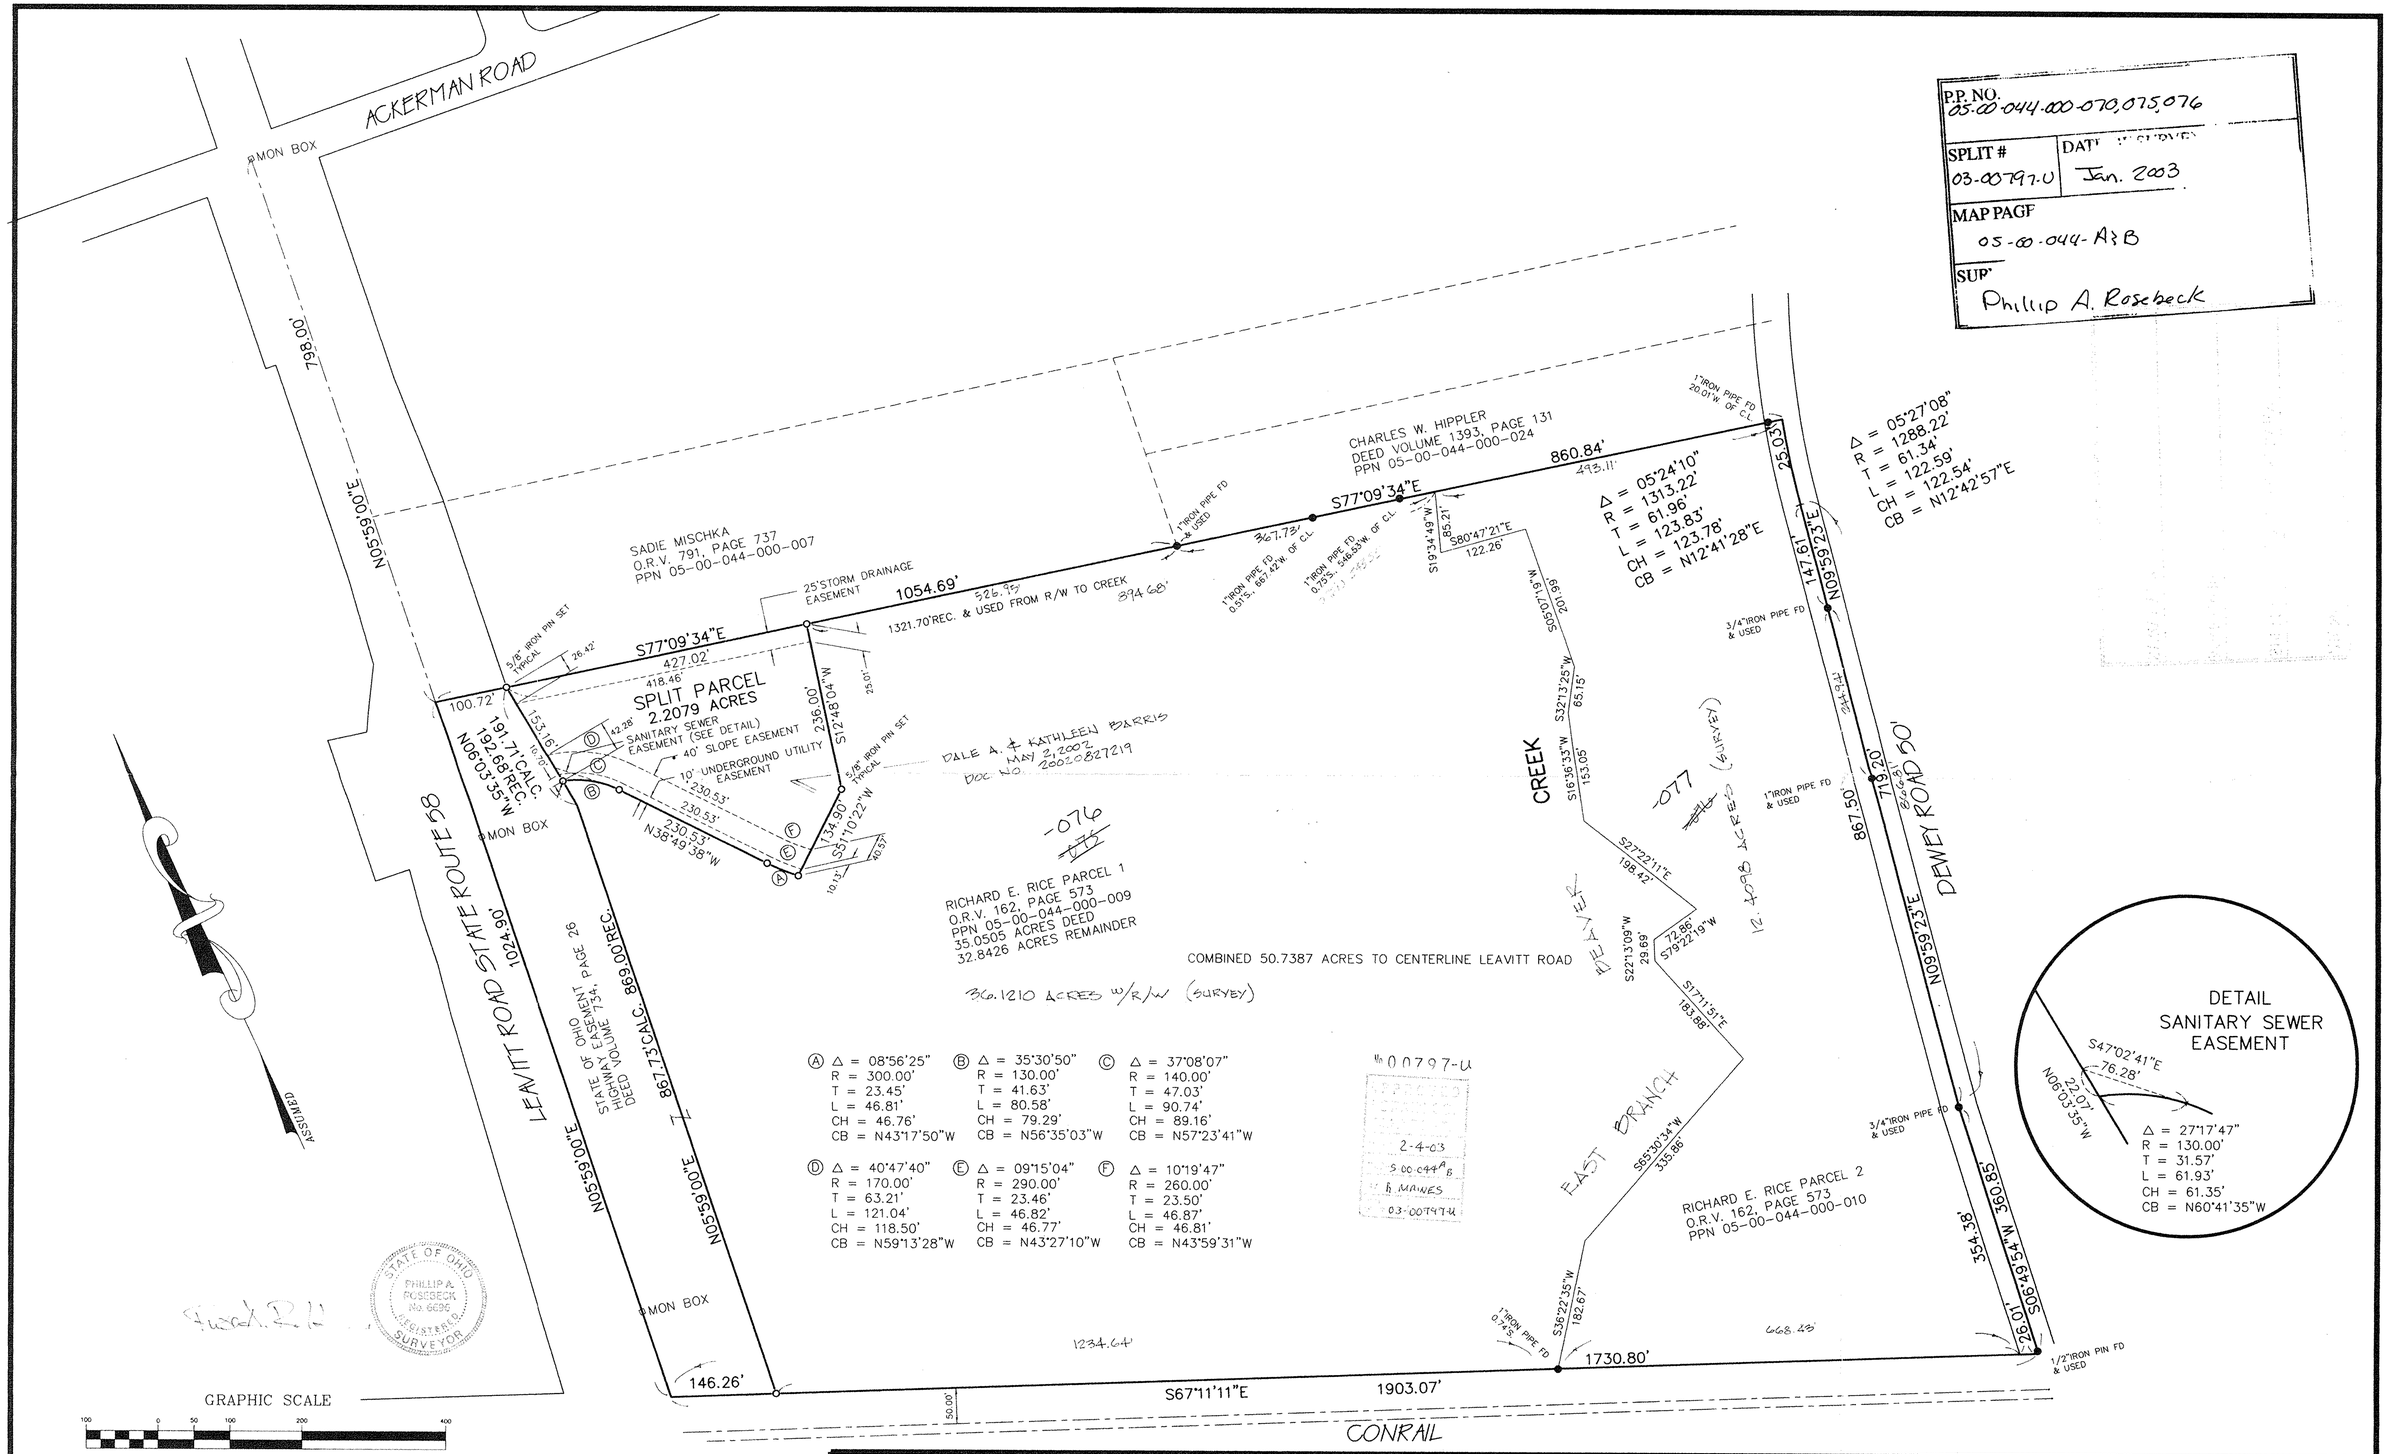

SURVEY MAP

RICHARD E. RICE

PART OF ORIGINAL AMHERST TOWNSHIP LOT NUMBER 44,
CITY OF AMHERST, COUNTY OF LORAIN, STATE OF OHIO

NOVEMBER 26, 2001

NO.	DATE	REVISION	BY
2	1-21-03	DIM. & ACREAGE - UNCONFIRM	PAR
1	6/22/02	ADDED COMBINED ACREAGE	PAR
	11/26/01	ORIGINAL ISSUE	PAR

P. A. ROSEBECK & ASSOCIATES
REGISTERED SURVEYOR
705 WILLOW CREEK DRIVE, AMHERST, OHIO 44001
PHONE: (440) 988-4657

SHEET 1 OF 1