
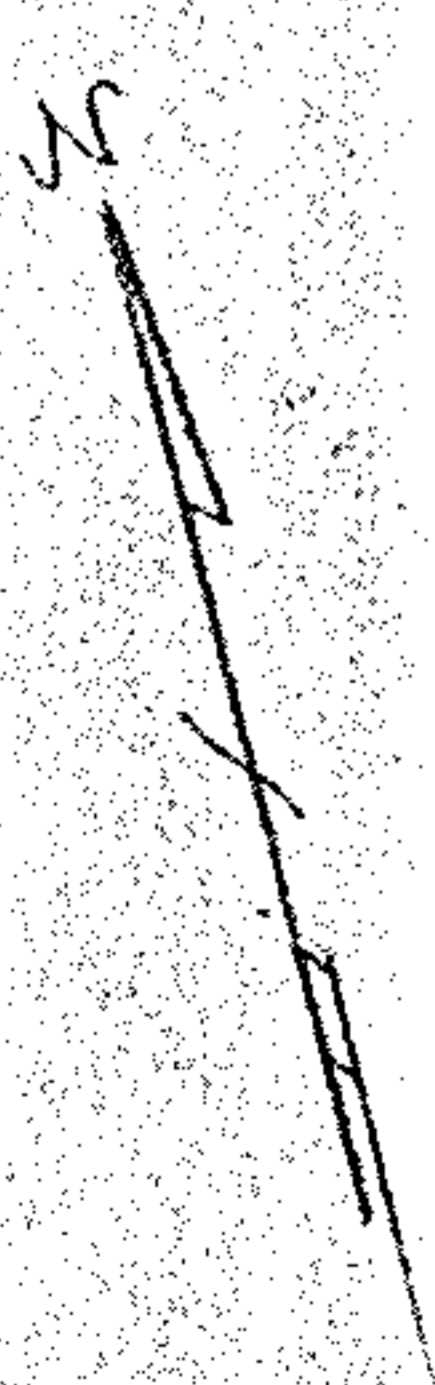


05-00-043-108

5-00-043-B

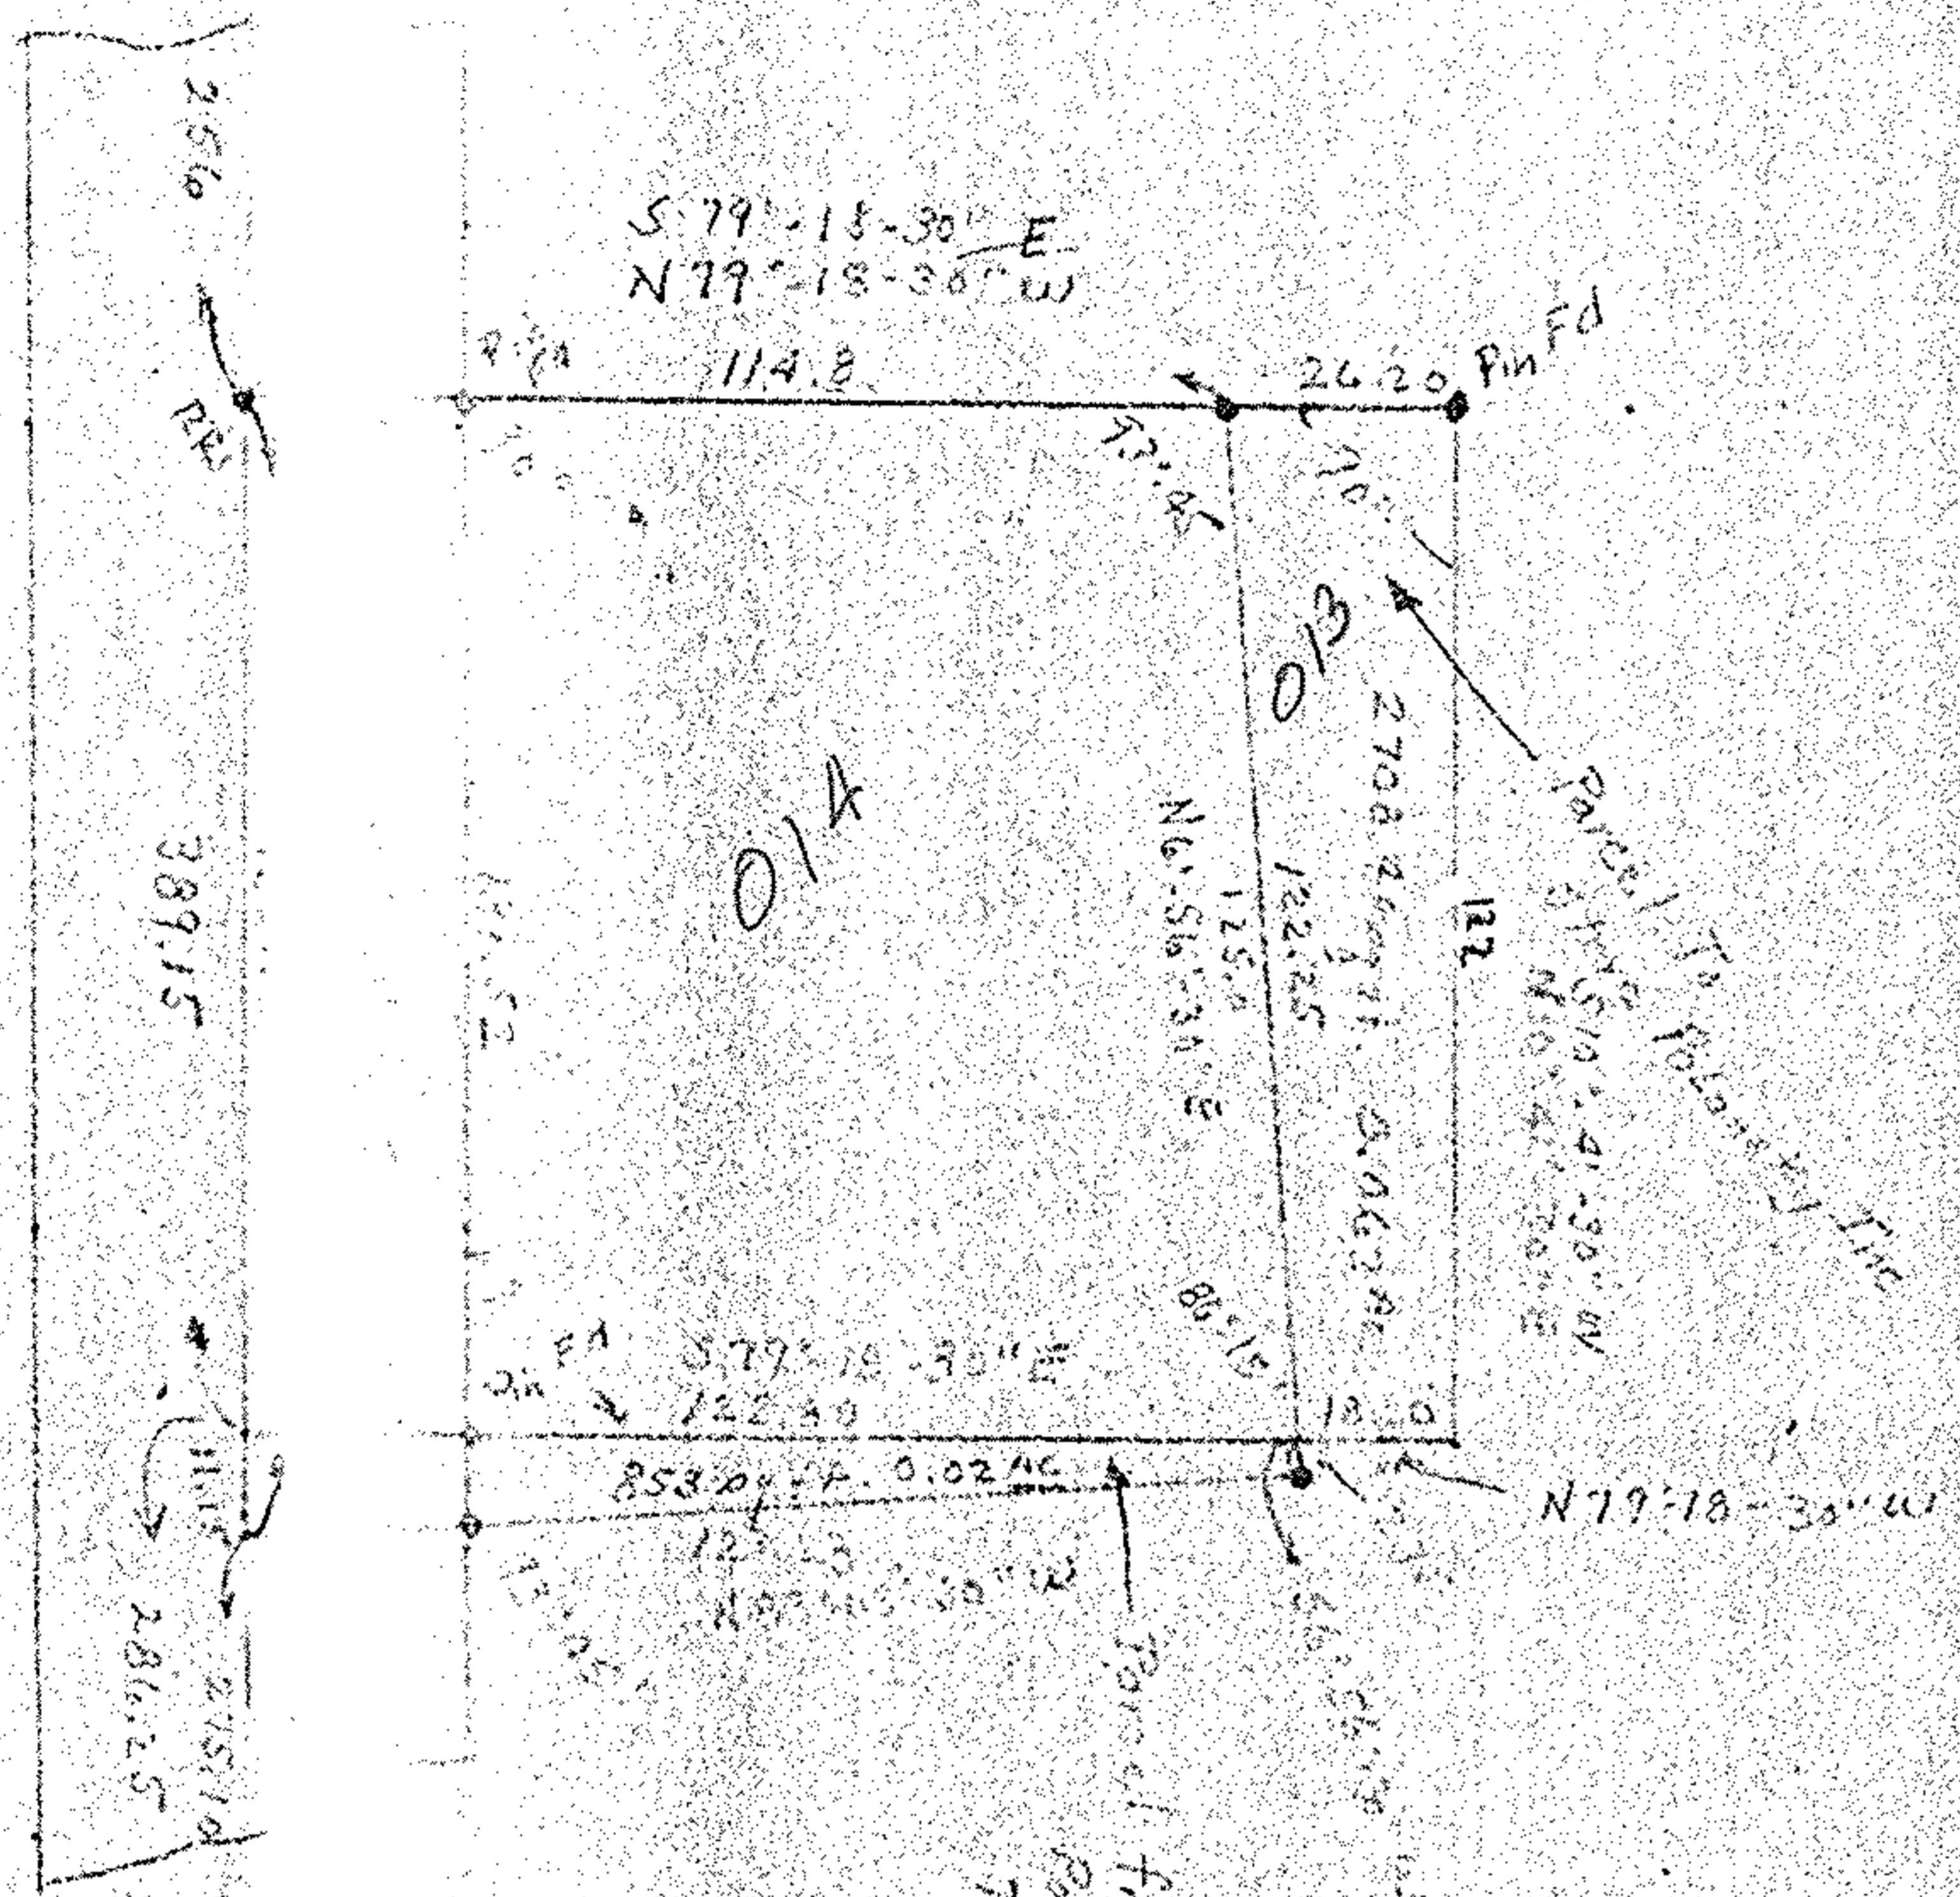


DEC 23 1974

8410

DEC 31 1975

APPROVED BY THE LORAIN CITY PLANNING
 COMMISSION NO PLAT REQUIRED
Tony Rodgers
 SECRETARY LORAIN CITY PLANNING COMMISSION

5-00-043-108-013
 014
 016

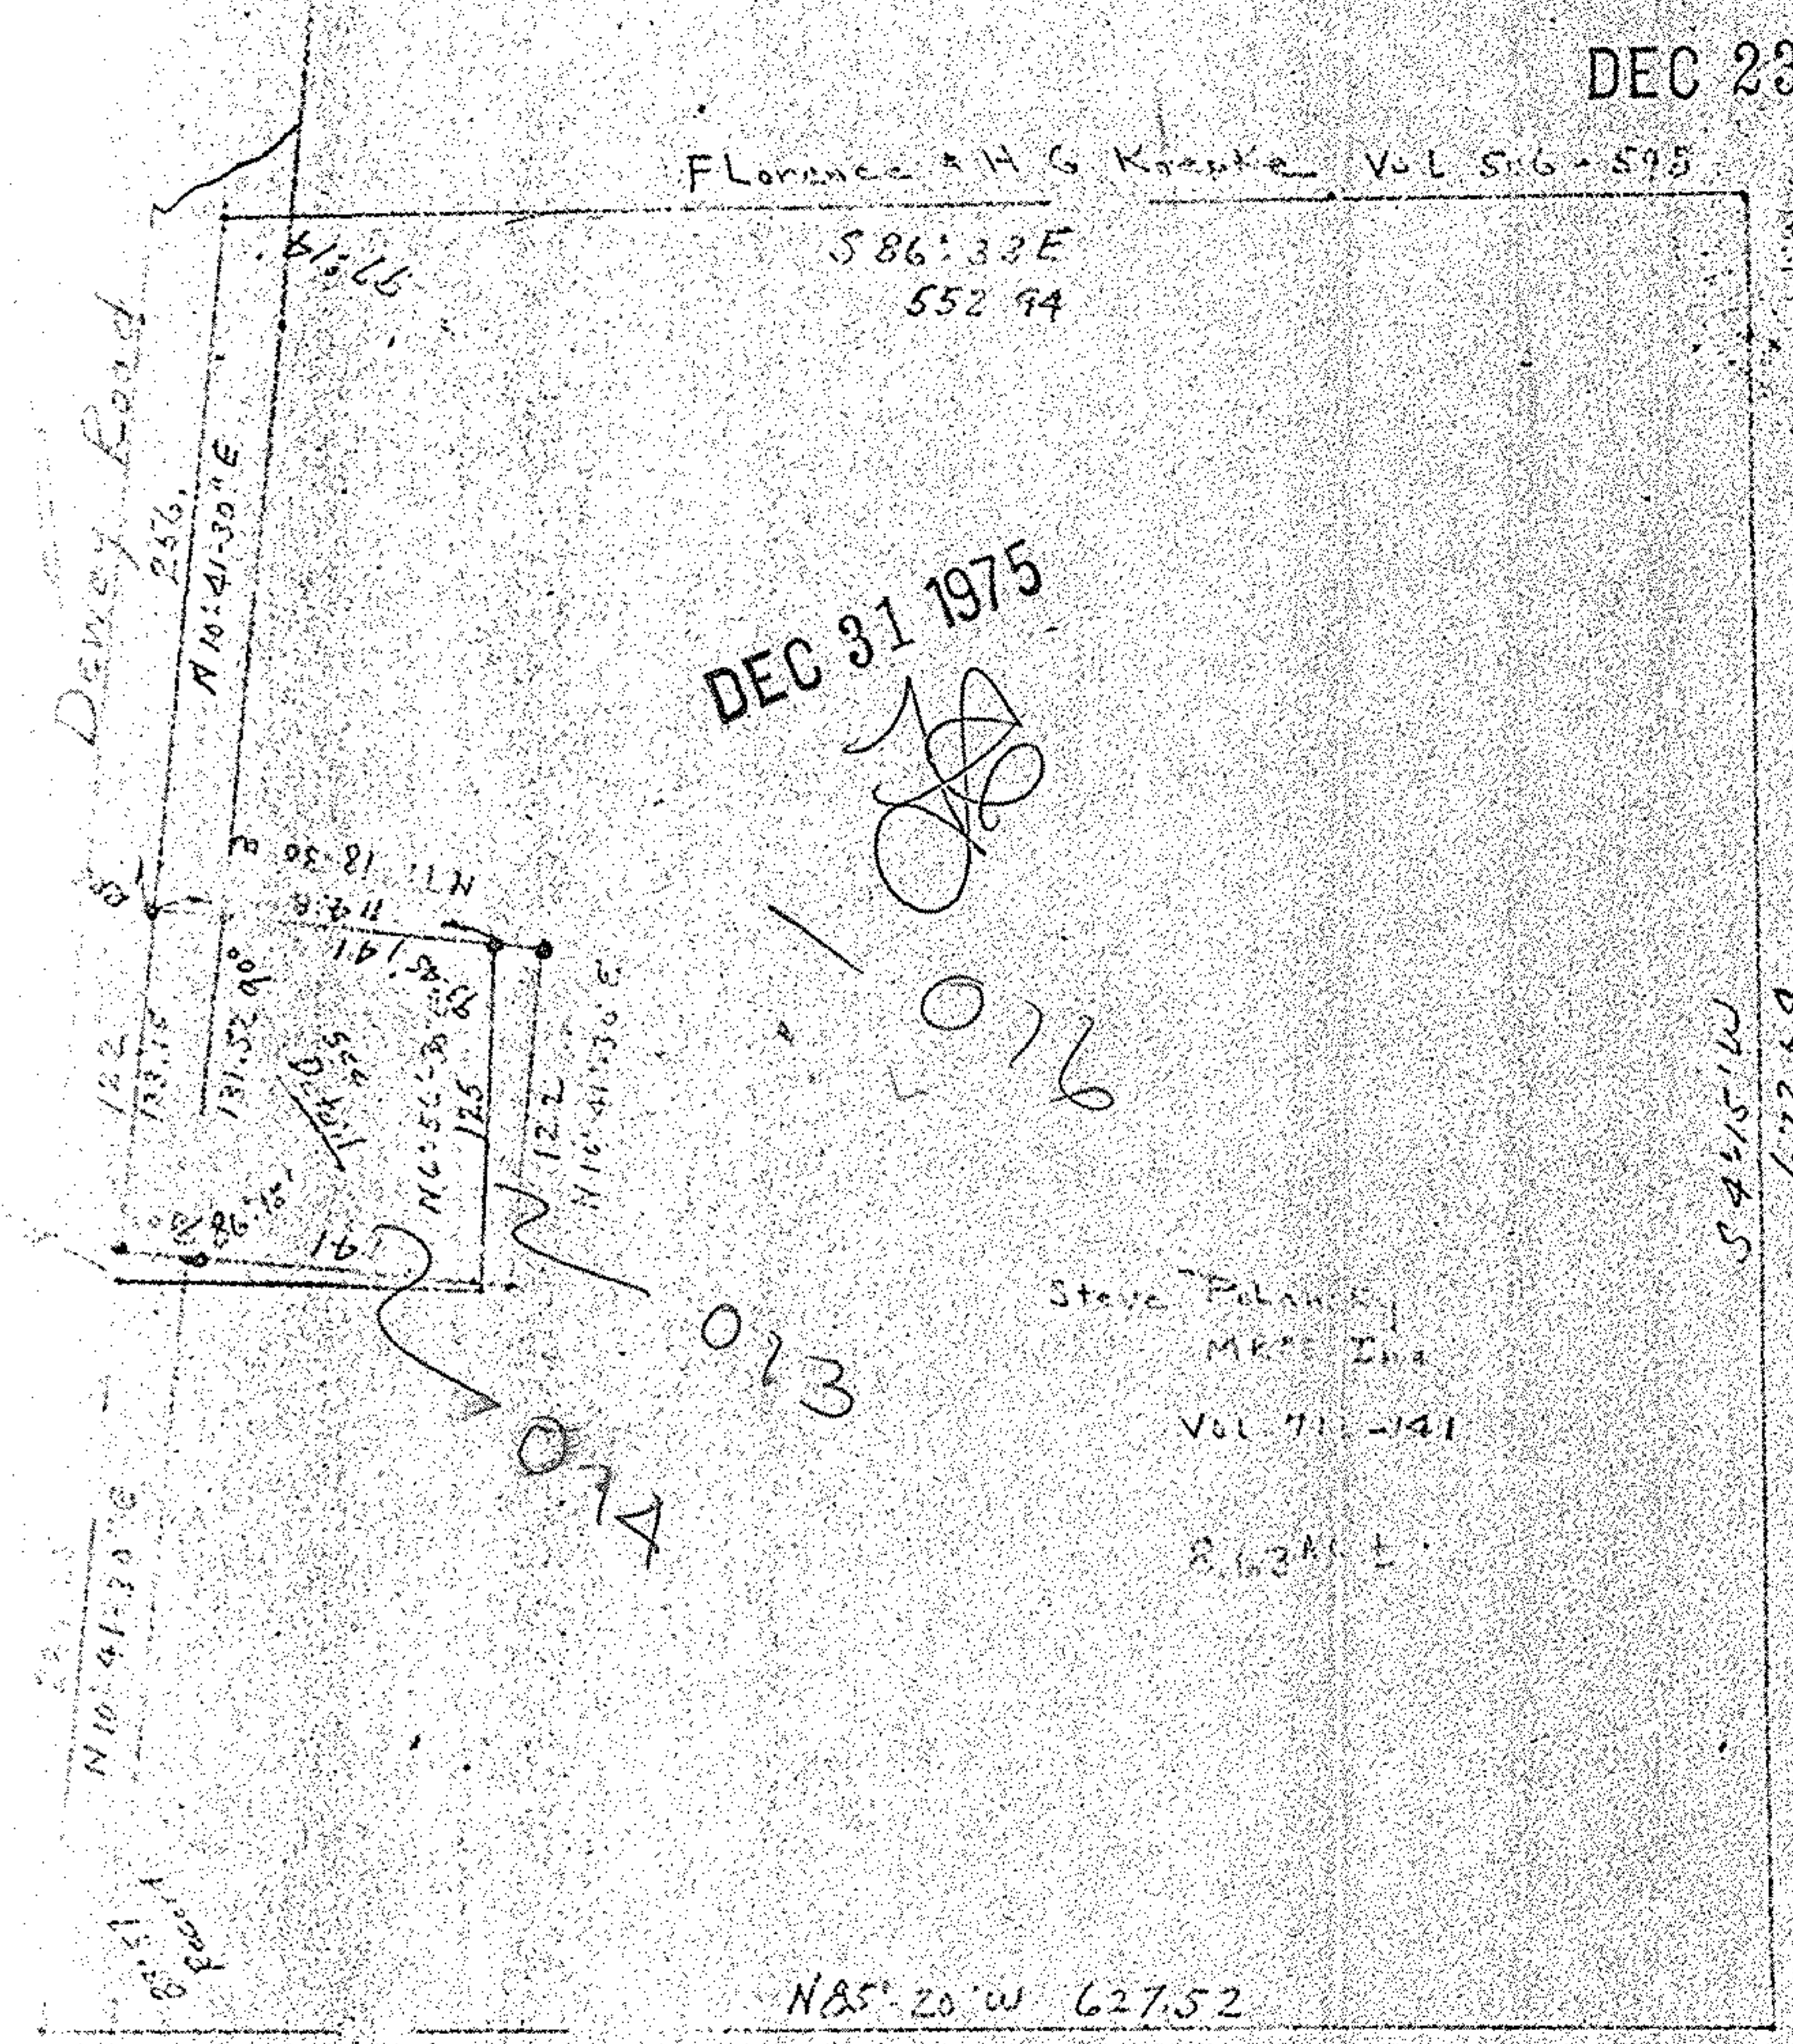

DEC 23 1974

8410

DEC 31 1975

Steve Polanski
 MKP Inc
 Vol 711-141
 86341 E

APPROVED BY THE LORAIN CITY PLANNING
 COMMISSION NO PLAT REQUIRED
Tony Rodgers
 SECRETARY LORAIN CITY PLANNING COMMISSION

5-00-043-B