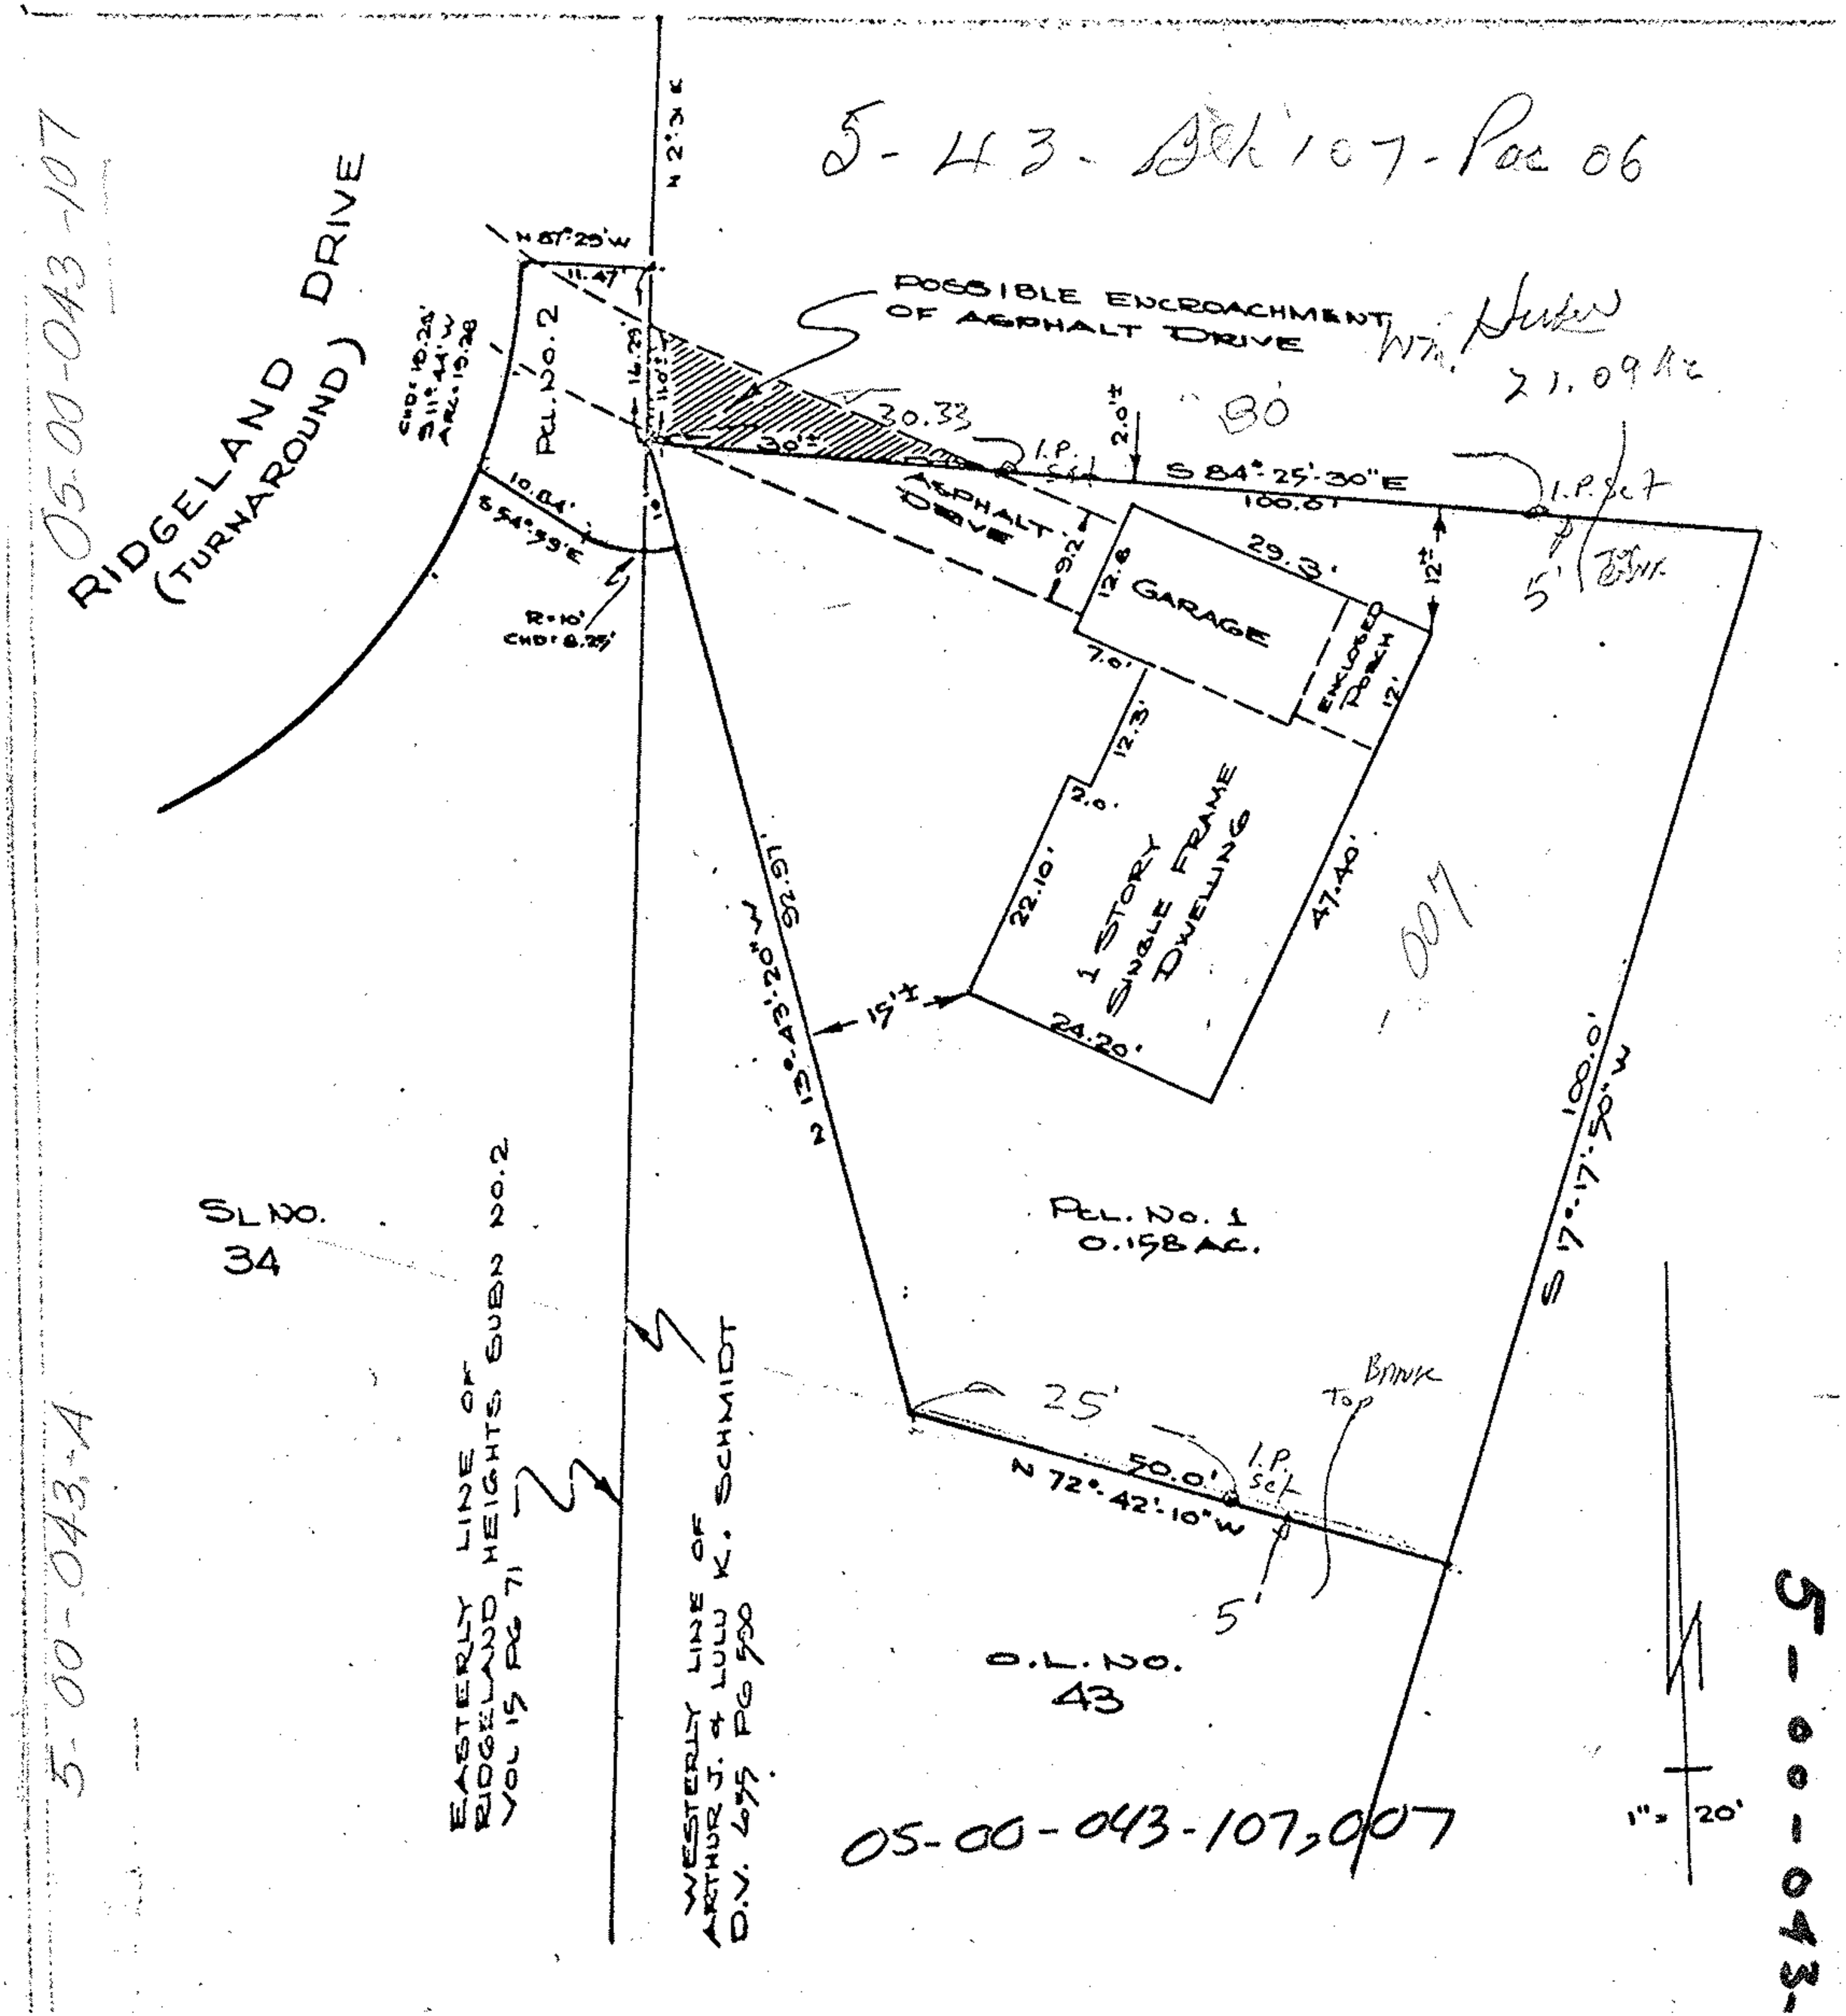

5-43-Bk 107-Pac 06
05-00-043-107
RIDGELAND DRIVE
(TURNAROUND)
N 87°29'W
11.47'
POSSIBLE ENCROACHMENT OF ASPHALT DRIVE
Wm. Huber
21.09 Ac
PCL. NO. 2
30.33
30'±
I.P. Set
2.0'±
S 84°25'30"E
100.0'
I.P. Set
5'
ASPHALT DRIVE
10.84'
S 54°59'E
R=10'
CHD=8.25'
9.2'
12.8
GARAGE
29.3'
12'±
ENCLOSED PORCH
7.0'
12.3'
2.0'
22.10'
1 STORY SINGLE FRAME DWELLING
47.40'
24.20'
15'±
N 13°43'20"W
92.97'
007
100.0'
S 17°17'50"W
PCL. NO. 1
0.158 AC.
SL NO.
34
EASTERLY LINE OF RIDGELAND HEIGHTS SUBD NO. 2
VOL 15 PG 71
WESTERLY LINE OF ARTHUR J. & LULU K. SCHMIDT
D.V. 655 PG 590
25'
50.0'
N 72°42'10"W
I.P. Set
Top
Bank
5'
O.L. NO.
43
05-00-043-107,007
1" = 20'
5-00-043-A
5-00-043-