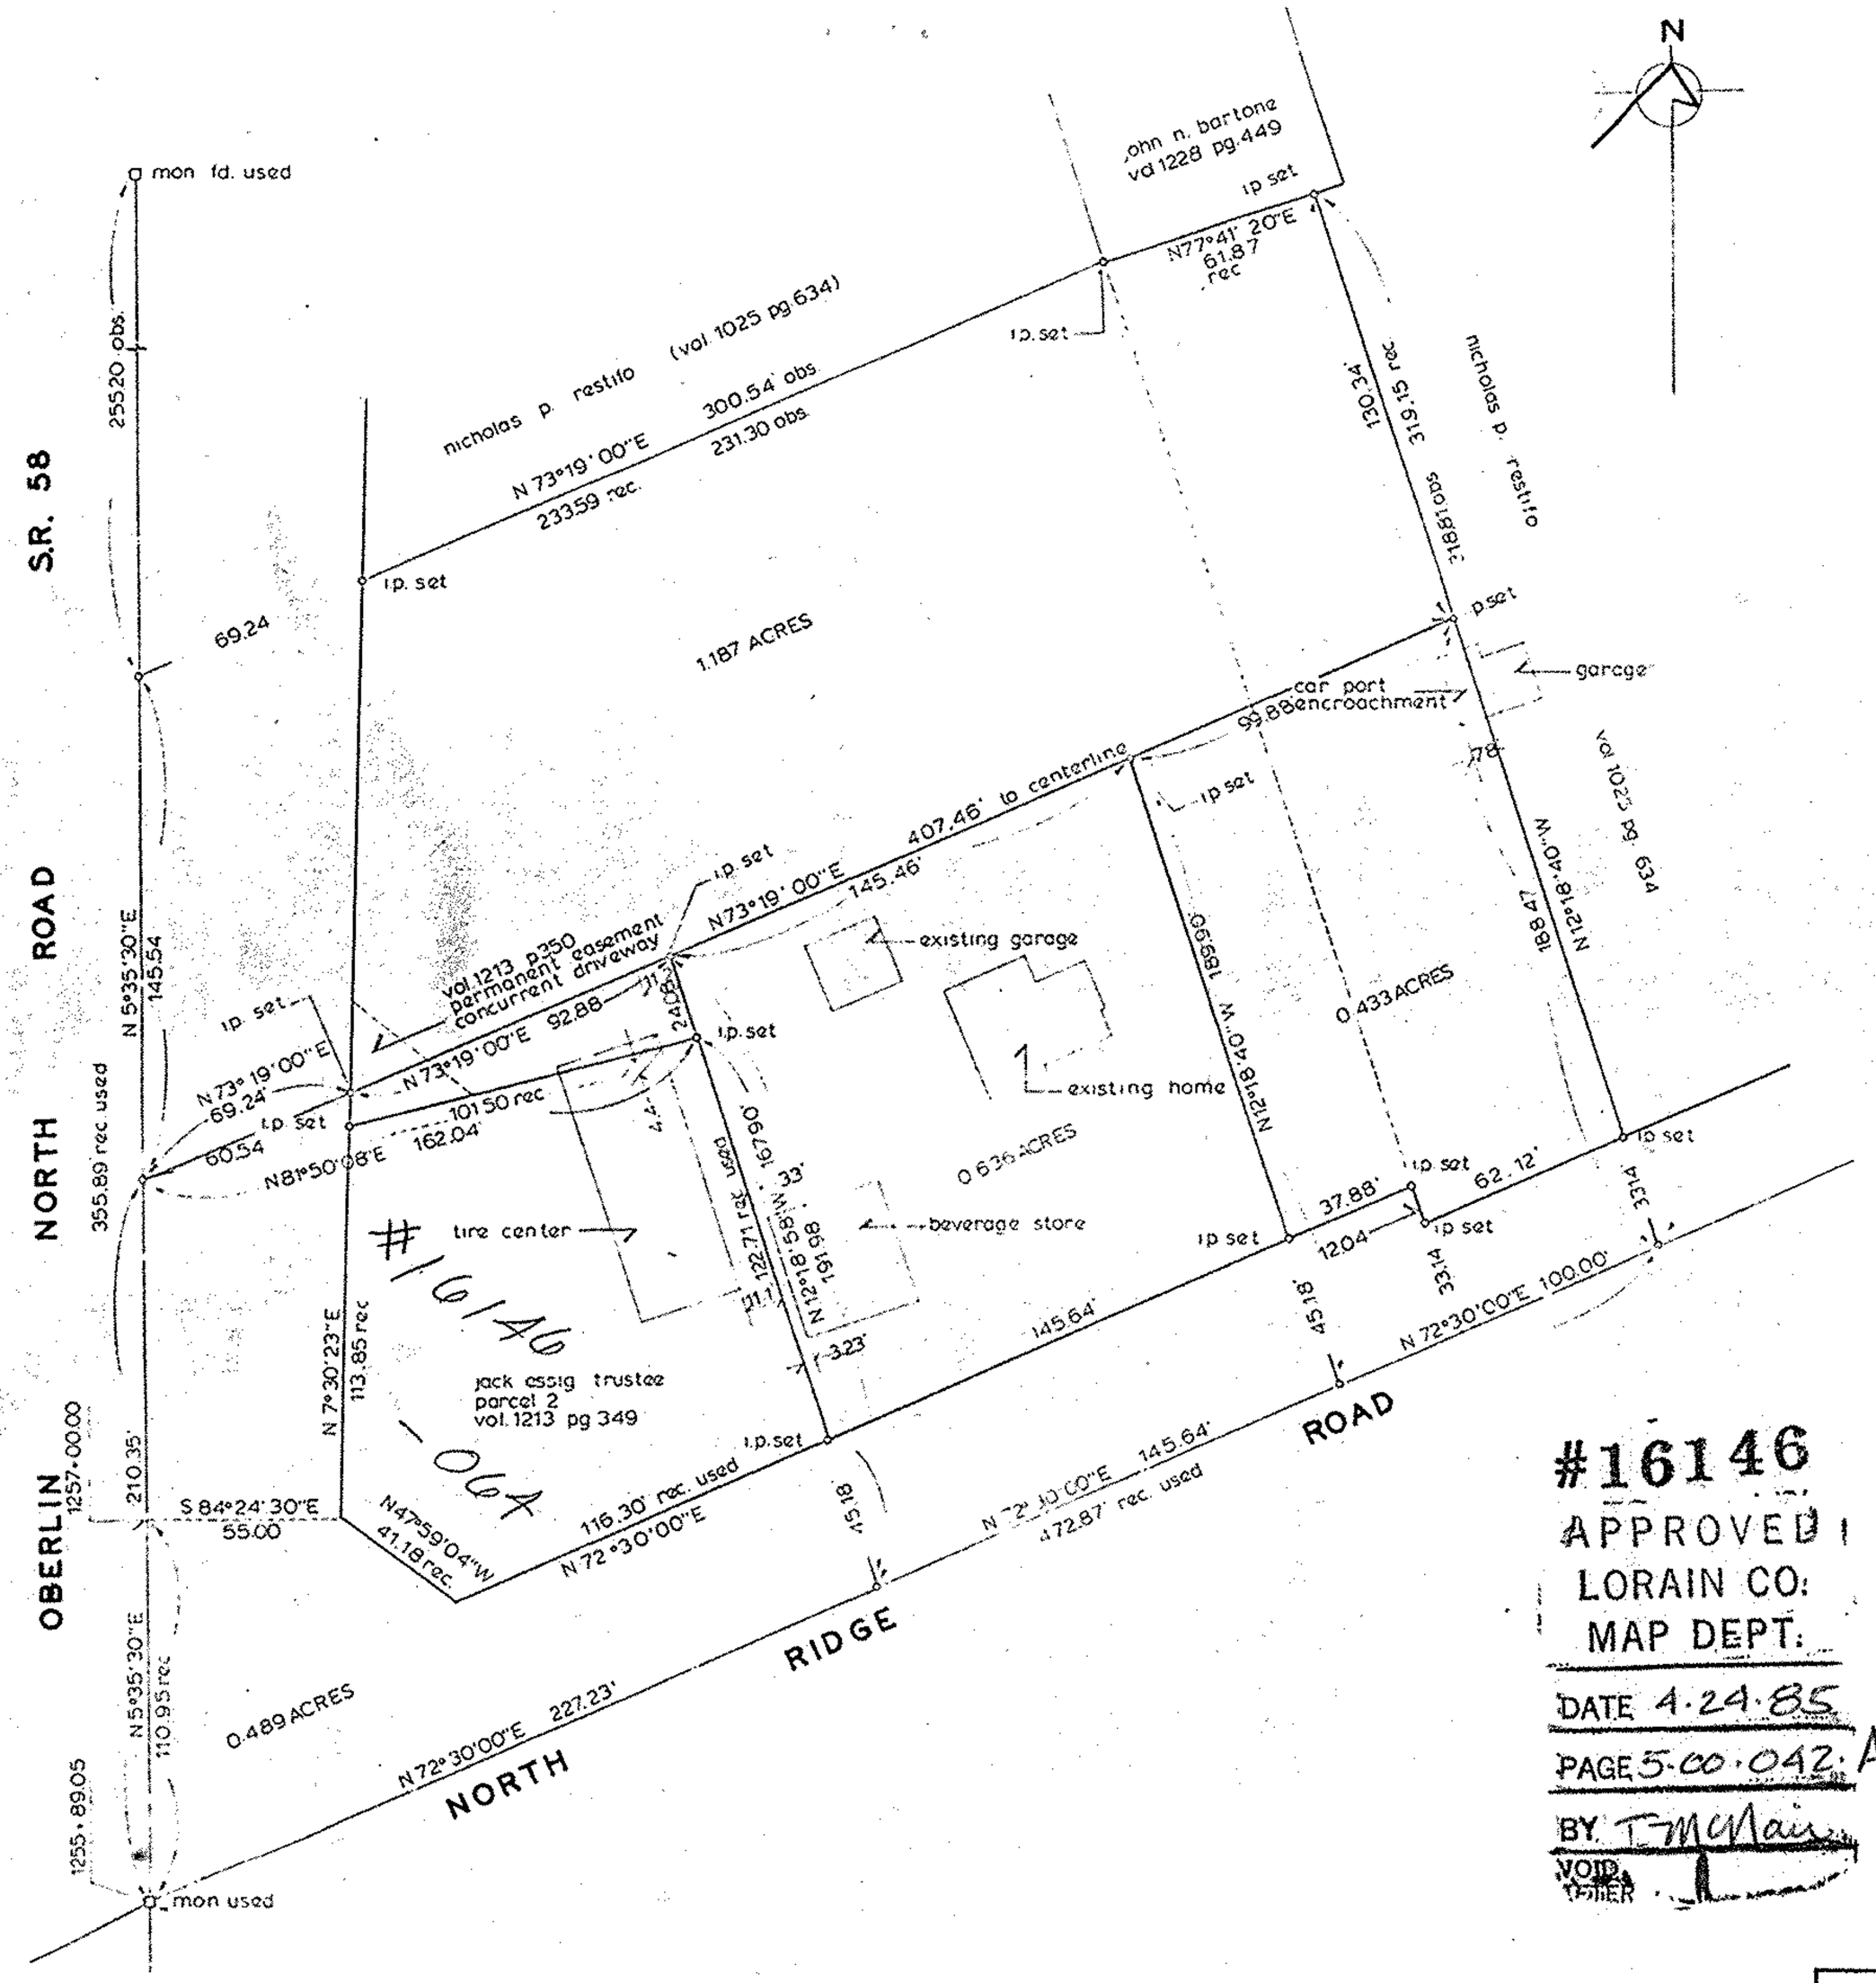

#16146 - 064

#16146
APPROVED
LORAIN CO.
MAP DEPT.
DATE 4-24-85
PAGE 5-00-042-A
BY T McMain
VOID

norman r. hura & associates
civil engineers consultants
surveyors

MR. JACK ESSIG	OUTLINE SURVEY - LOT SPLIT ORIGINAL LOT NO. 42 AMHERST TWP. CITY OF AMHERST LORAIN CO. OHIO	JUNE 1983 SCALE 1" = 30'-0"