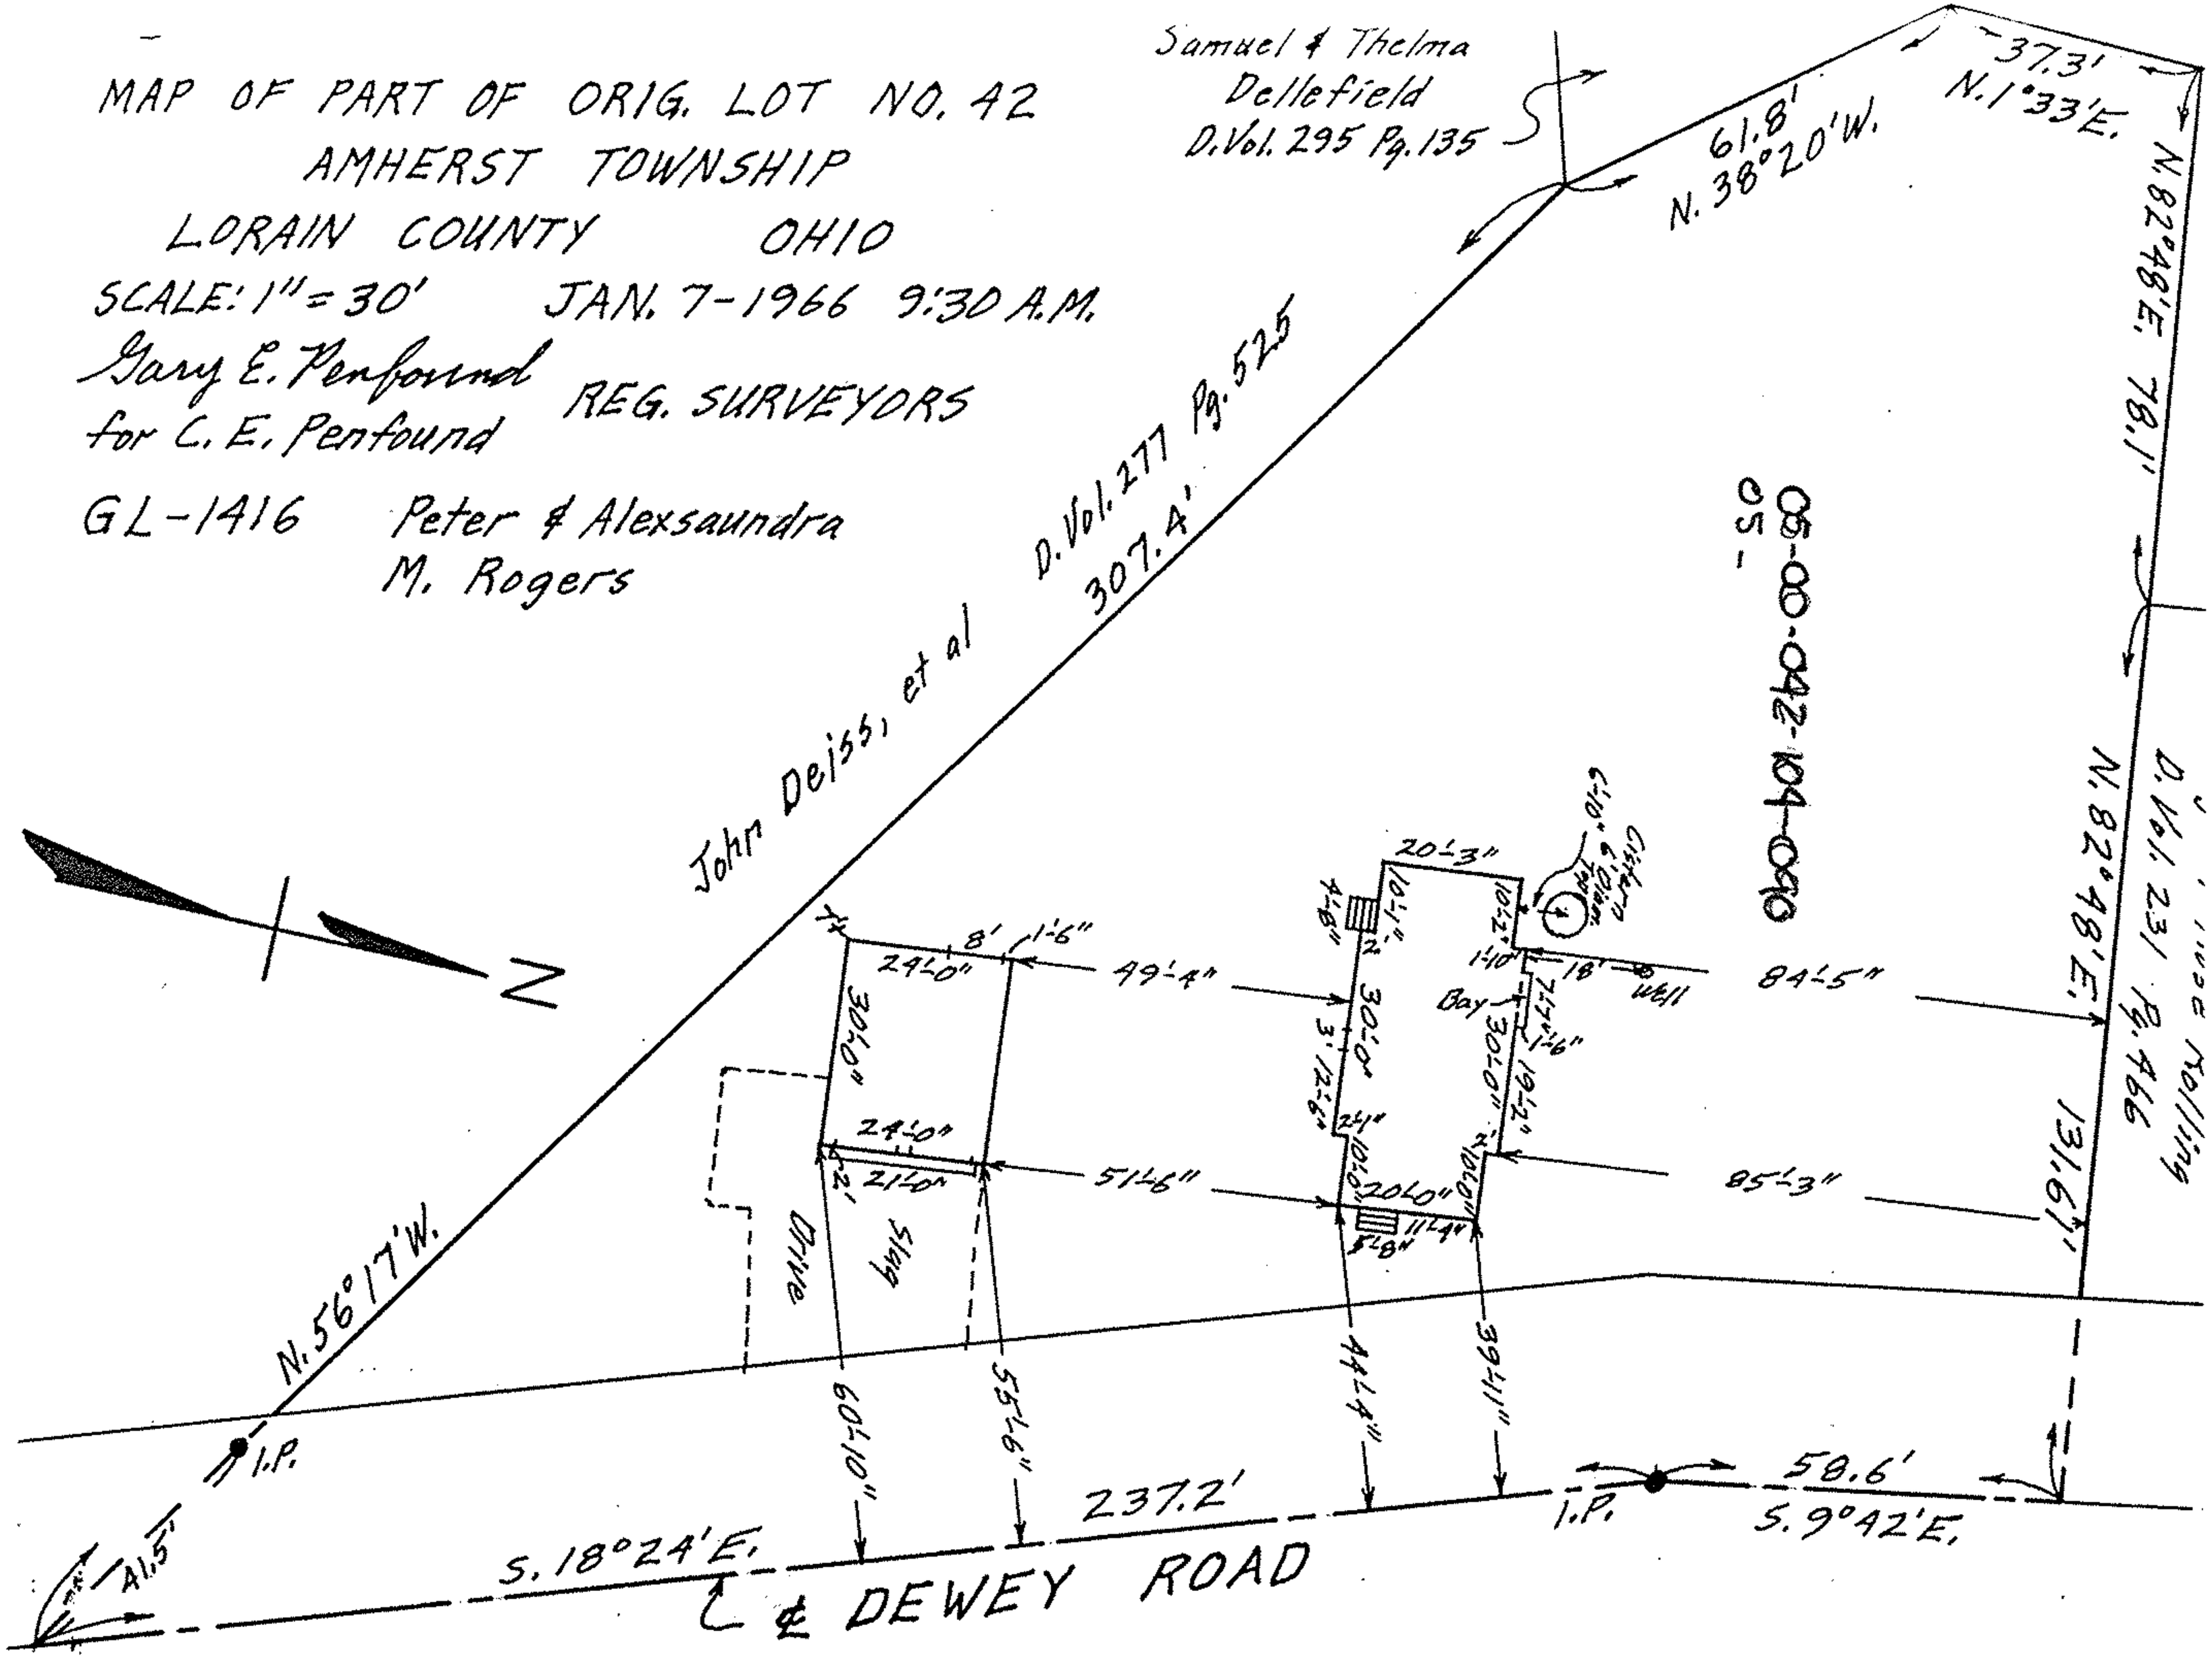
MAP OF PART OF ORIG. LOT NO. 42
AMHERST TOWNSHIP
LORAIN COUNTY OHIO
SCALE: 1" = 30'
JAN. 7-1966 9:30 A.M.
Gary E. Penfound
for C. E. Penfound
REG. SURVEYORS
GL-1416
Peter & Alexsaundra
M. Rogers
Samuel & Thelma
Dellefield
D.Vol. 295 Pg. 135
John Deiss, et al
D. Vol. 277 Pg. 525
307.4'
61.8'
N. 38°20'W.
37.3'
N. 1°33'E.
N. 82°48'E. 78.1'
N. 82°48'E. 131.6'
D. Vol. 231 Pg. 466
05-00-042-104-090
05-
N
N. 56°17'W.
I.P.
41.5'
S. 18°24'E.
237.2'
I.P.
58.6'
S. 9°42'E.
℄ DEWEY ROAD
60'-10"
55'-6"
44'-4"
39'-11"
24'-0"
8'
1'-6"
49'-4"
30'-0"
24'-0"
21'-0"
51'-6"
20'-3"
30'-0"
20'-0"
11'-4"
84'-5"
85'-3"
Bay
Well
Drive
Slag