


5-00-041A

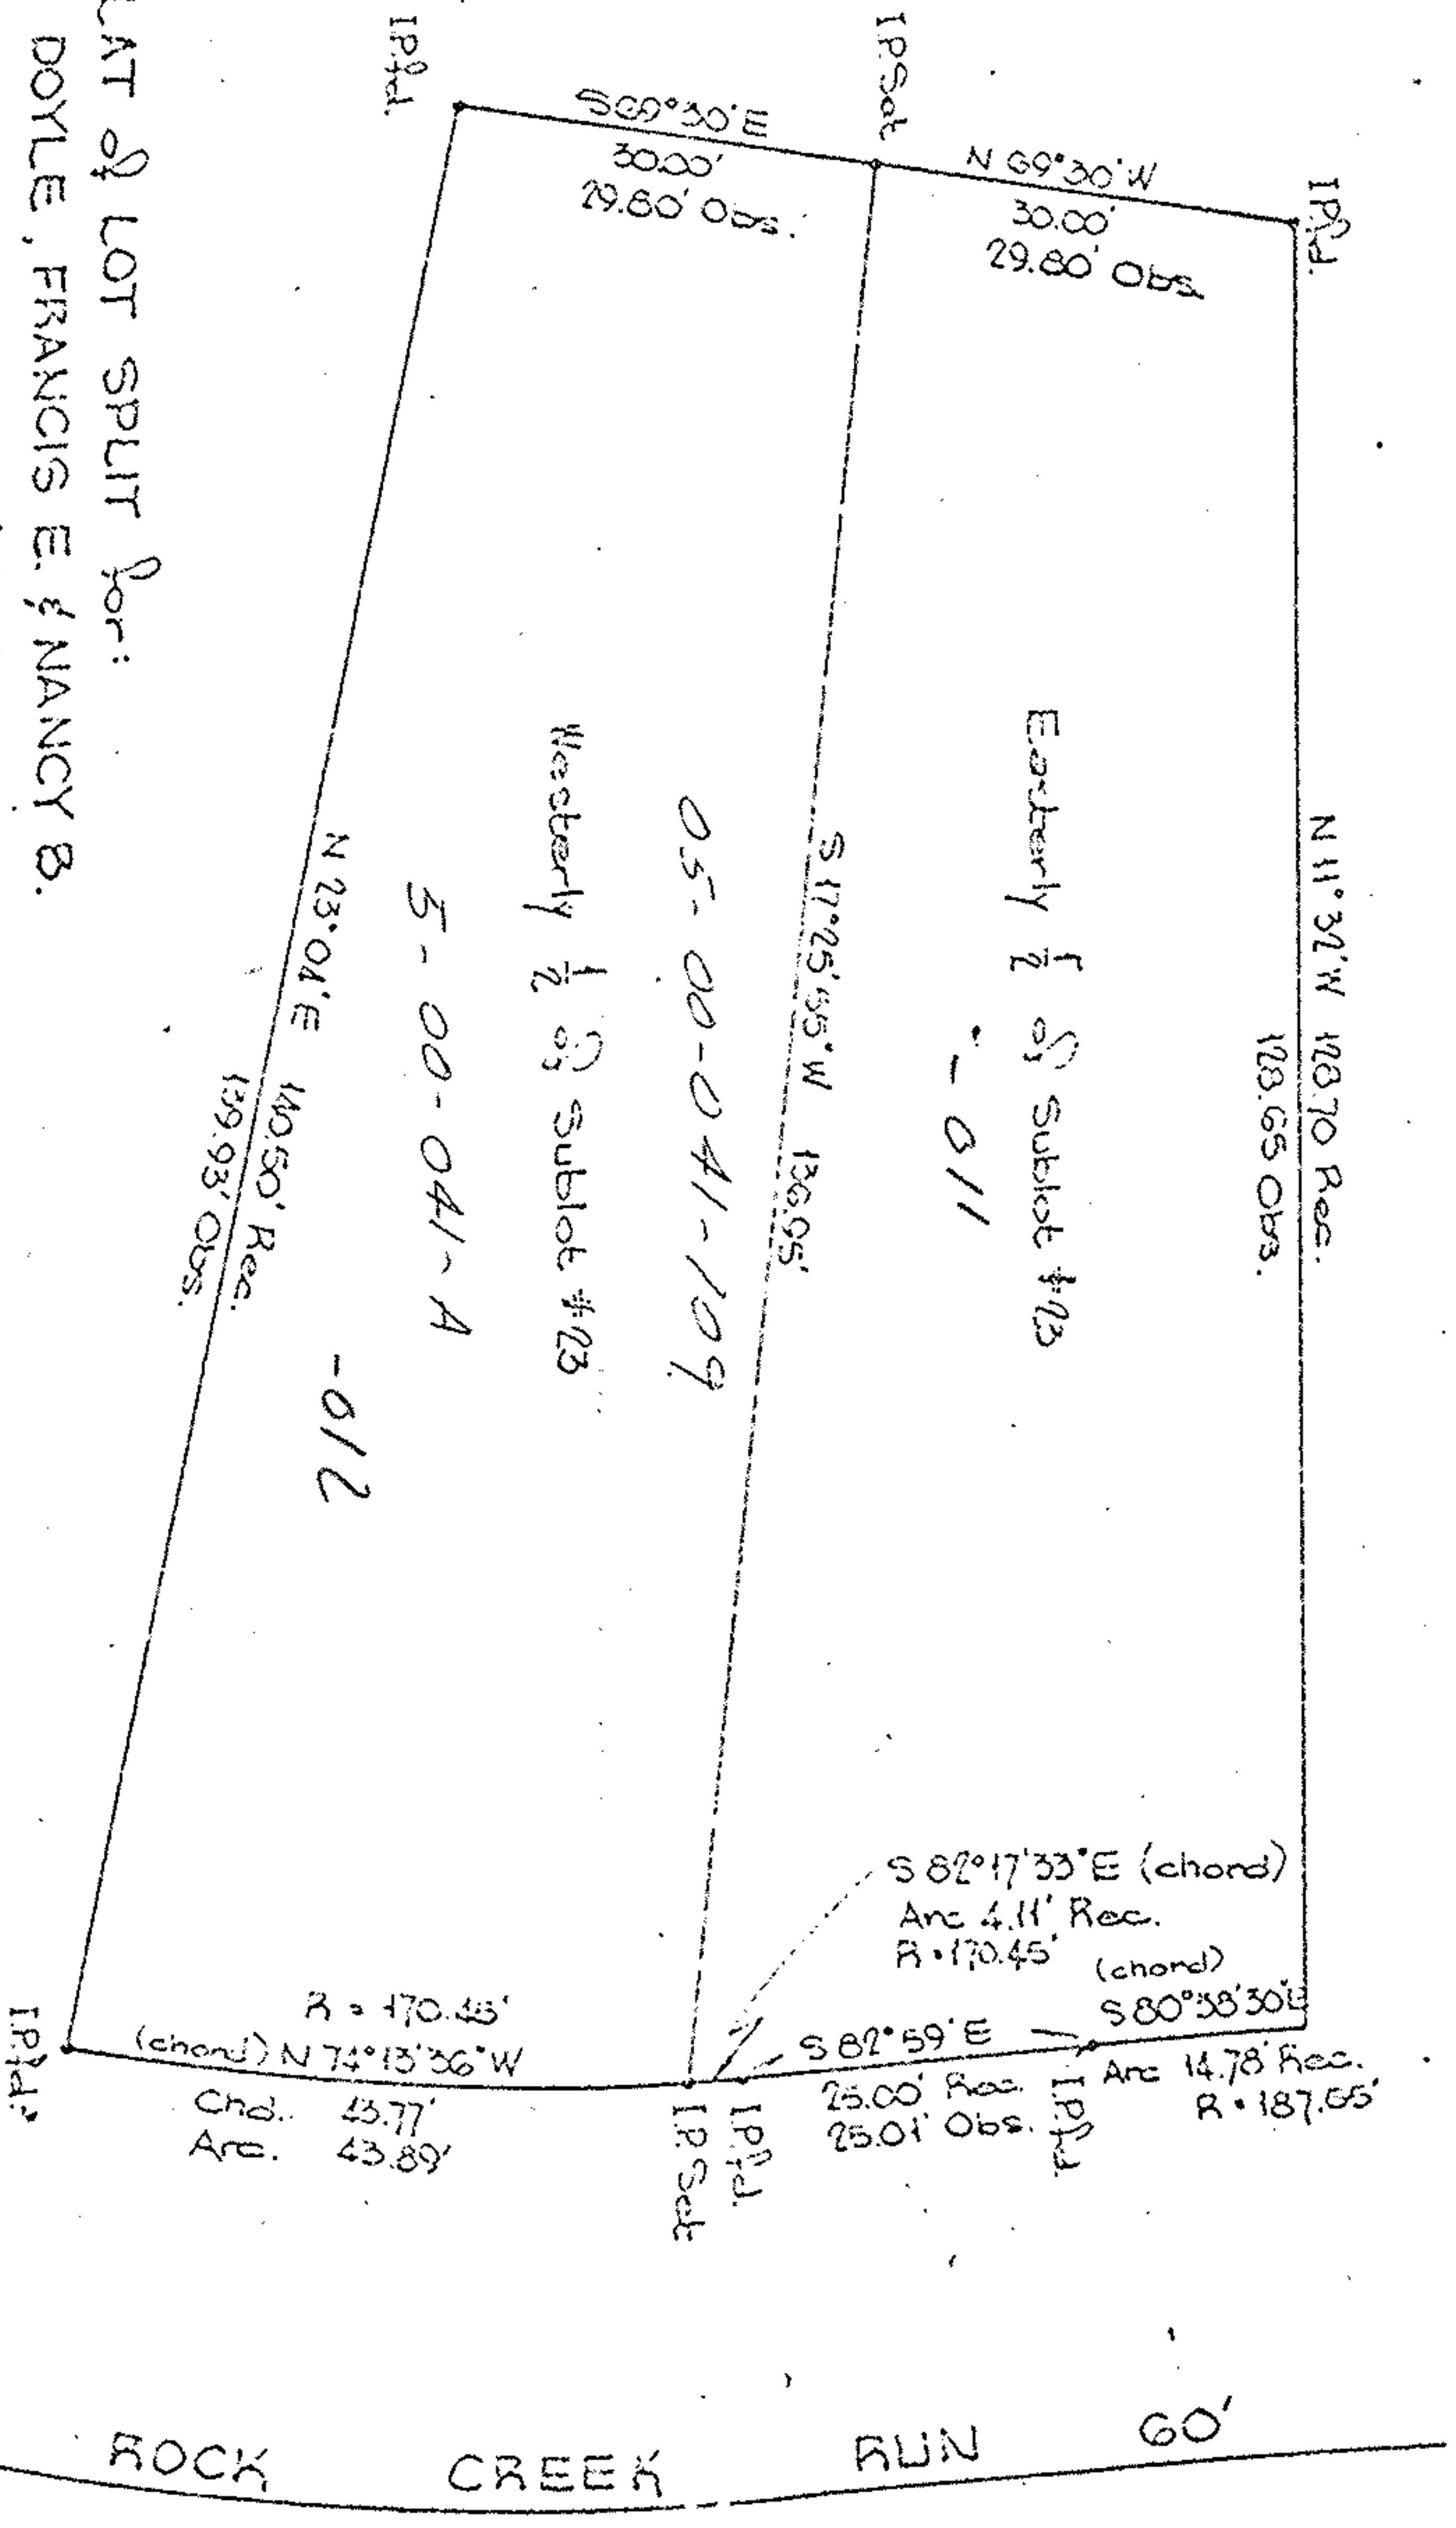

PLAT of LOT SPLIT for:
 DOYLE, FRANCIS E. & NANCY B.
 490 ROCK CREEK RUN
 AMHERST, OHIO

SUBLOT #23 of ROCK CREEK SUBDIVISION
 PLAT VOL. 21, P. 32. PART of ORIG. AMHERST
 TWP. LOTS 41 and 42
 NOW IN CITY of AMHERST, OHIO

05-00-041-109-011, 012

McGINCHY and ASSOCIATES.
 PROFESSIONAL ENGINEERS & SURVEYORS
 633 WEST BROAD STREET - CLEVELAND, OH.
 AUGUST 31, 1976
 4412195