05-00-041.107-005

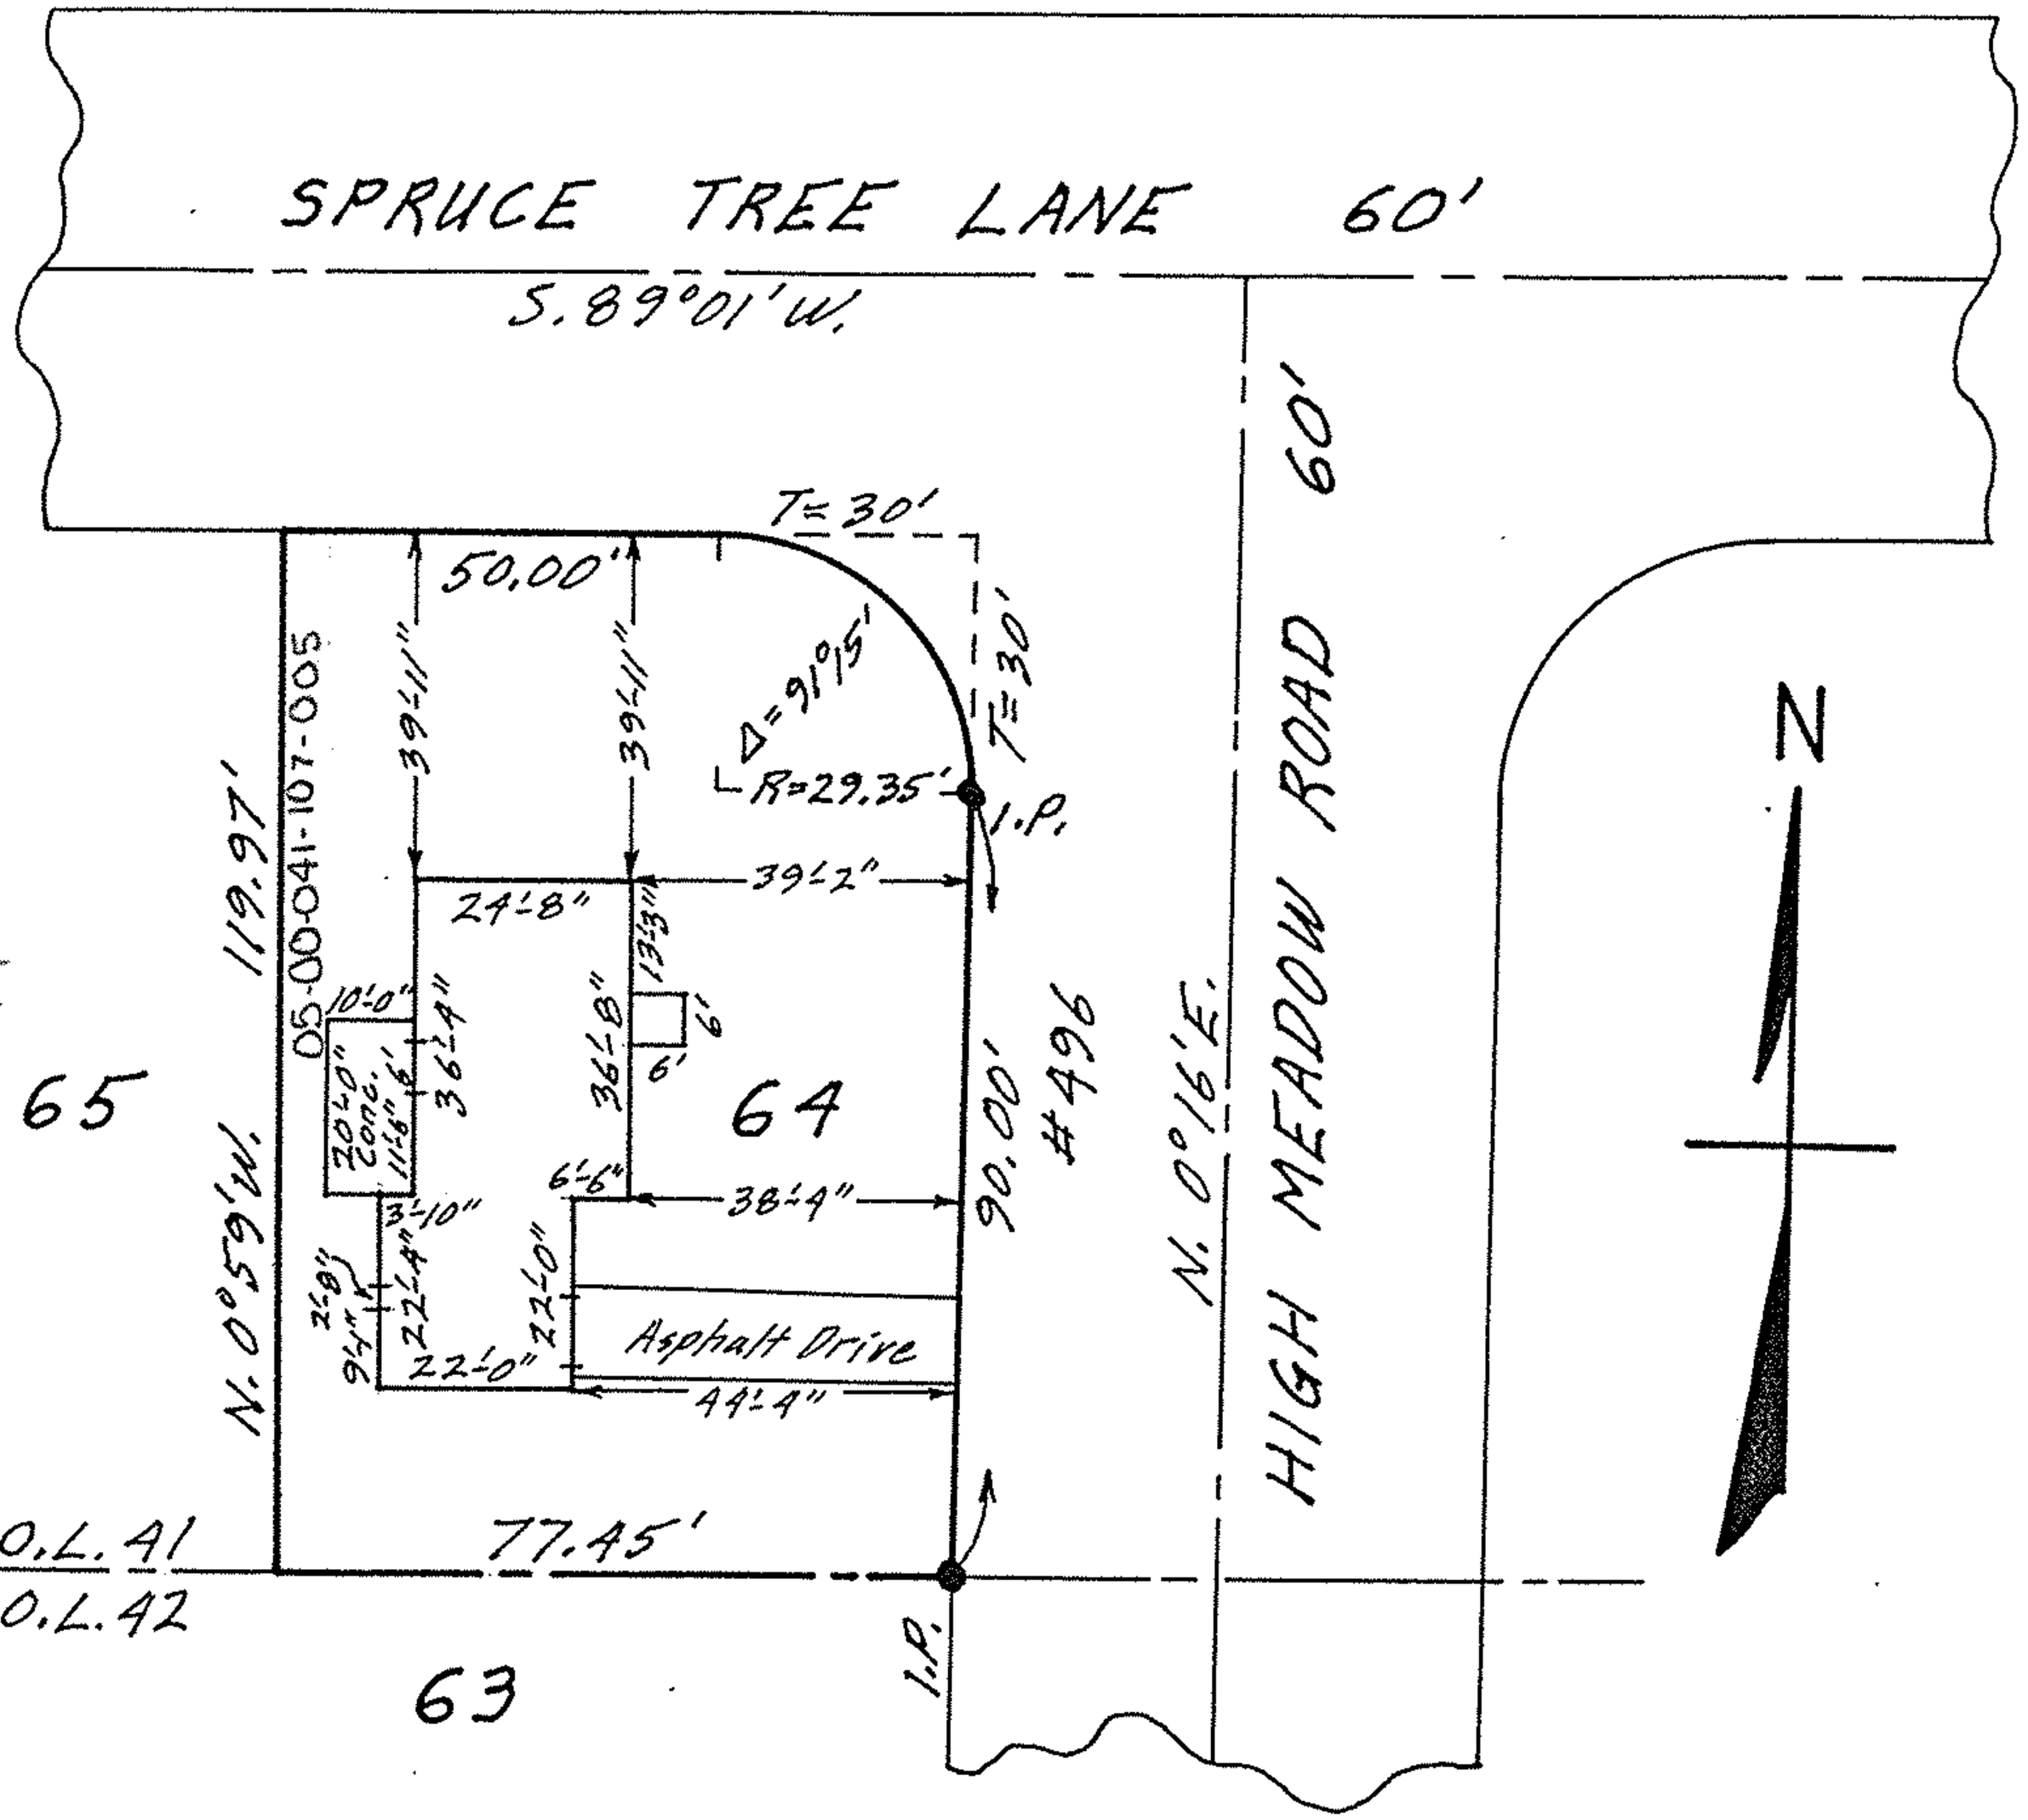

MAP OF SUB-LOT NO. 64
ROCK CREEK SUB'N. VOL. 21 PG. 32
ORIG. LOT 41 AMHERST TWP.
AMHERST CITY – LORAIN COUNTY – OHIO
SCALE: 1"=30' JUNE 19-1967 11:00 A.M.
Gary E. Penfound REG. SURVEYOR

William E. & Marilyn L. Matich