


STATE ROUTE 2  
 1747.86' C.M. 1747.71' REC.  
 N-83°50'52"-E

05-00-040-106-


STATE ROUTE 58

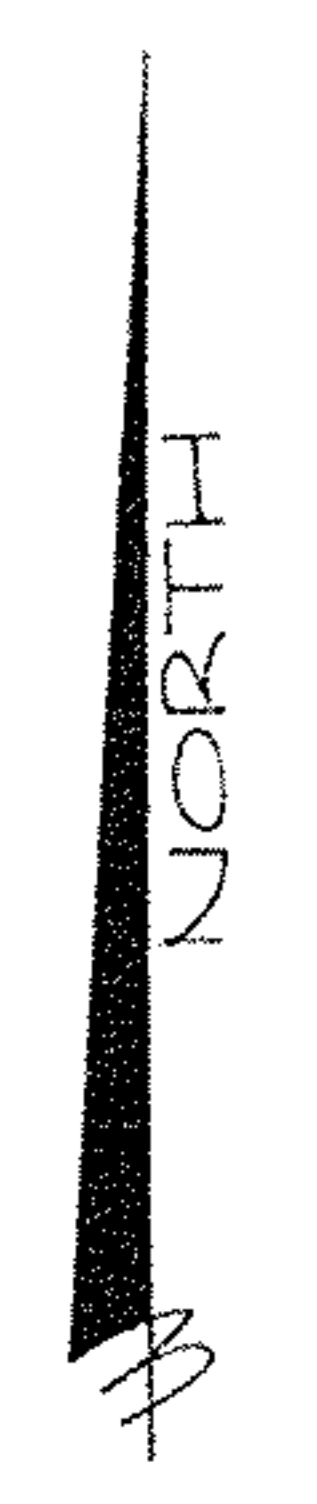

21004  
 APPROVED  
 DRAIN CO.  
 MAP DE  
 DATE 8-12-94  
 PAGE 5-00-040B  
 BY CAROLYN  
 FRANCIS  
 2.1004


1/2" REBAR IN  
 CONC. Fd.

1" IRON MON BOX  
 Fd. & USED

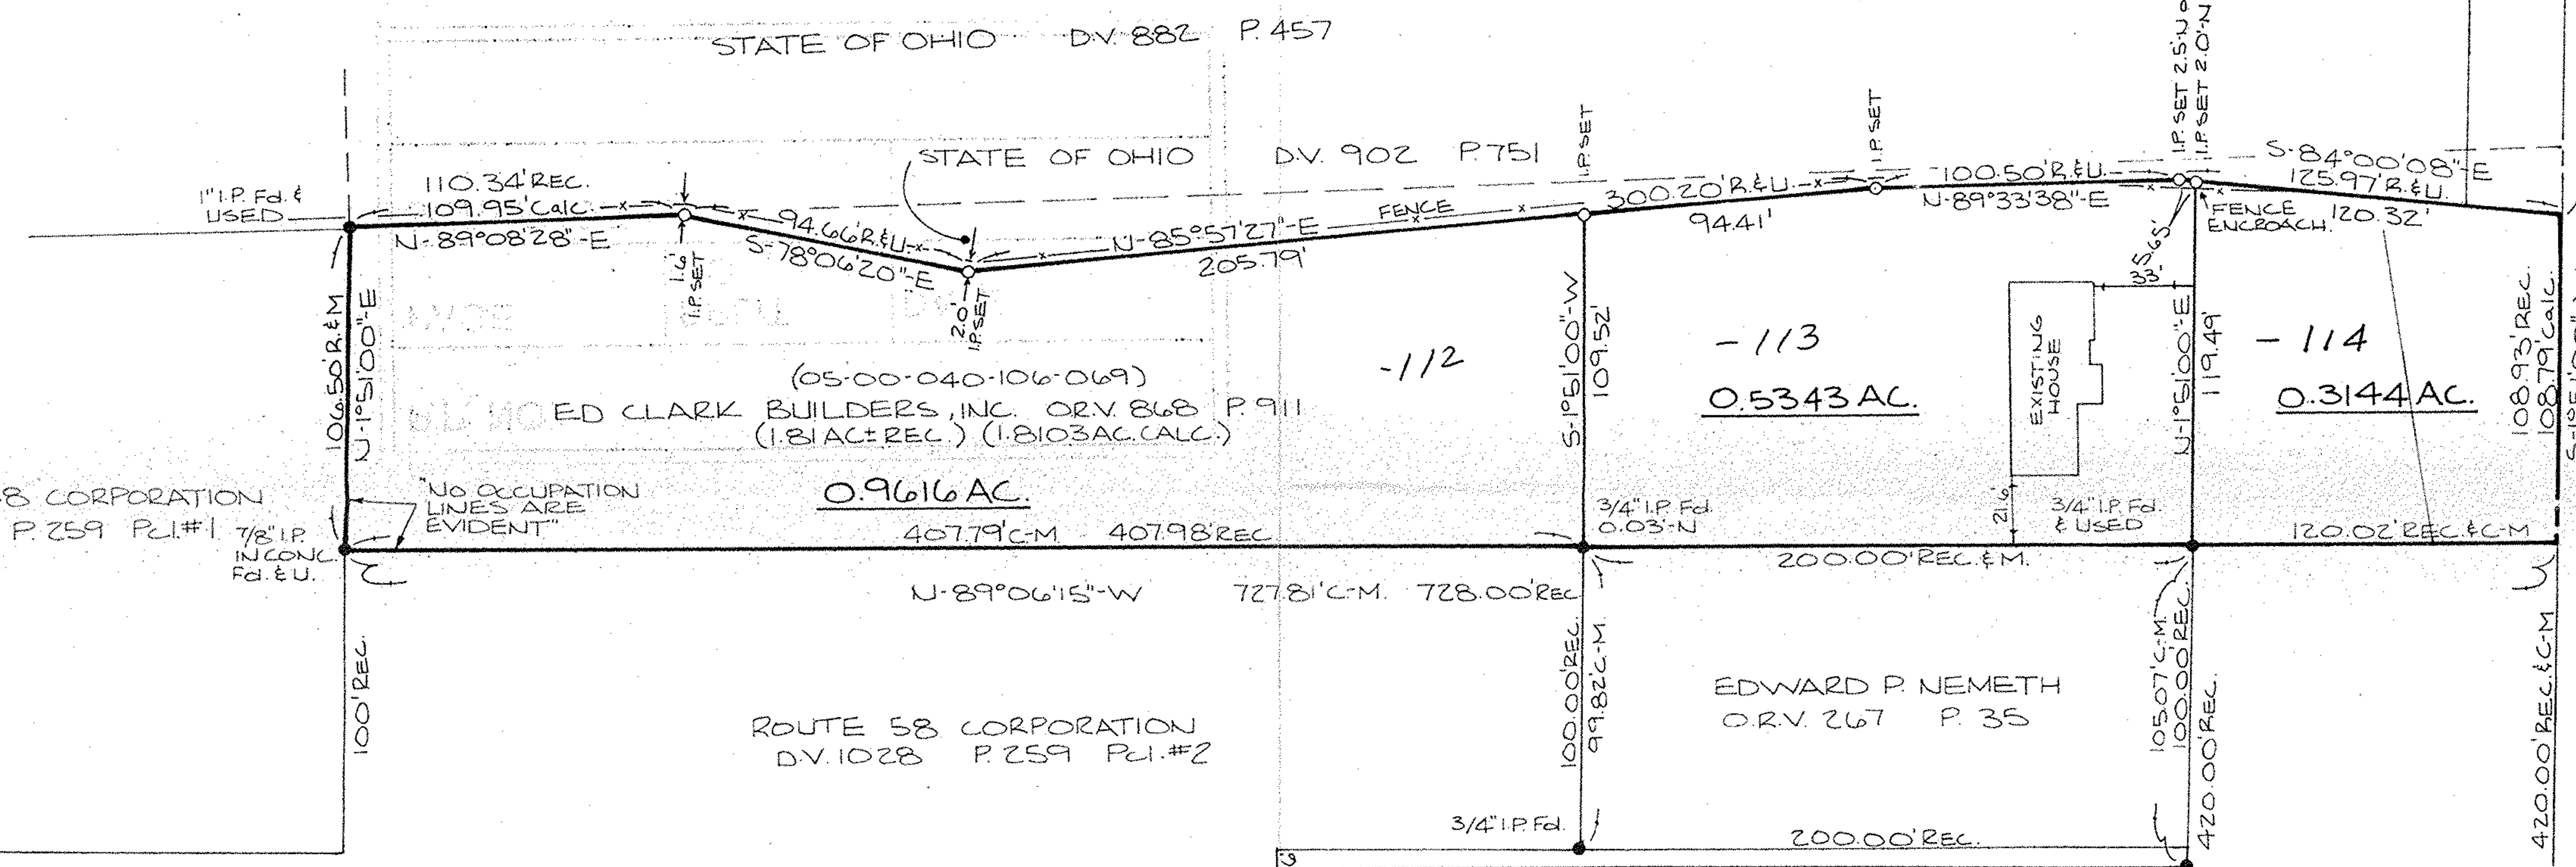

05-00-040-106-112, 113, 114

BASIS OF BEARINGS - CENTERLINE OF  
 LEAVITT RD., AS SHOWN IN P.V. 33  
 P. 40.

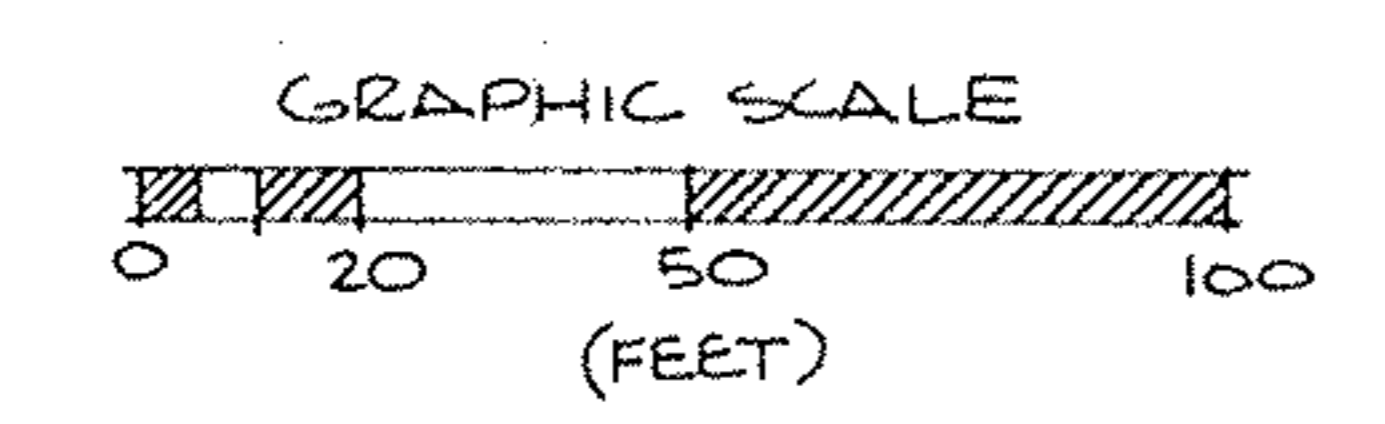


**SURVEY MAP**

PART OF ORIGINAL AMHERST TOWNSHIP LOT NO. 40  
 CITY OF AMHERST

COUNTY OF LORAIN MAY 16, 1994 STATE OF OHIO SCALE: 1"=50'

PREPARED BY:  
**KS ASSOCIATES INC.**  
 ENGINEERS SURVEYORS  
 REV. 6-3-94

*Michael A. Straub*  
 MICHAEL A. STRAUB, P.S.  
 REG. SURVEYOR NO. 7055

 

BLOCK "A"  
 PV 33 P. 40

LEAVITT ROAD

40 41  
 39 42