


05-00-040-106-110
20446


Ken:
Still a good #
Not split
No pending split
either

05-00-040-106-094

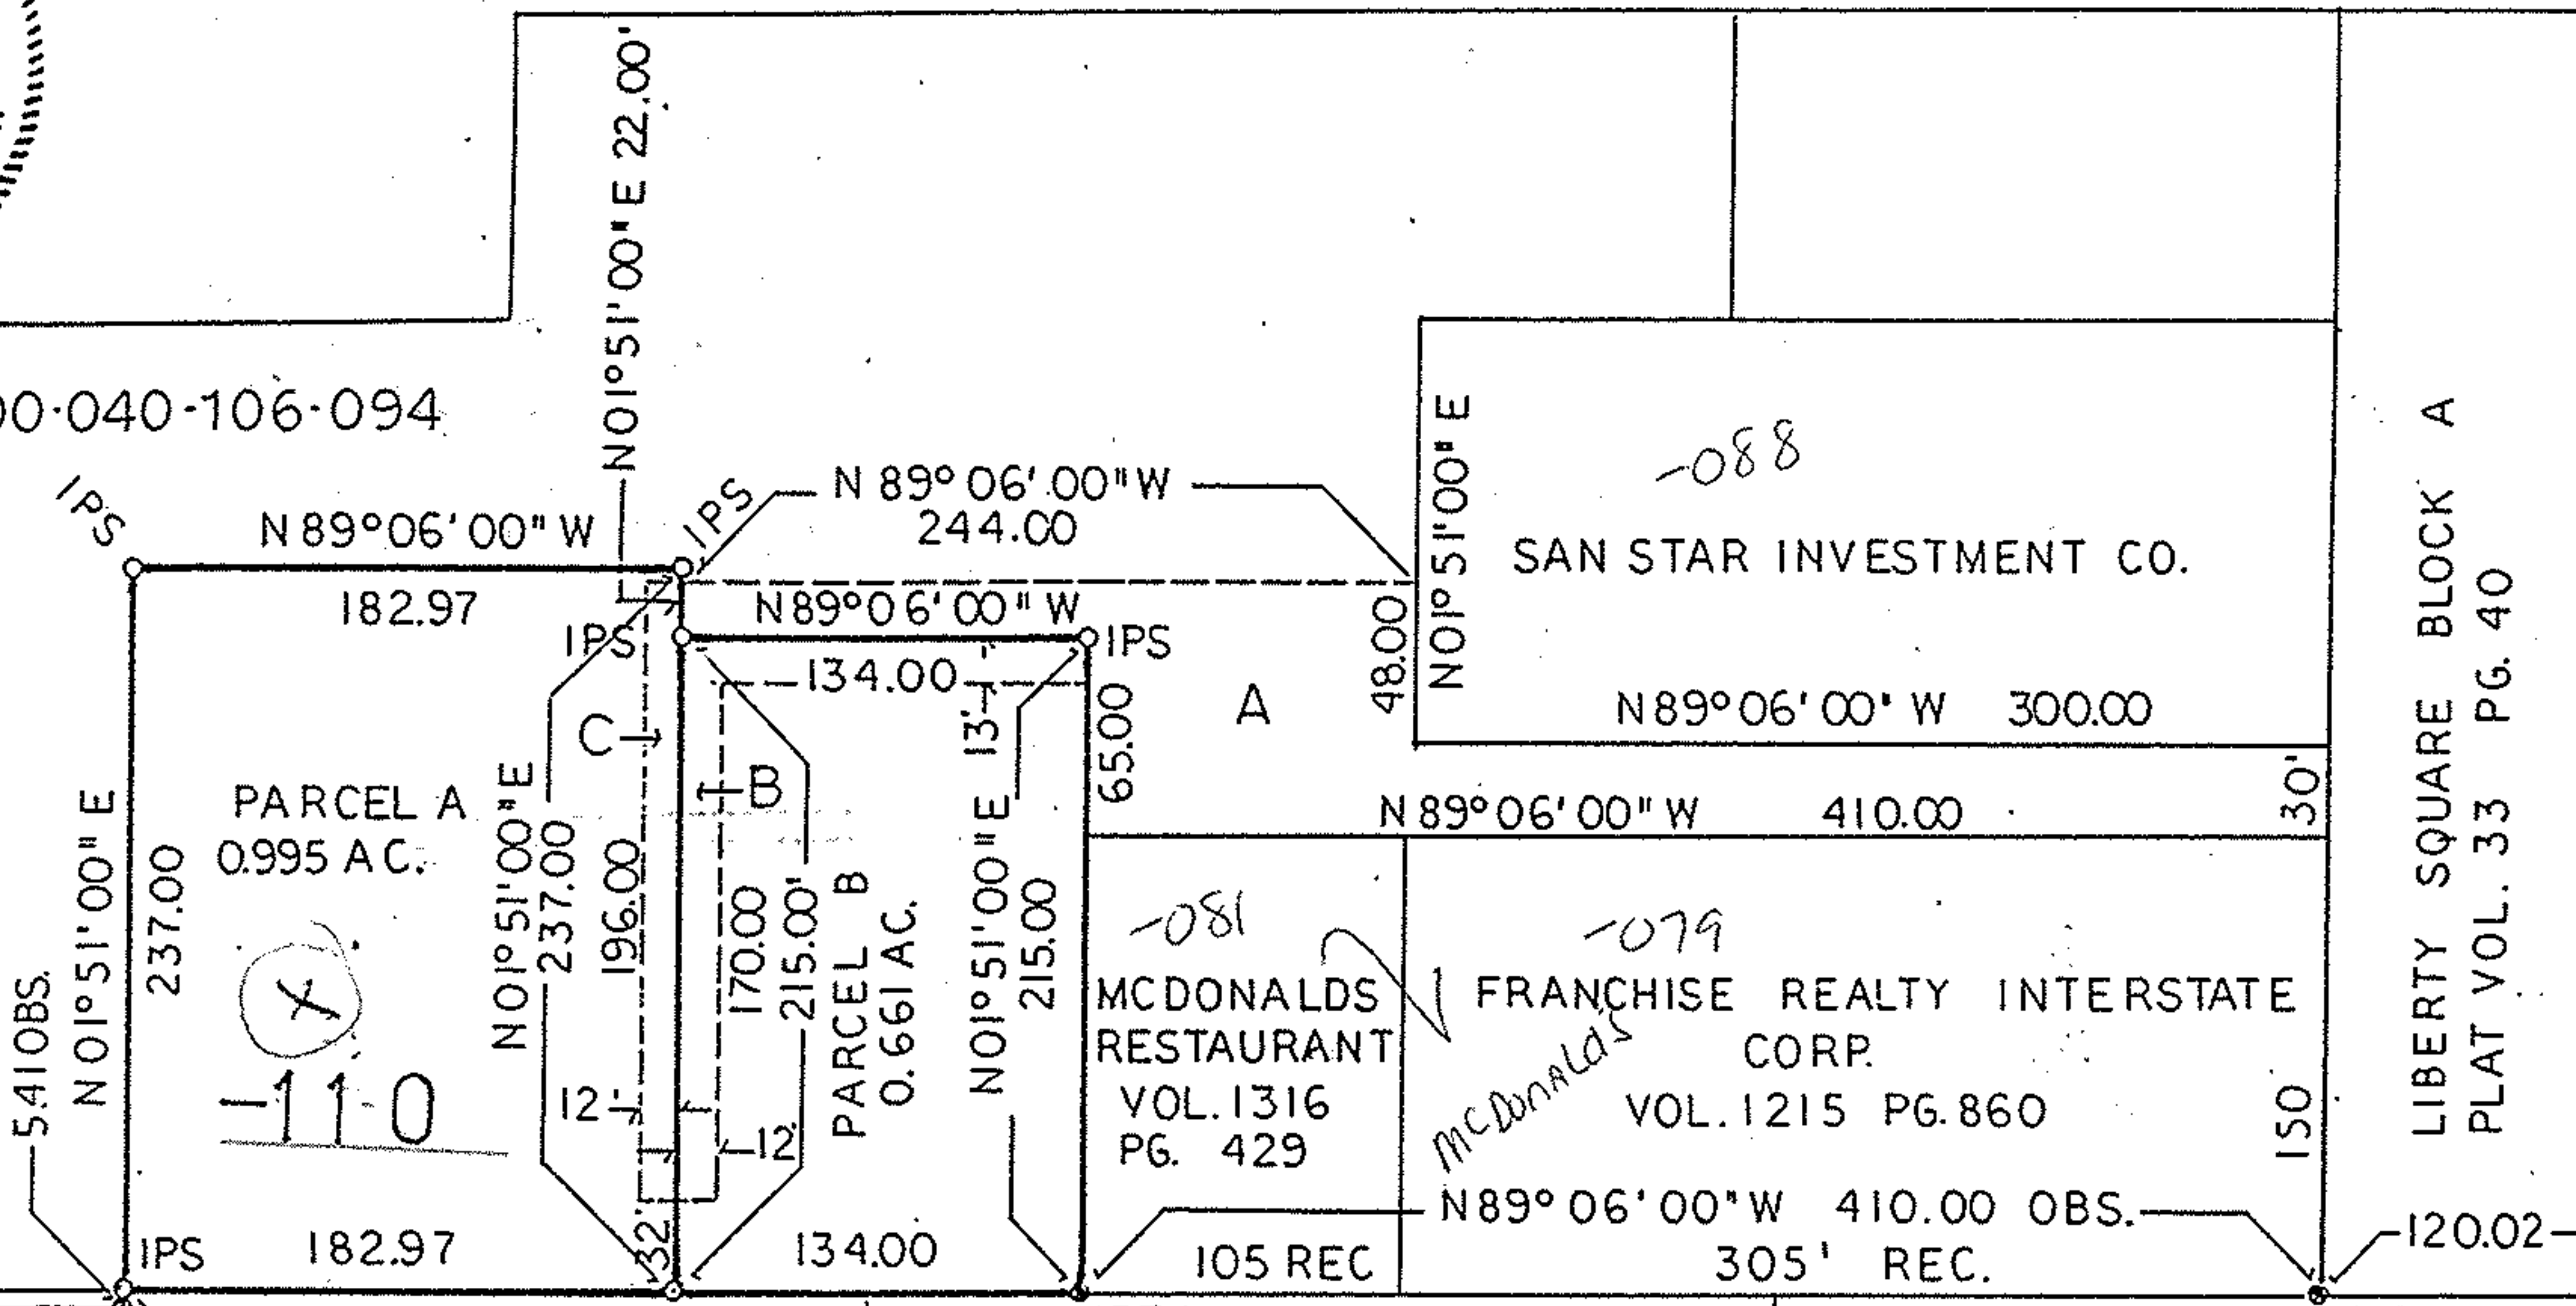

LEAVITT ROAD

Norman r. hura assoc.

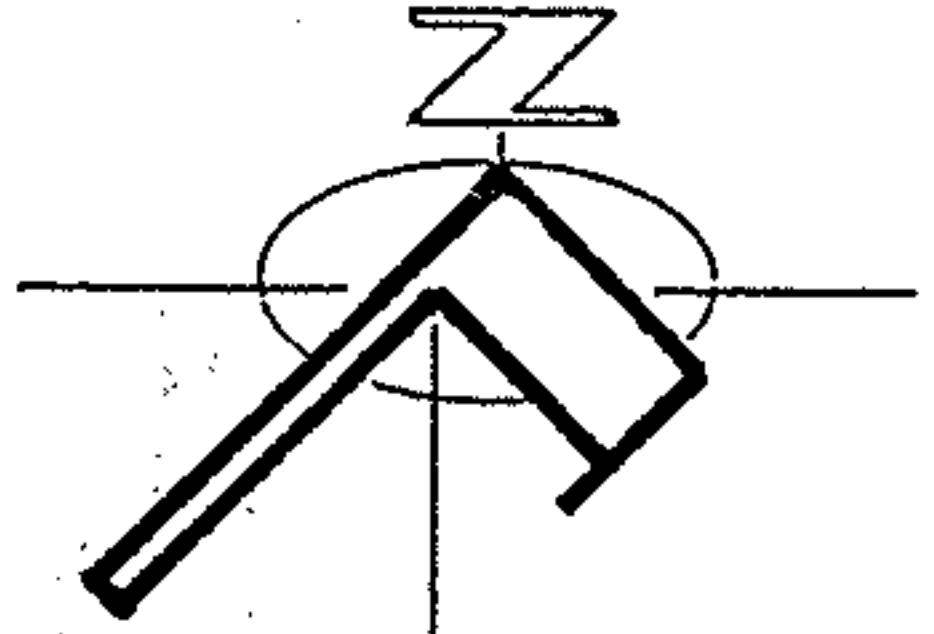

DRIVE

34 BLOSSOM SUB. NO. 2 PG 27-28
35 CHERRY VOL. 45
36

DISCOUNT DRUG MART INC. ORV 0478 PG.0698

KENT N. & GERTRUDE B. SUTTON ORV 0512 PG.0512

MCDONALDS RESTAURANT VOL.1316 PG. 429
FRANCHISE REALTY INTERSTATE CORP. VOL.1215 PG.860

LIBERTY SQUARE BLOCK A PLAT VOL. 33 PG. 40

PLAT OF LOT SPLIT

PART OF ORIGINAL LOT NO. 40 OF AMHERST TOWNSHIP CITY OF AMHERST LORAIN COUNTY - OHIO - SCALE 1" 100' - MAR 1993

20446
APPROVED
LORAIN CO.
MAP DEPT.
DATE 7-16-93
PAGE 5-00-040-B
BY CAROLYN FRANCIS
VOID # 20446

IPF - IRON PIN FD
IPFU - IRON PIN FD. USED
IPS - IRON PIN SET
ABC - PROPOSED EASEMENTS