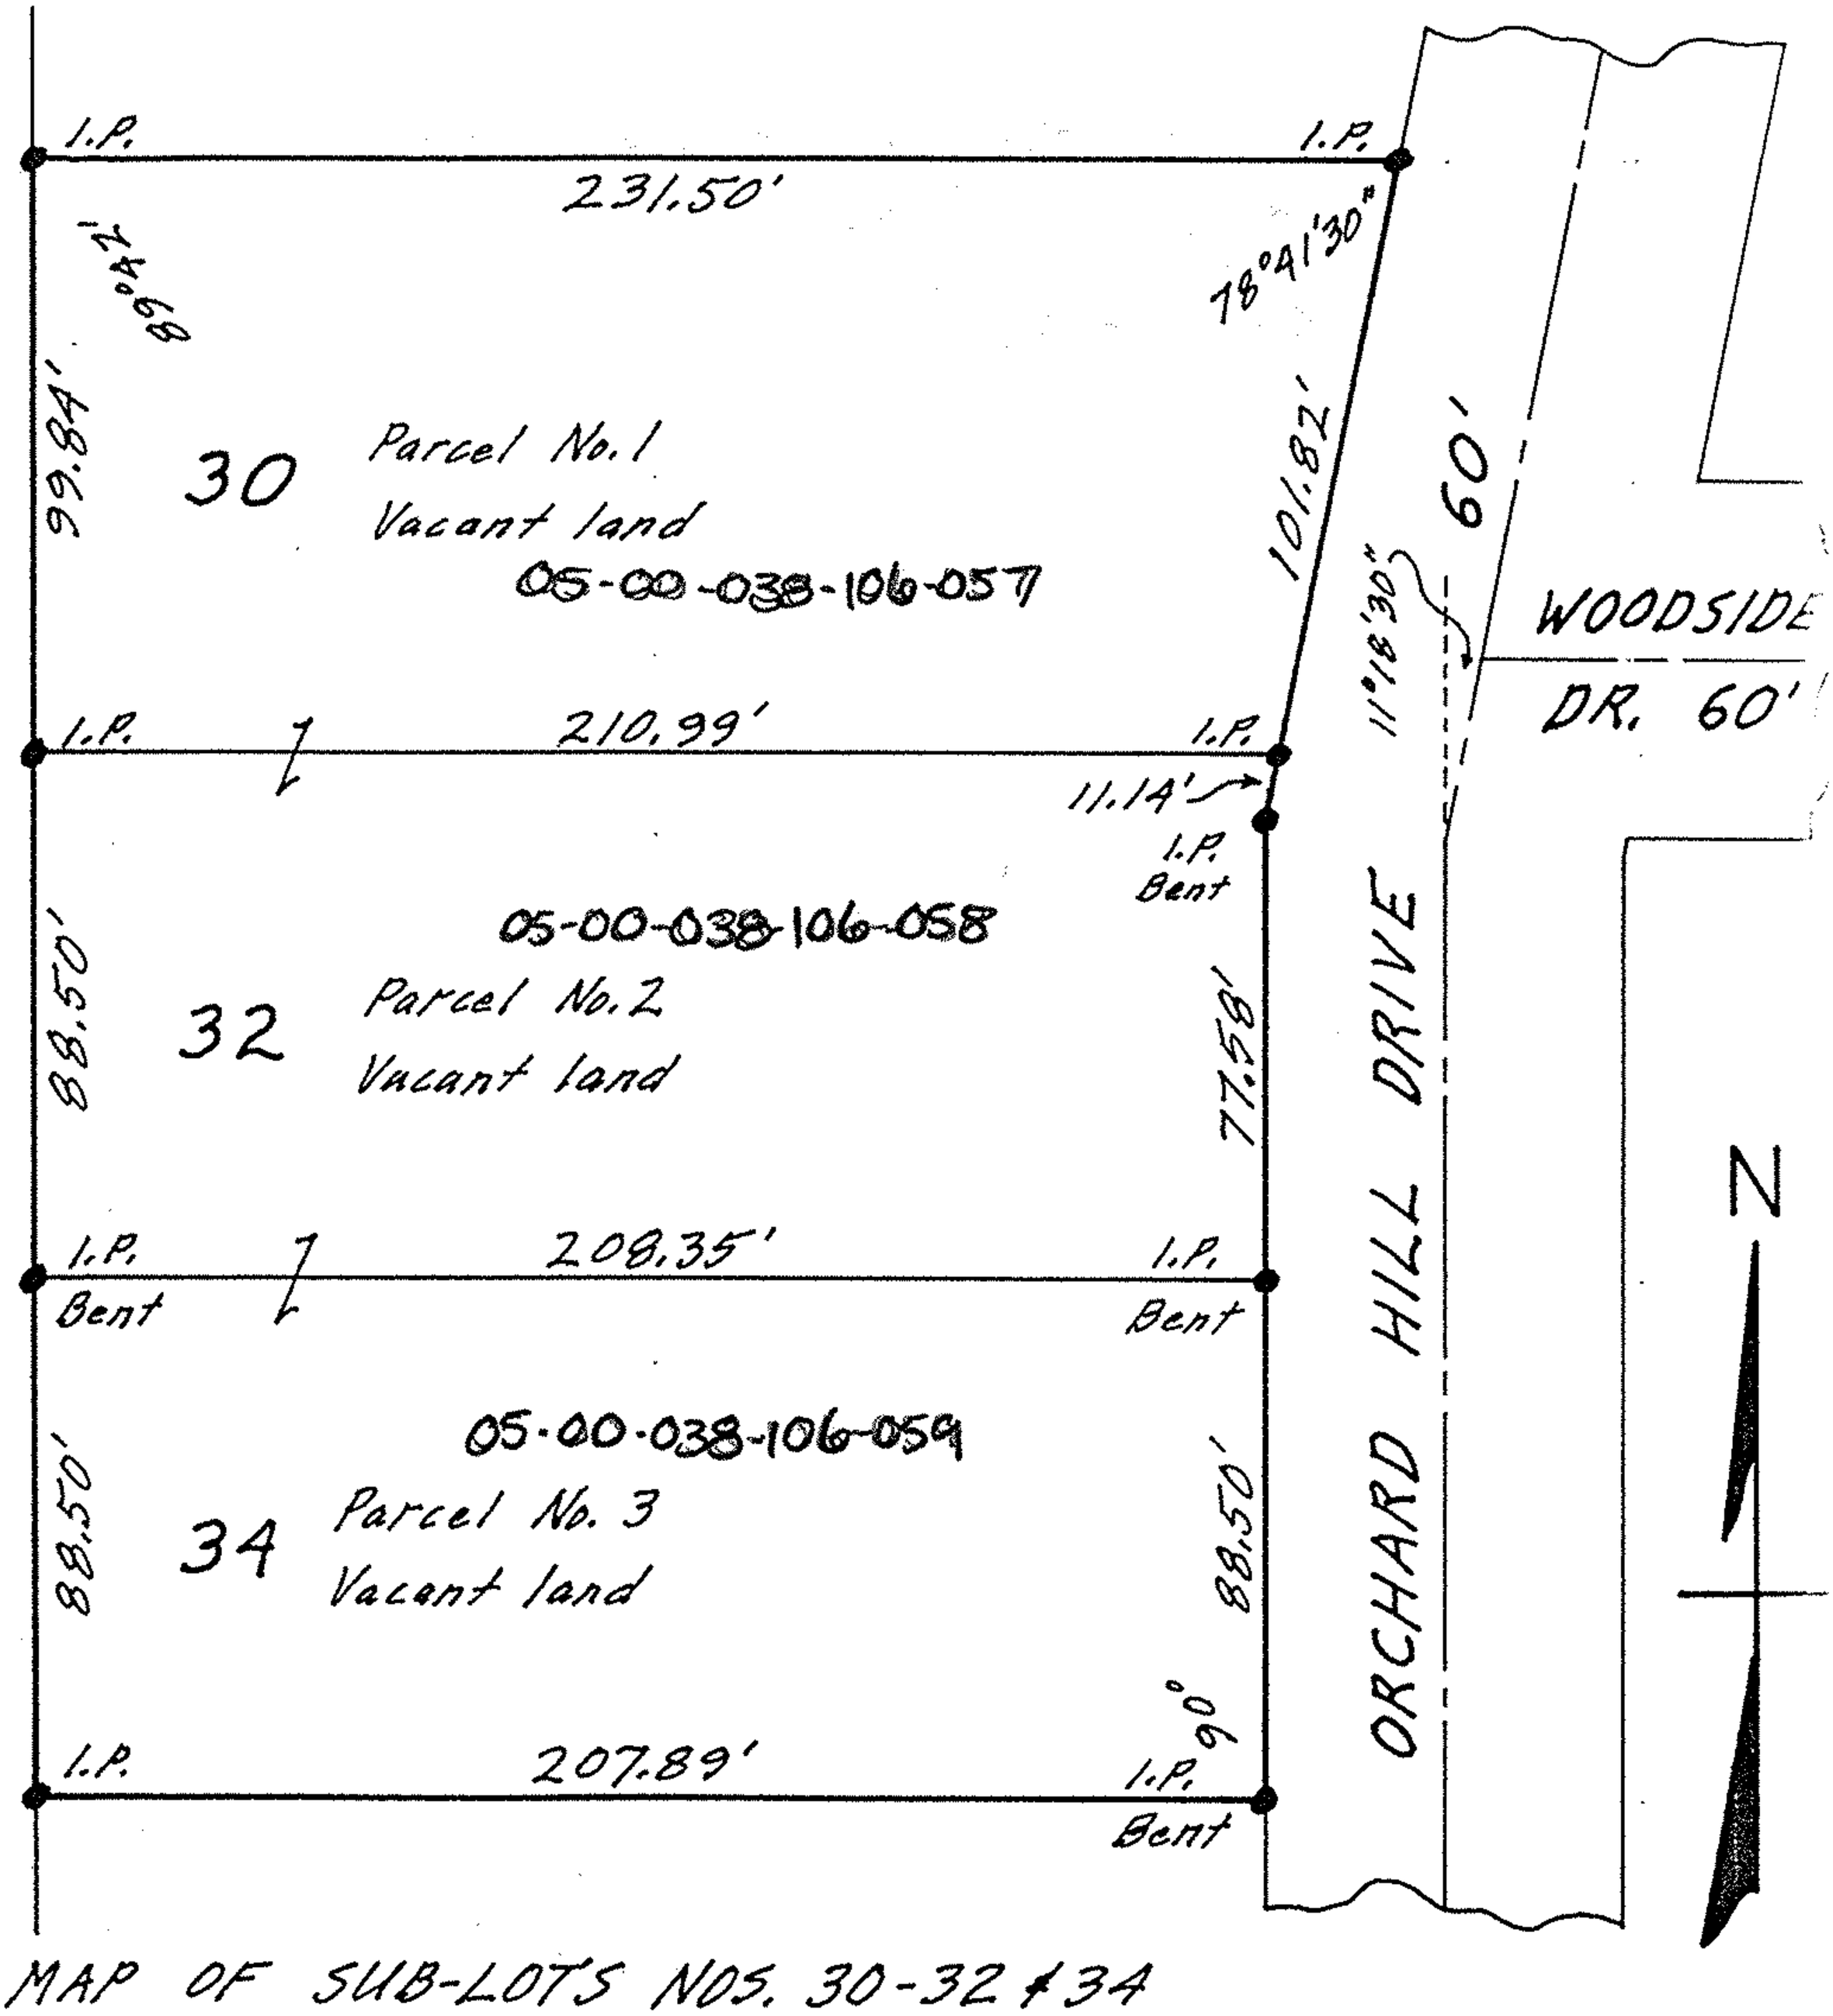

MAP OF SUB-LOTS NOS. 30-32 & 34
RICE ALL'T. SECOND ADD'N. VOL. 21 PG. 38
ORIG. LOT 38 AMHERST TWP. - AMHERST CITY
LORAIN COUNTY - OHIO
SCALE: 1" = 40' AUG. 4 - 1968 1:15 P.M.
Gary E. Penfound REG. SURVEYOR
Nicholas P. & Louise M. Restifo

P.C.