KLEINOEDER · SCHMIDT and ASSOCIATES

ENGINEERS — SURVEYORS — CONSULTANTS in LAND PLANNING

ELYRIA · NORWALK · MEDINA OHIO

SURVEY

Sublot(s) _____

Subd'n _____

Township AMHERST

Orig. Lot(s) 37

County of LORAIN

Corporation CITY OF AMHERST

Tract _____

Sec. _____

State of Ohio

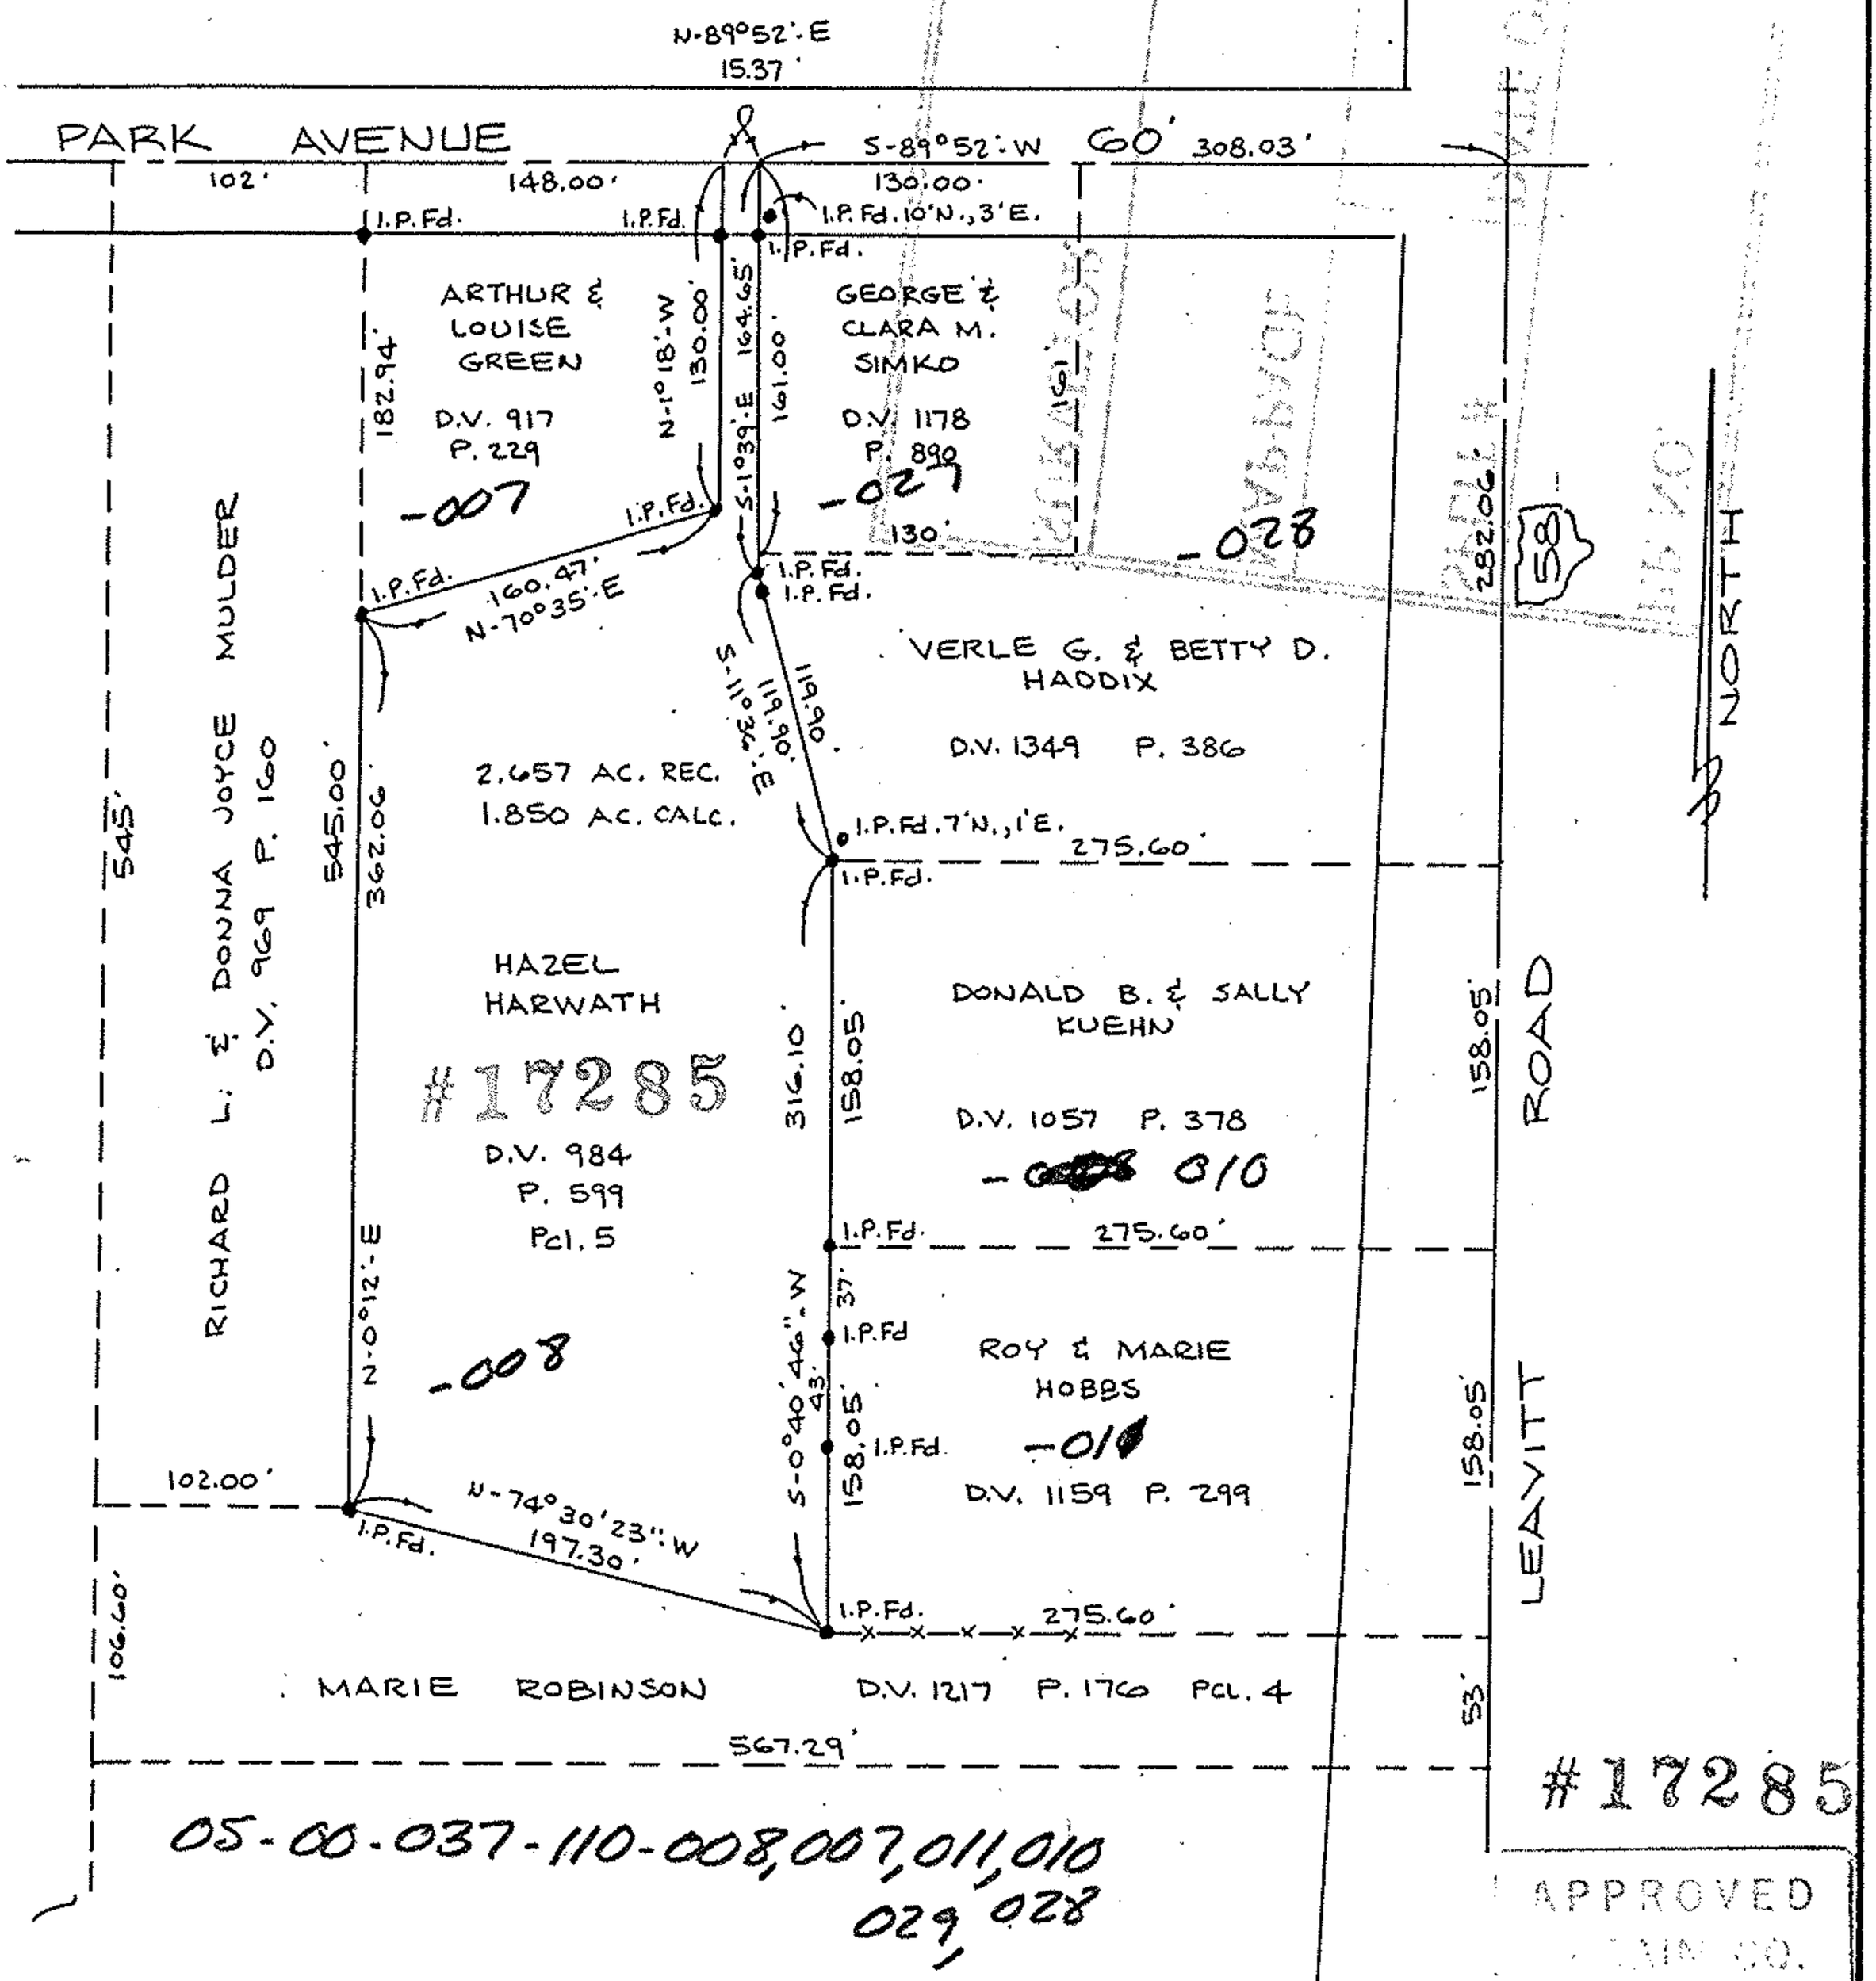

05-00-037-110-008,007,011,010
029, 028

APPROVED
COUNTY CO.
DATE 2-24-87
PAGE 5-00037
BY C. FRANCIS
VOID AFTER 17285

-037-B

Prepared for: 05-00-037-110-008

Scale: 1" = 100'	Date: 2-10-87	Dr. by: D.E.	Job № 87-16

05-00-037-110

05-00-037-B

17285