5-00-059-A  # 15415  05-00-059-103

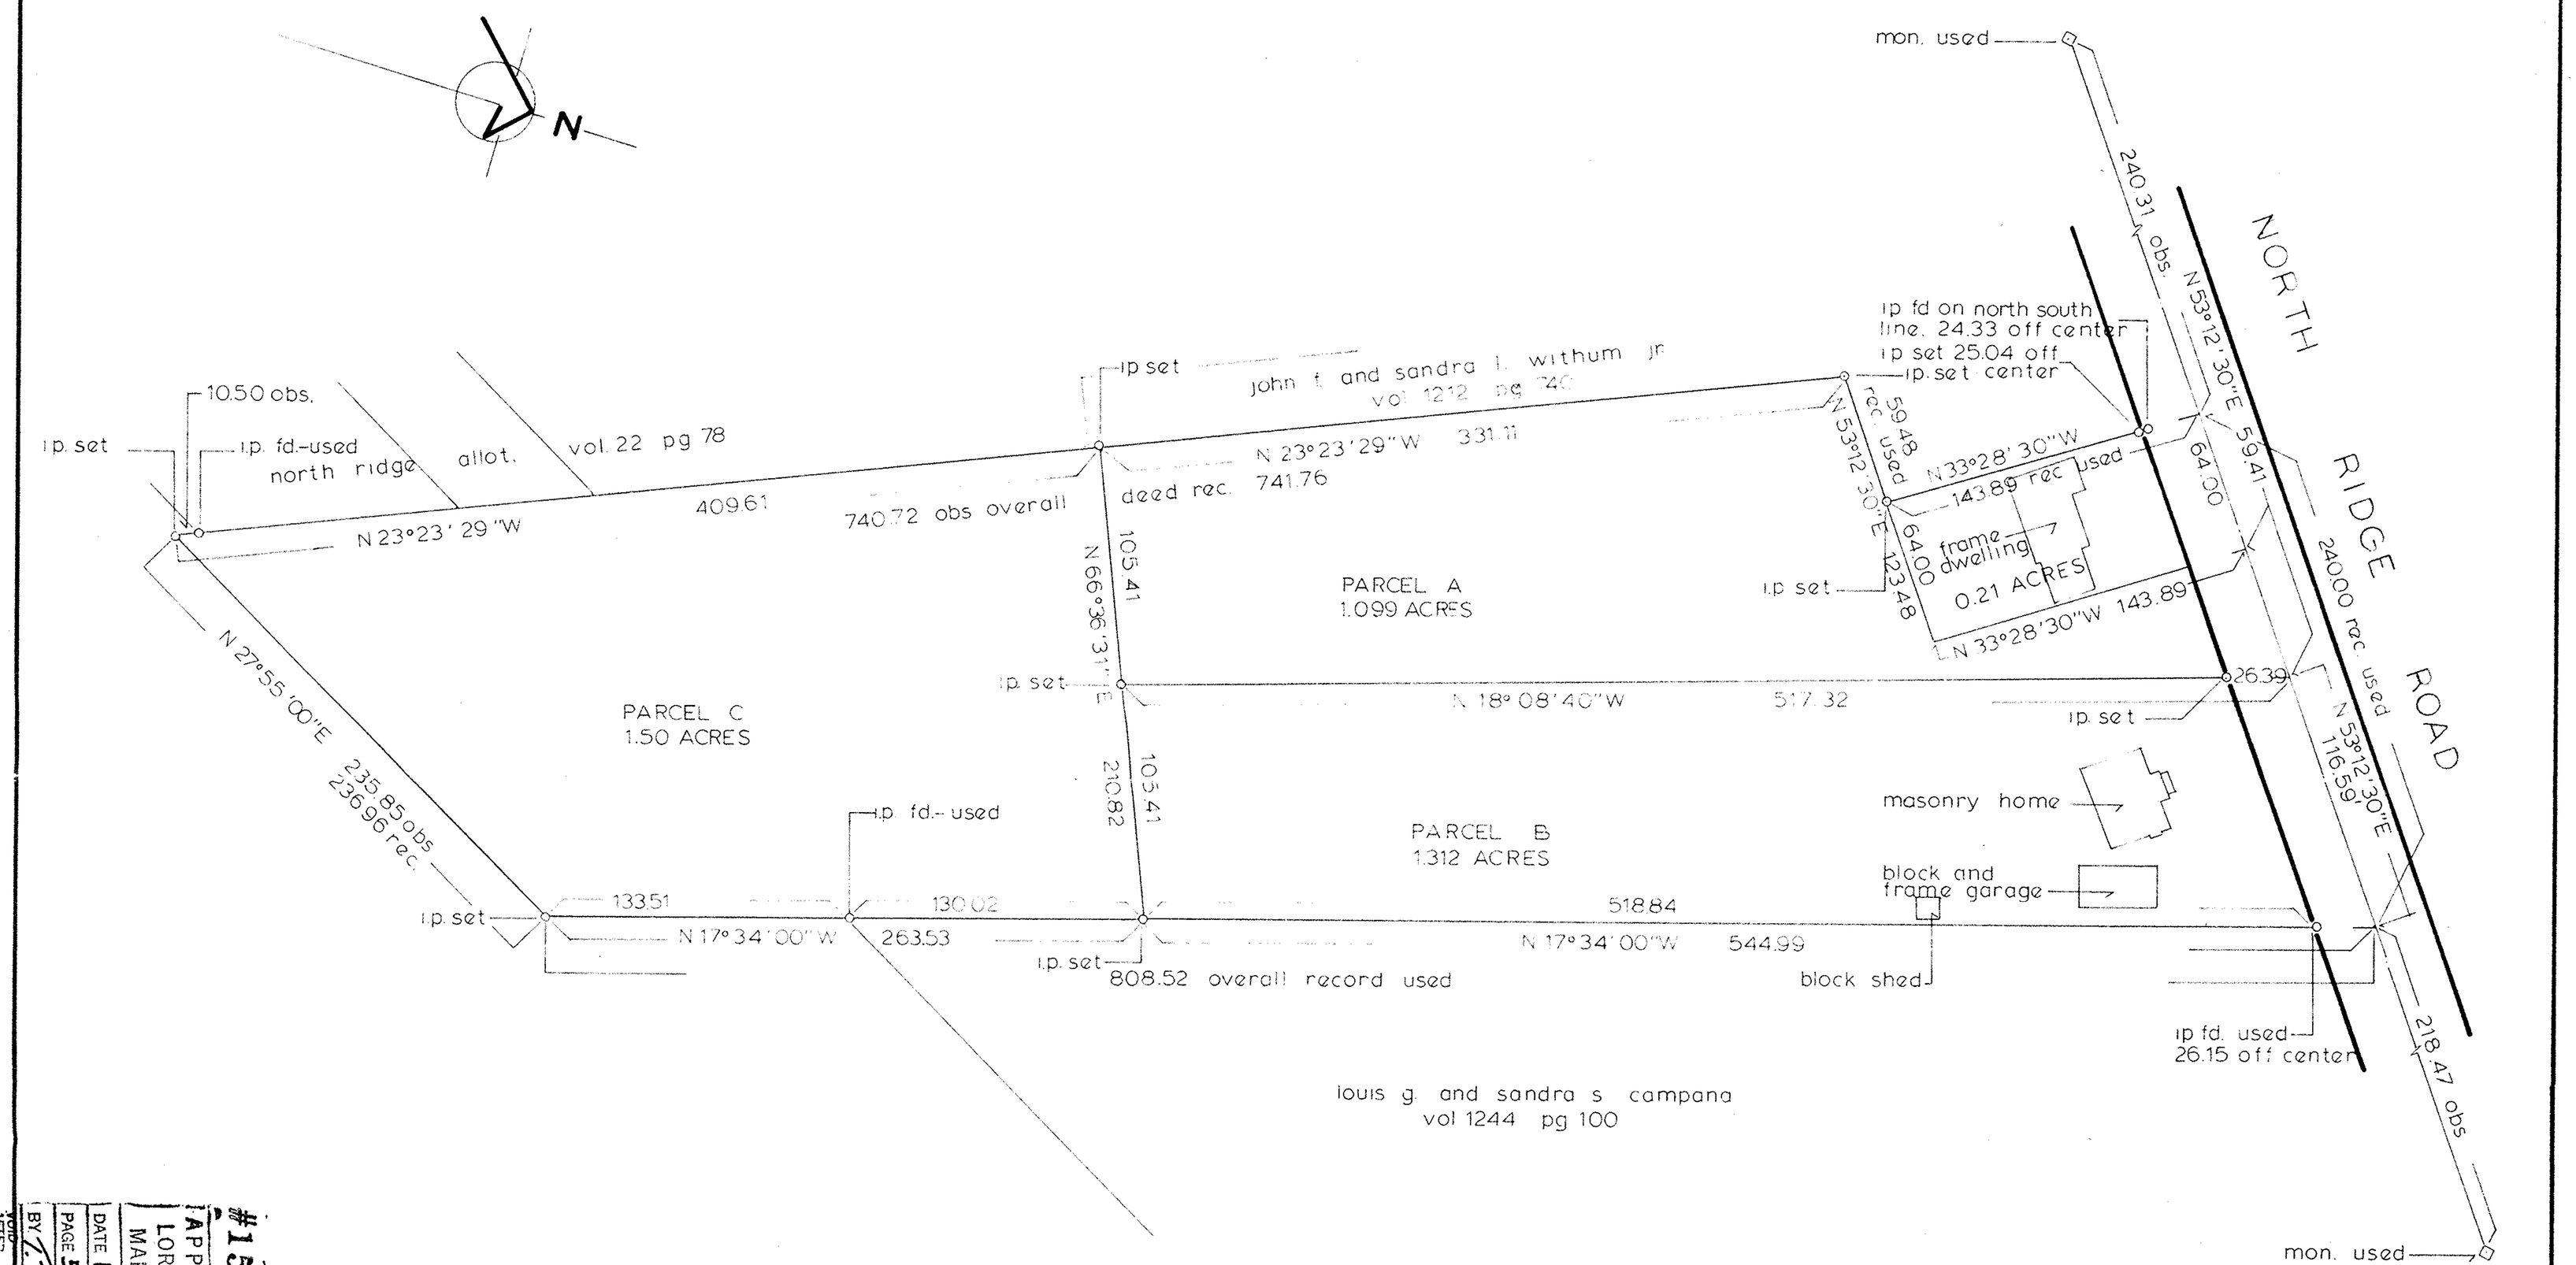


#15415

APPROVED
LORAIN CO.
MAP DEPT.
DATE 1-6-84
PAGE 5:00.059.A
BY T. McNair

SPLIT OF PARCEL 2 OF LANDS CONVEYED TO ANGELA INGRASSIA
VOL 1255 PG. 1

norman r hura — registered surveyor

05-00-057-103-021,020,019,016

| | | |
|---|---|---|
| ANGELA INGRASSIA<br>1255/1 | OUTLINE SURVEY AND LOT SPLIT | ORIGINAL LOT NO. 59 AMHERST TWP<br>LORAIN COUNTY OHIO<br>SCALE 1" = 50' NOV. 1983 |

STATE OF OHIO
N.R. HURA
S-6205
REGISTERED SURVEYOR

05-00-057-103  # 15415  5-00-059-A