P.P. No
05-00-054.000.034,035

SURVEYOR	MAP PROOF	STATE OF OHIO
Split 12261	Map page 5-G	Schmidt

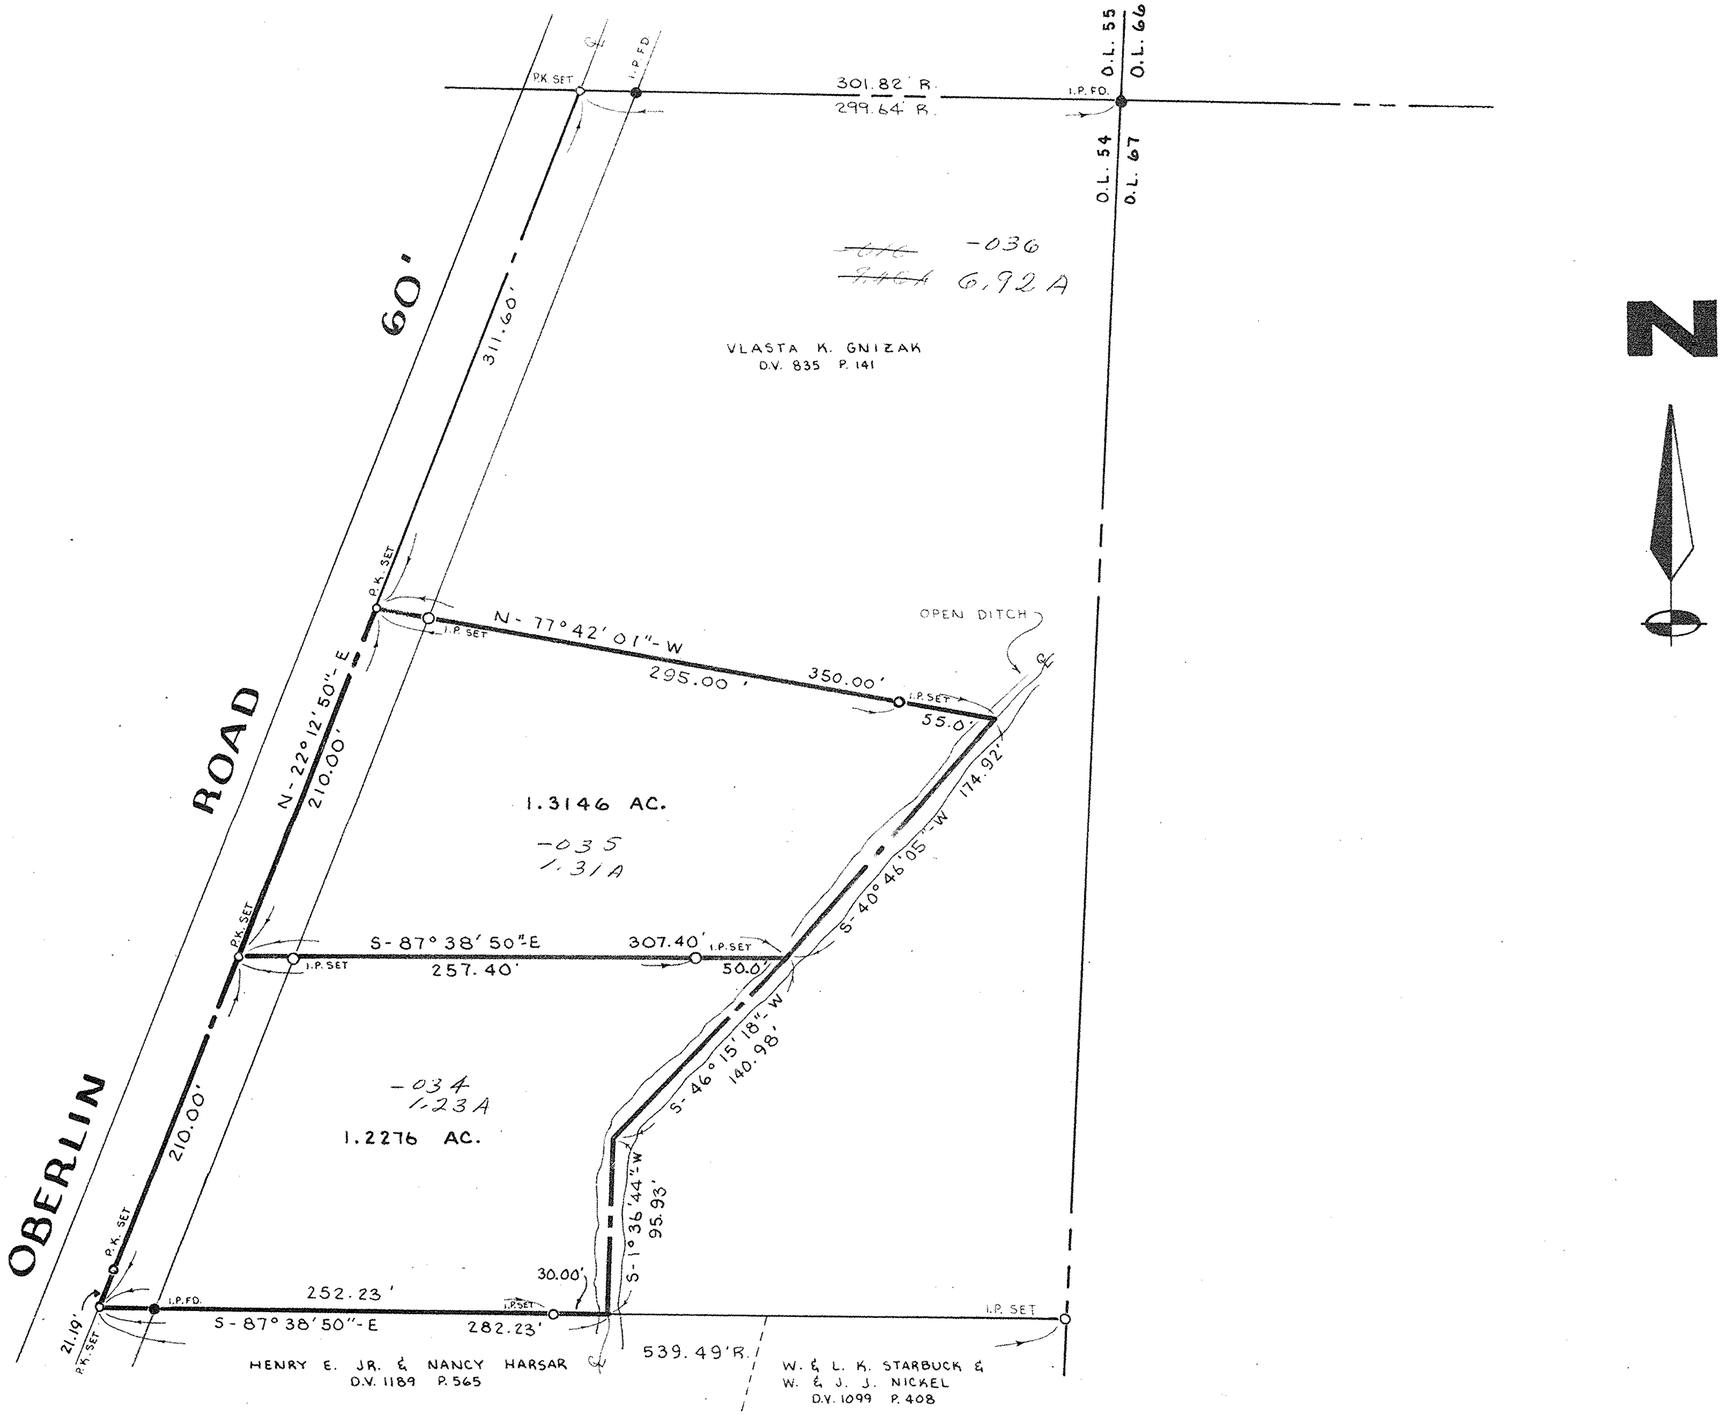

#12261

APPROVED
LORAIN CO.
MAP DEPT.
DATE 11-20-78
PAGE 5-G
BY Carolyn F.
VOID AFTER 12261

PROJECT

SURVEY MAP

OF PART OF

ORIGINAL AMHERST TOWNSHIP LOT NO. 54
TWP. OF AMHERST COUNTY OF LORAIN
STATE OF OHIO

Prepared for:

MR. FRANK JANEZIC

Rev.

Drawn by: P. M.
Checked by:
App. by:
Scale: 1" = 60'
Date: 11-15-78

KLEINOEDER · SCHMIDT and ASSOCIATES

ENGINEERS — SURVEYORS — CONSULTANTS in LAND PLANNING

ELYRIA - NORWALK - MEDINA OHIO

REFERENCES

SHEET NO. ___ of ___

JOB NO. 78-303