TYPICAL LOT NO SCALE

NOTES:

I. Drainage
1. Thru easement to the French Creek.
2. Detention basin built along East Side French Creek.
3. Detention in rear yards.

II. Sanitary Sewer
1. Main Interceptor on Jaycox Rd.
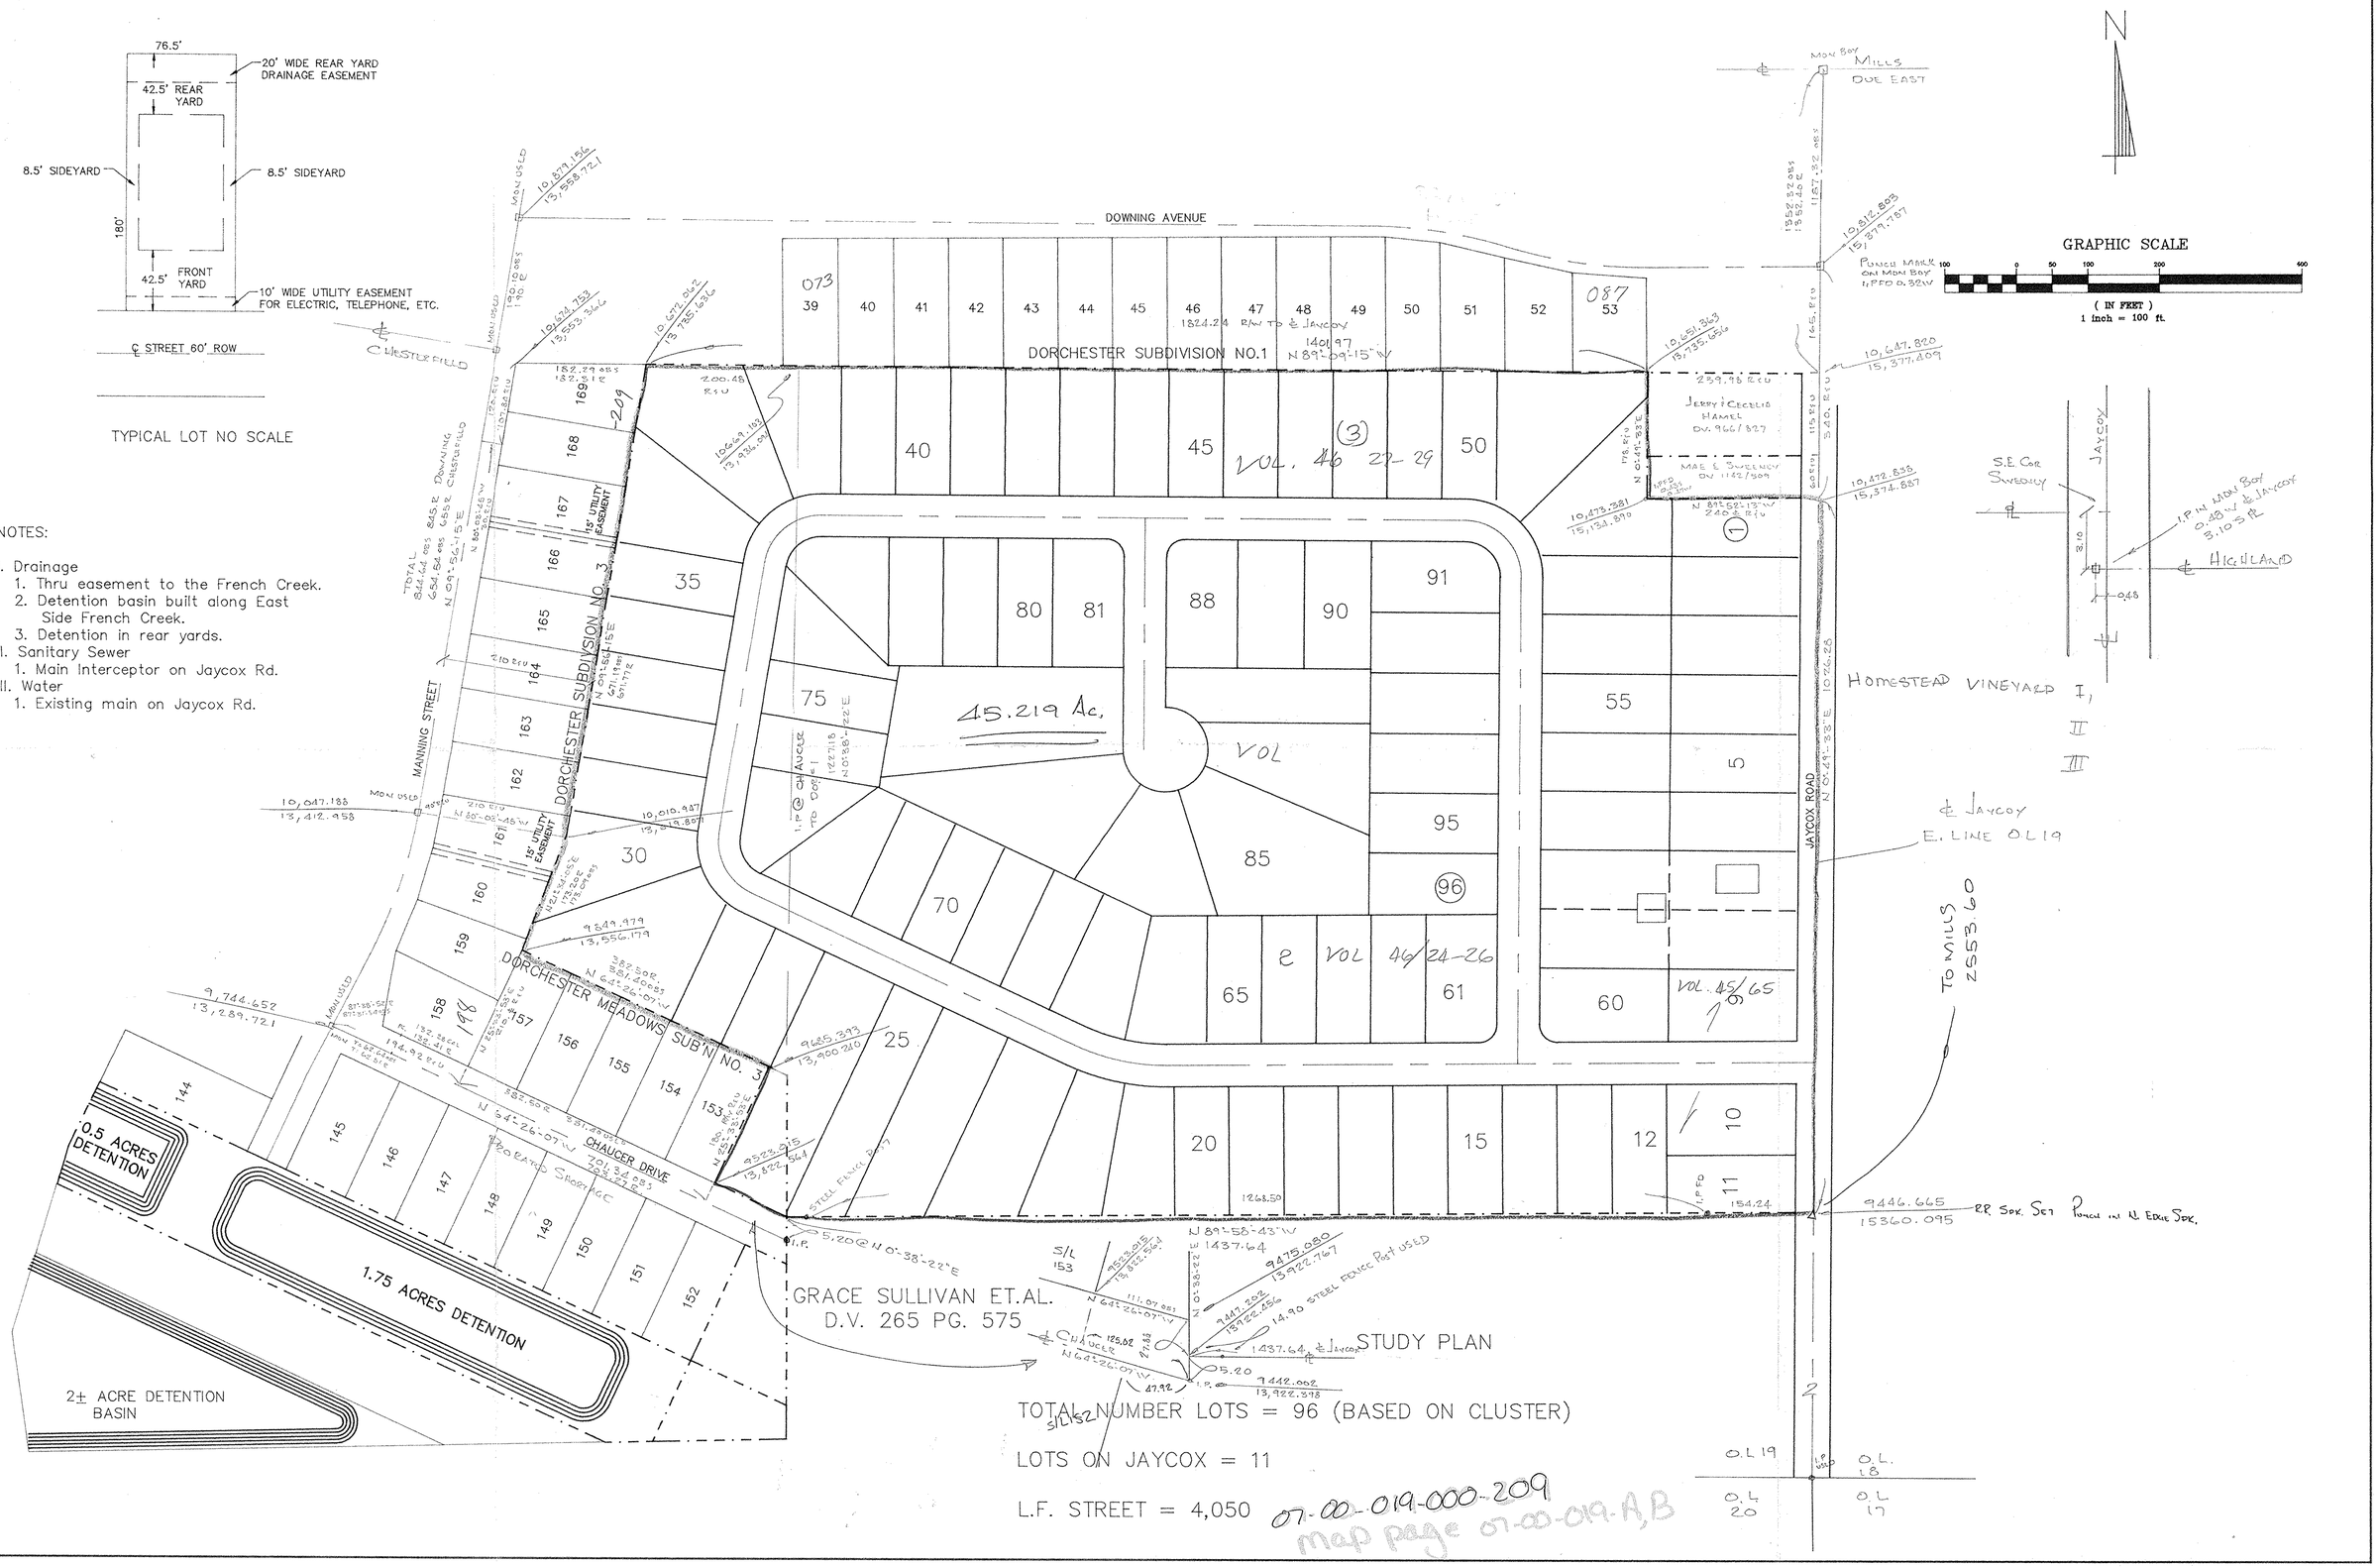
III. Water
1. Existing main on Jaycox Rd.