PLAT OF SURVEY

STATE OF OHIO
COUNTY OF ~~MEDINA~~ LORAIN

PROJECT # 75048
DATE APRIL 1975

TOWNSHIP & VILLAGE, ~~CITY~~ WELLINGTON LOT 28 TRACT

SUBDIVISION WADSWORTH SUBLOT #

PROPERTY OWNER JOSEPH A. & SHARON L. FARAGO
A. B. & BLANCHE JONES

18-00-028-~~009~~ 108

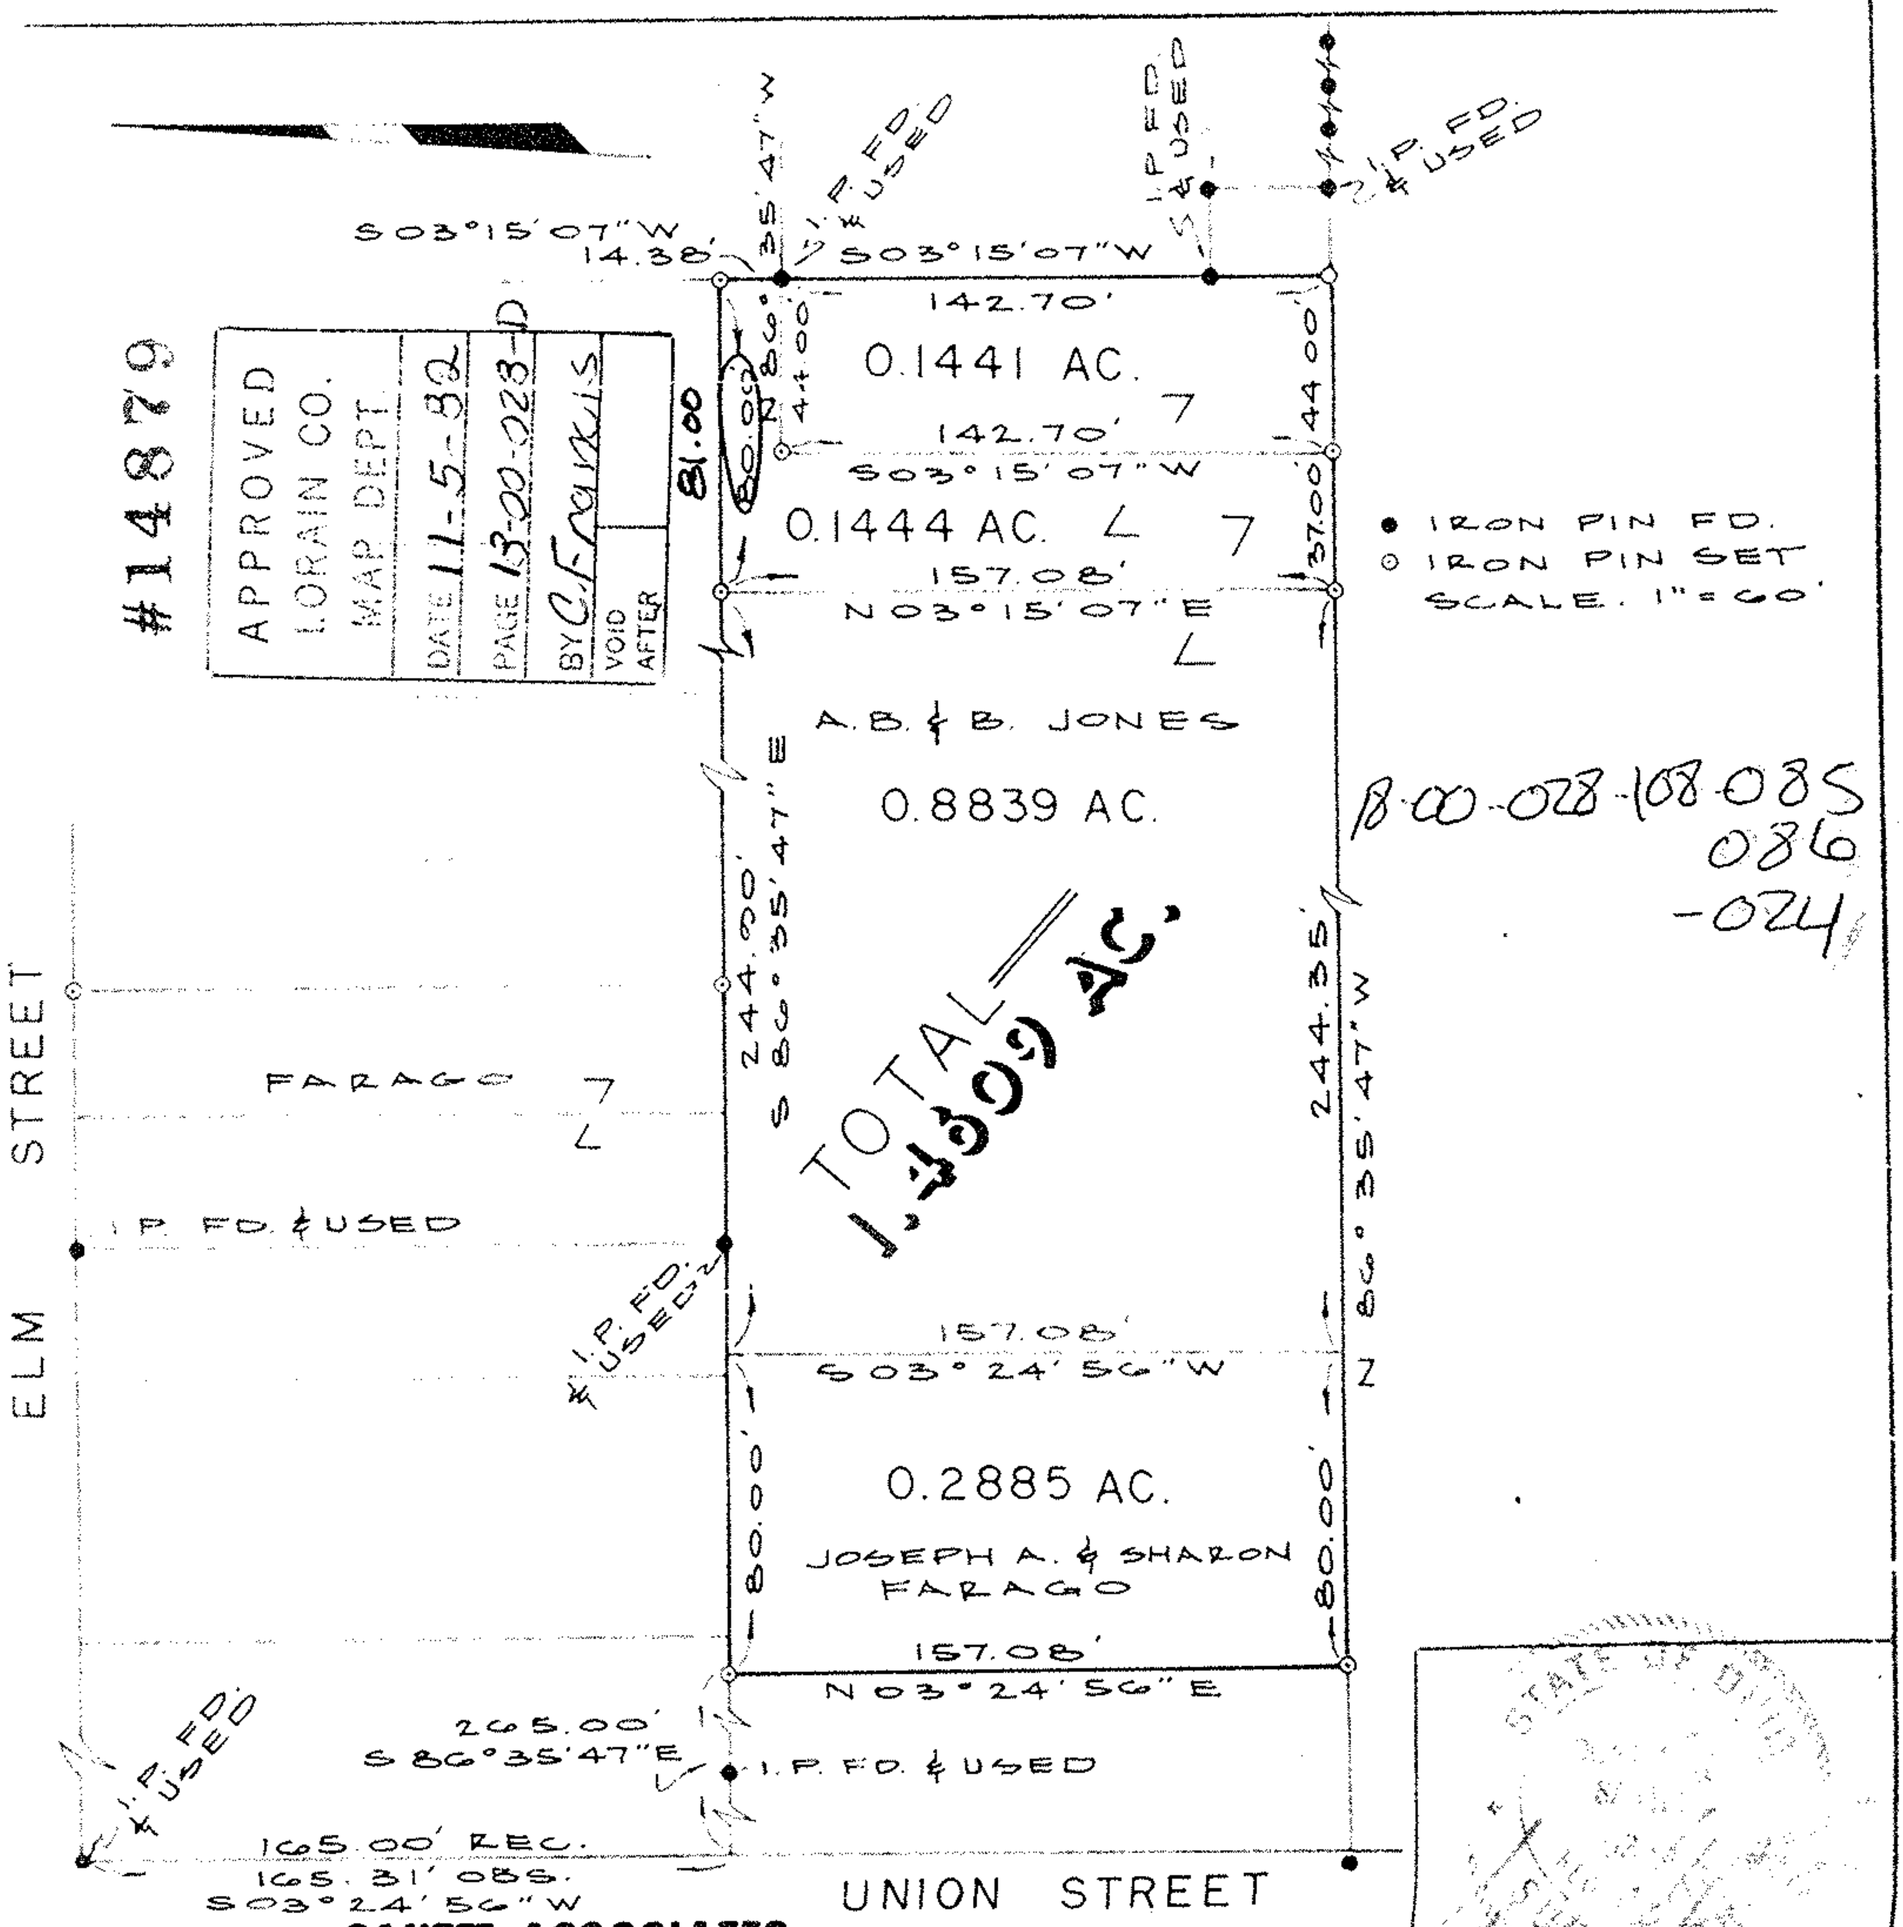

#14879

APPROVED
LORAIN CO.
MAP DEPT.
DATE 11-5-82
PAGE 13-00-028-D
BY C.F. Francis
VOID AFTER

18-00-028-108-085
086
-024

18-00-028-D

SANTEE ASSOCIATES
ENGINEERS SURVEYORS

STATE OF OHIO
Donald F. Santee, P.
Reg. Surveyor #5336