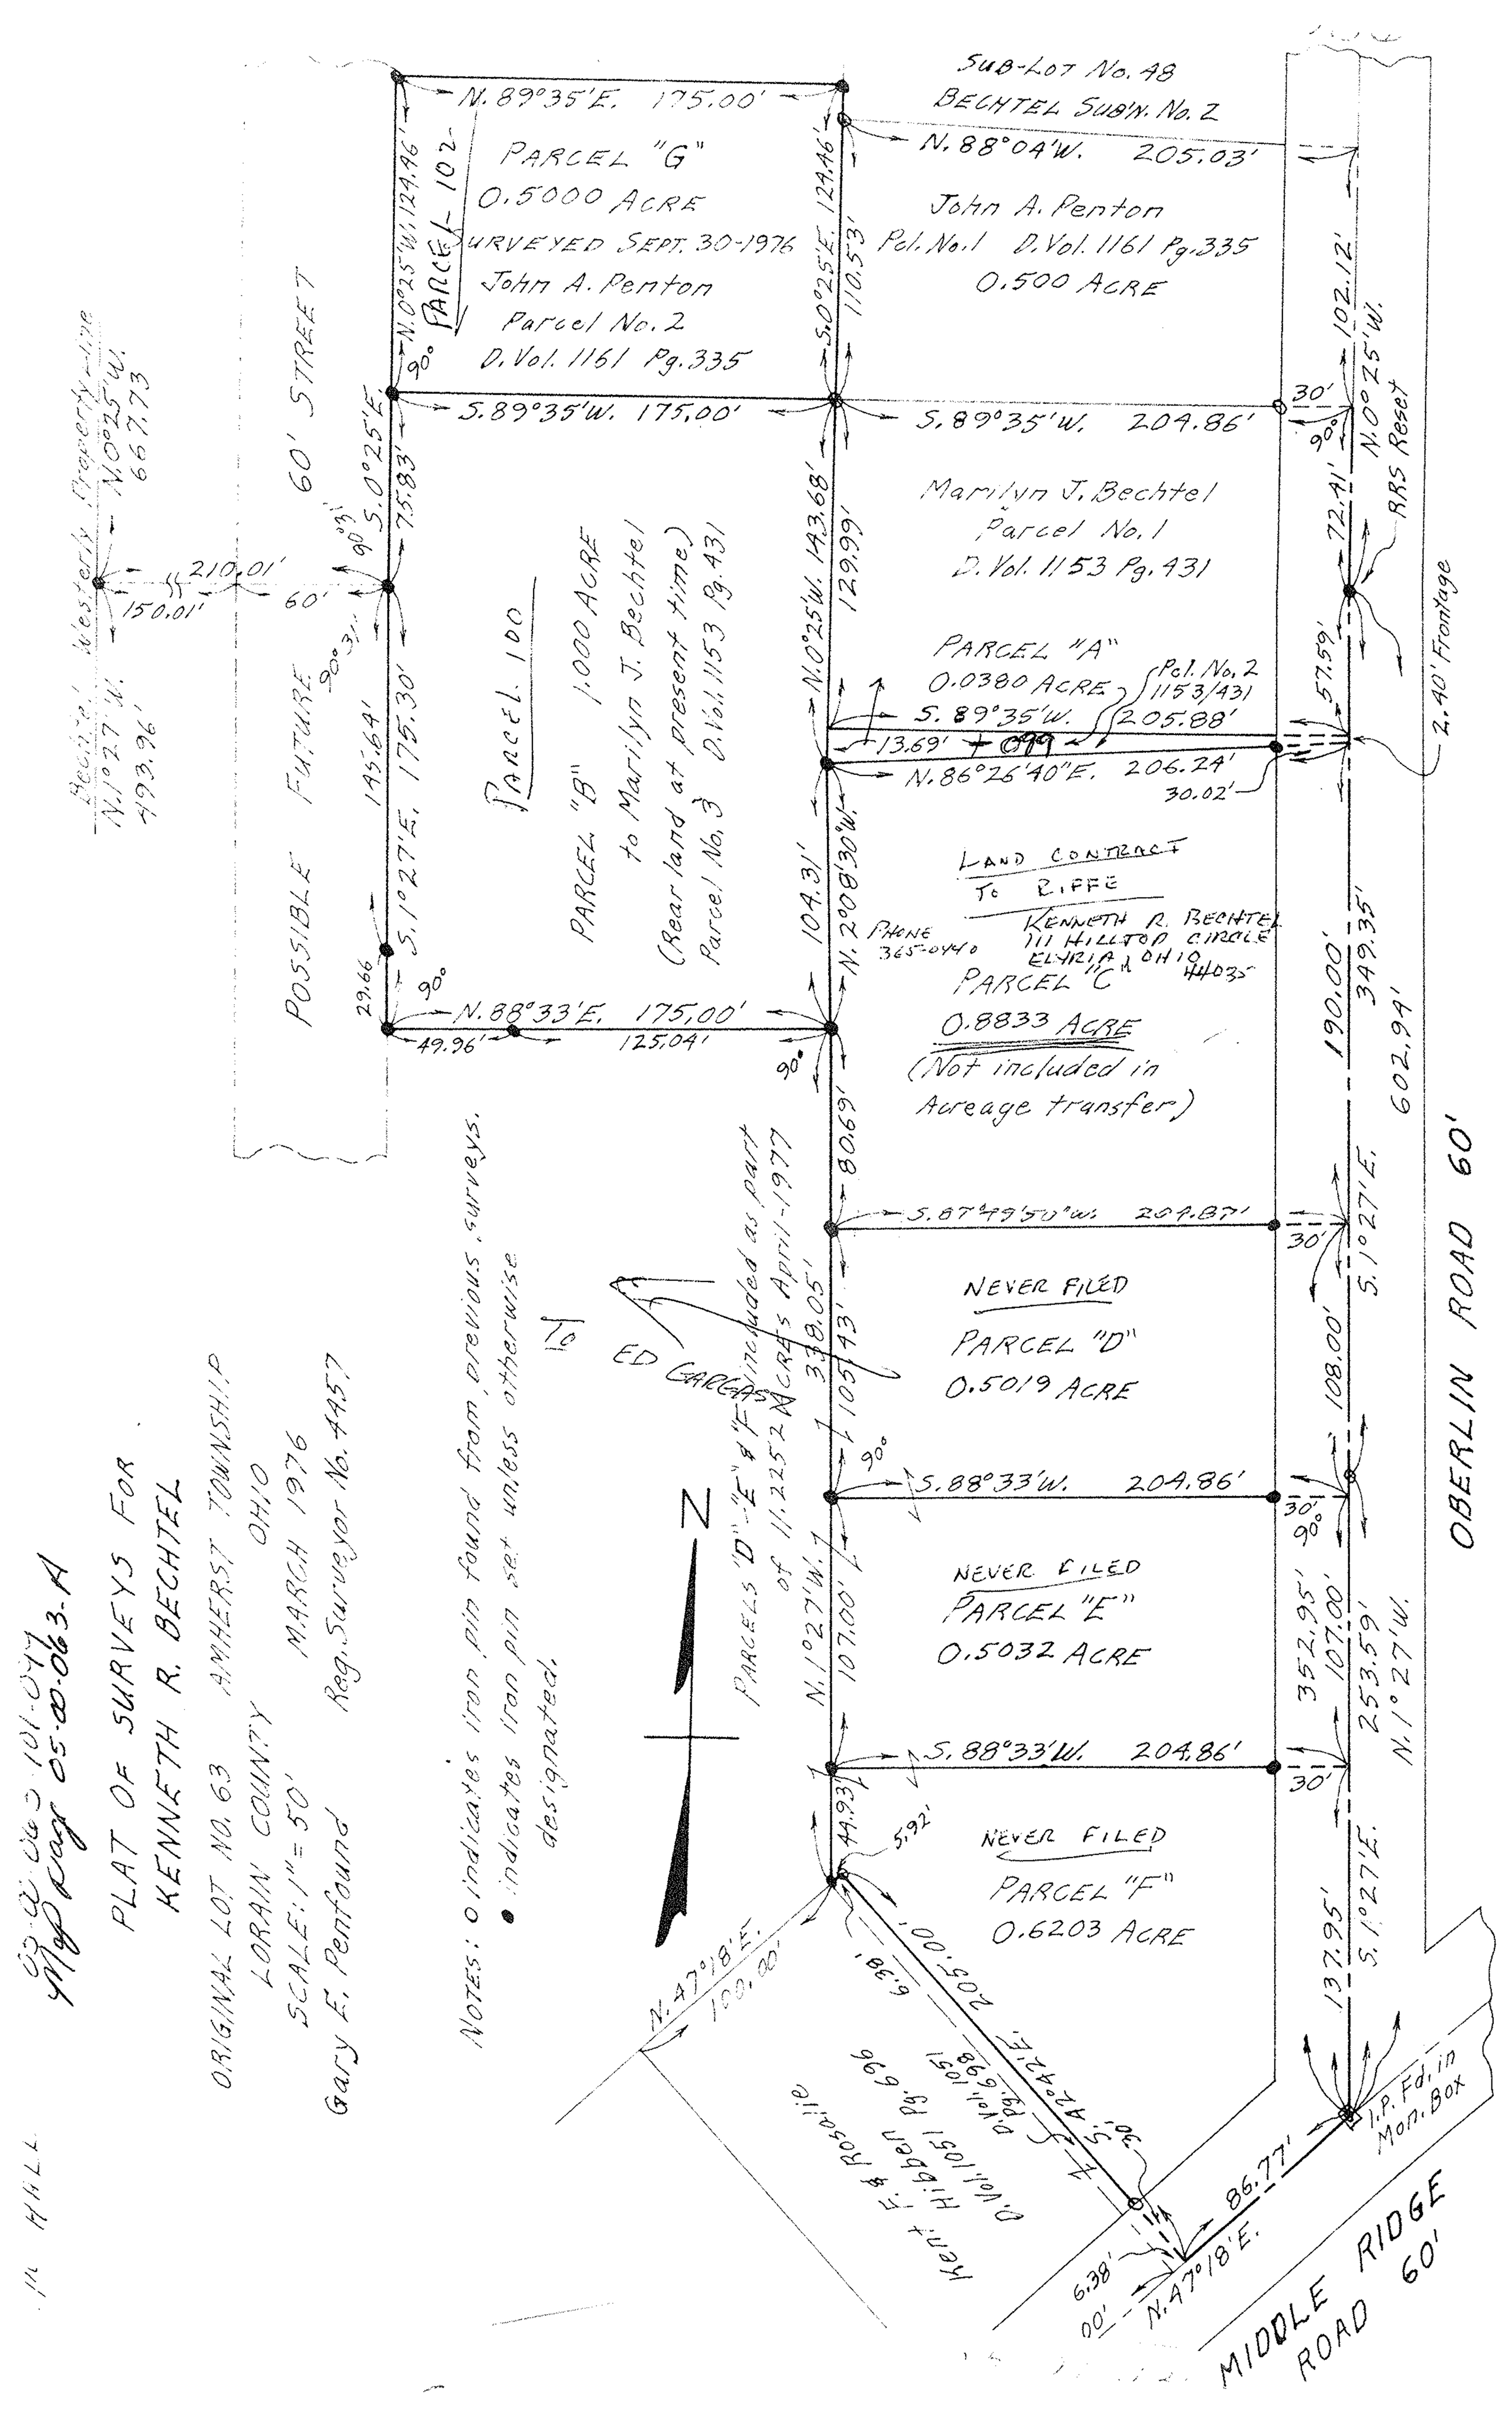

NOTES: o indicates iron pin found from previous surveys.
• indicates iron pin set unless otherwise designated.

PLAT OF SURVEYS FOR
KENNETH R. BECHTEL
ORIGINAL LOT NO. 63
LORAIN COUNTY
AMHERST TOWNSHIP
OHIO
SCALE: 1" = 50'
MARCH 1976
Gary E. Penfound
Reg. Surveyor No. 4457

03-00-063-101-047
Map Page 05-00-063-A

HALL