BOUNDARY SURVEY
FOR

JAMES A. & DIXIE L. RESAR

TOWNSHIP OF AMHERST, COUNTY OF LORAIN, STATE OF OHIO

JULY 7, 1984
SCALE: 1" = 50'

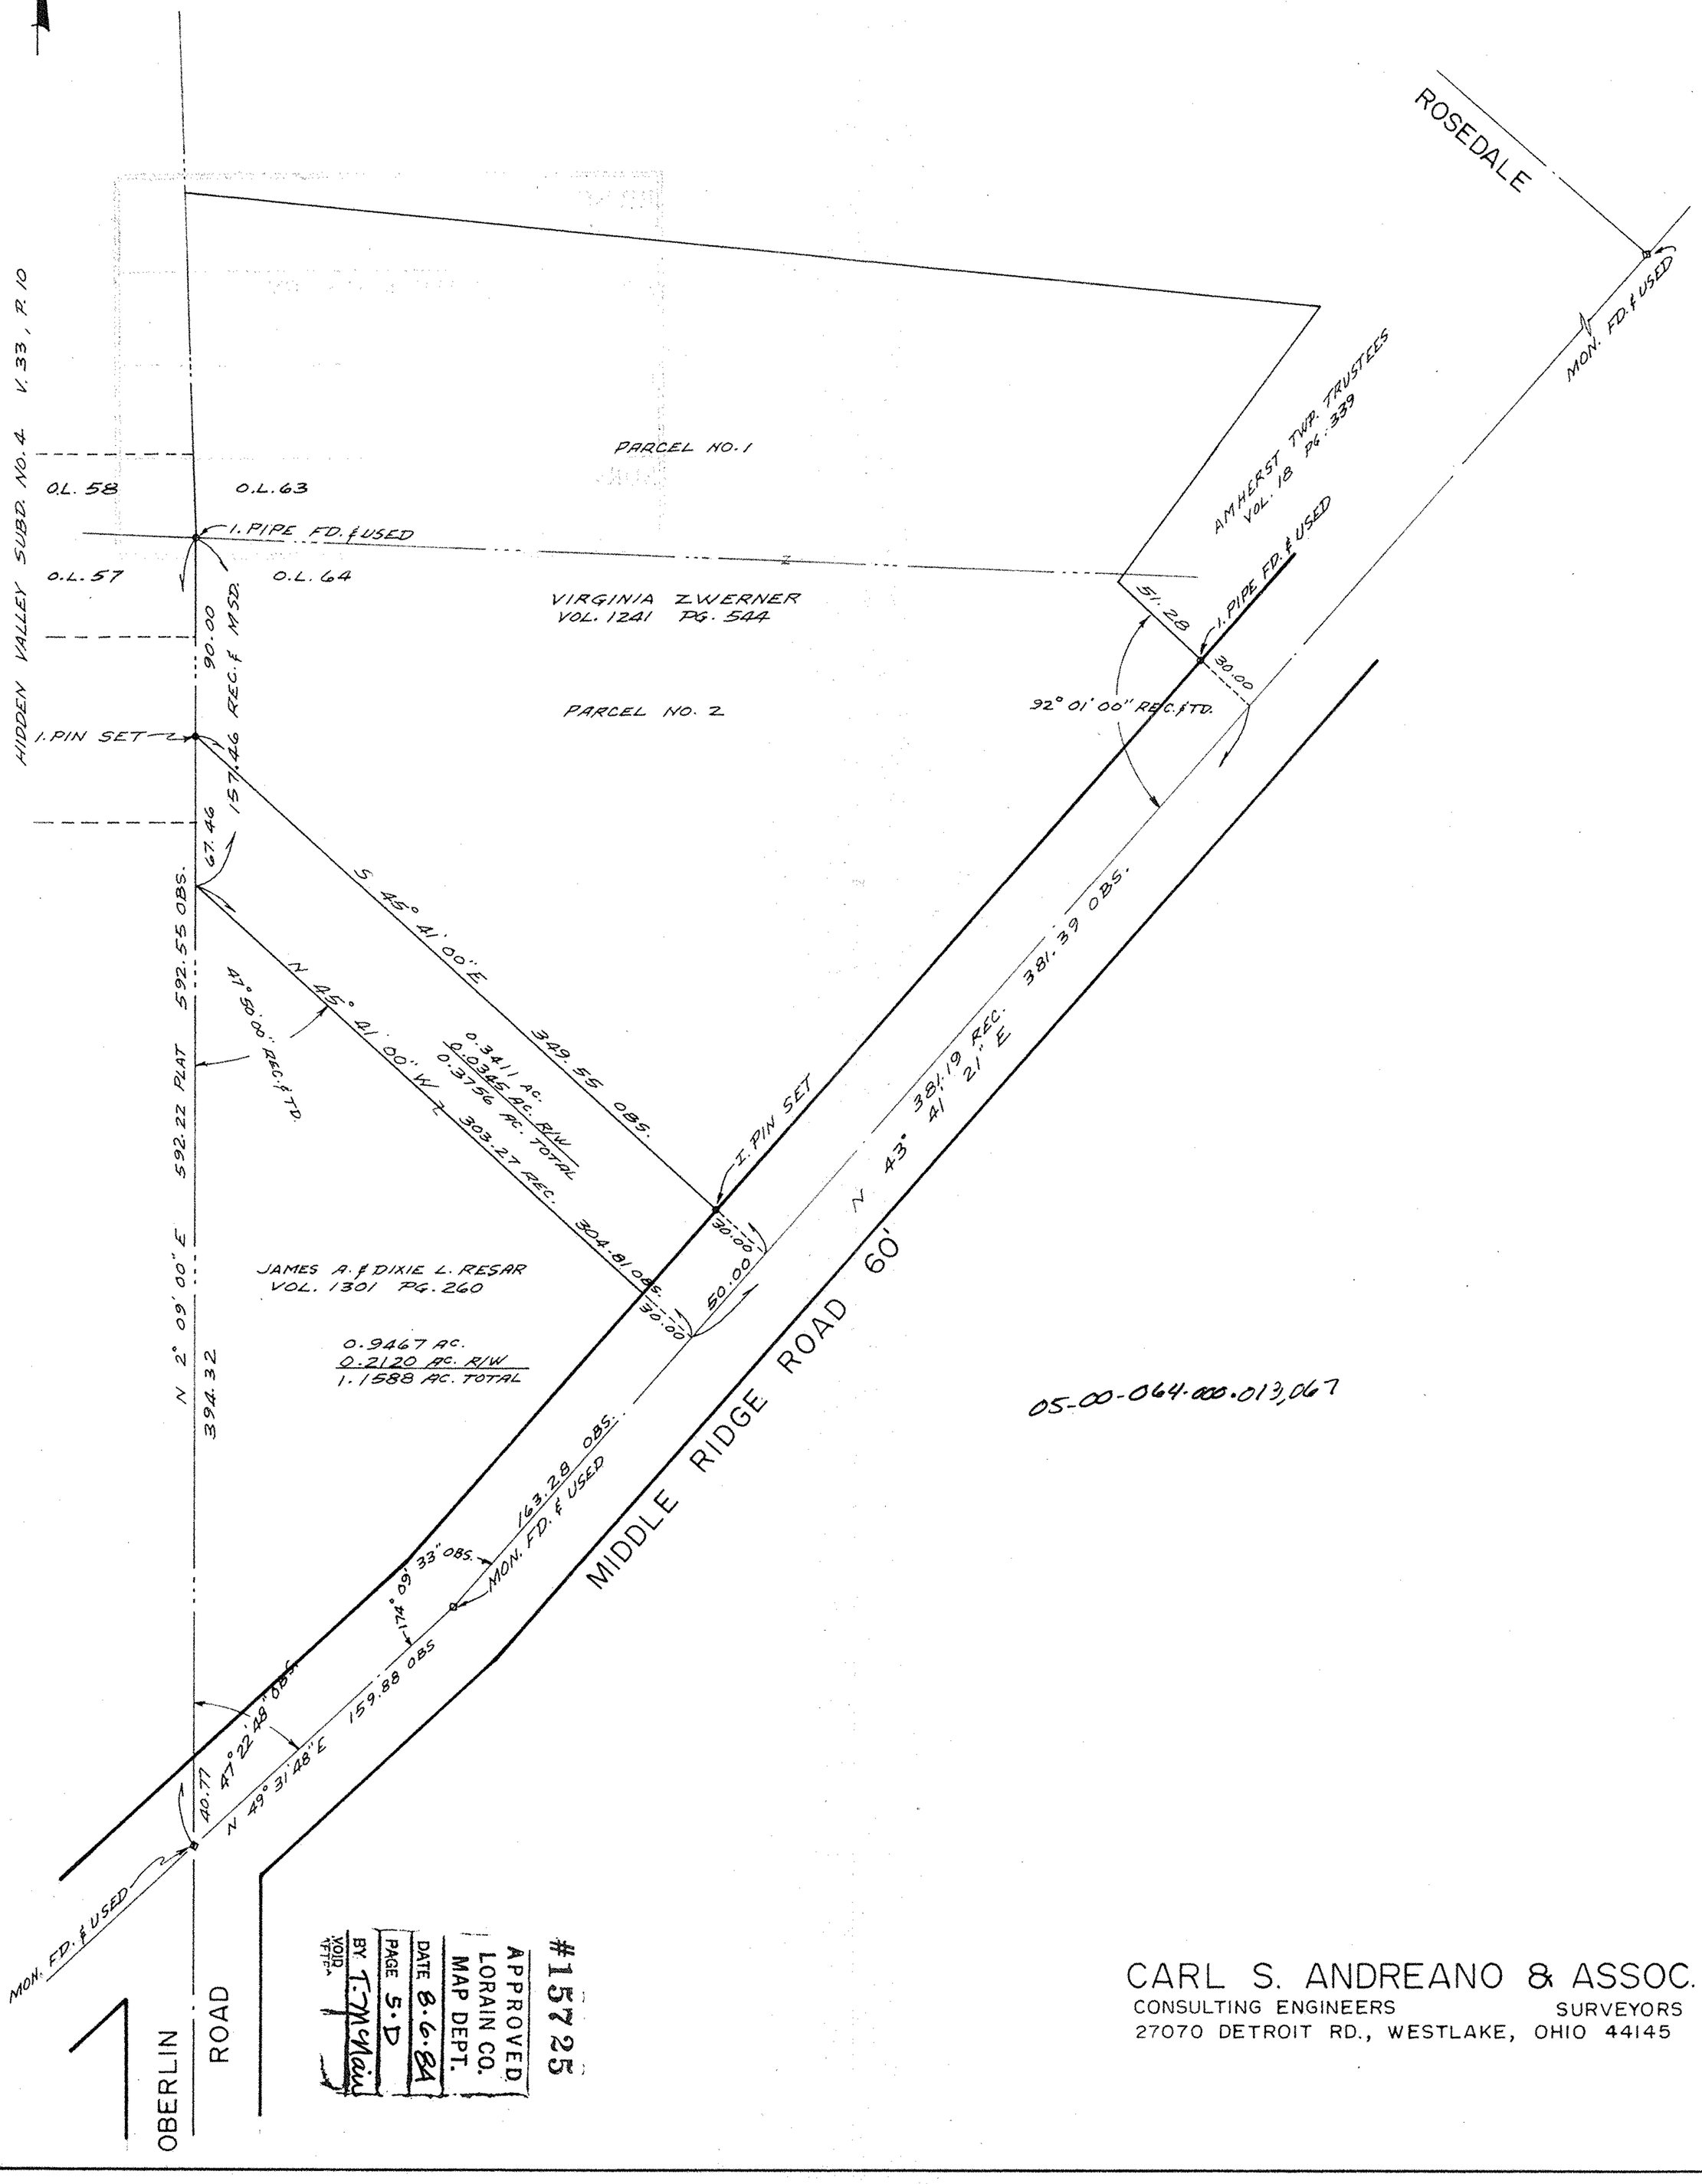

05-00-064-000.013,067

APPROVED
LORAIN CO.
MAP DEPT.
DATE 8-6-84
PAGE 5-D
BY T. McMain
VOID AFTER

CARL S. ANDREANO & ASSOC.
CONSULTING ENGINEERS SURVEYORS
27070 DETROIT RD., WESTLAKE, OHIO 44145