S.K. 2

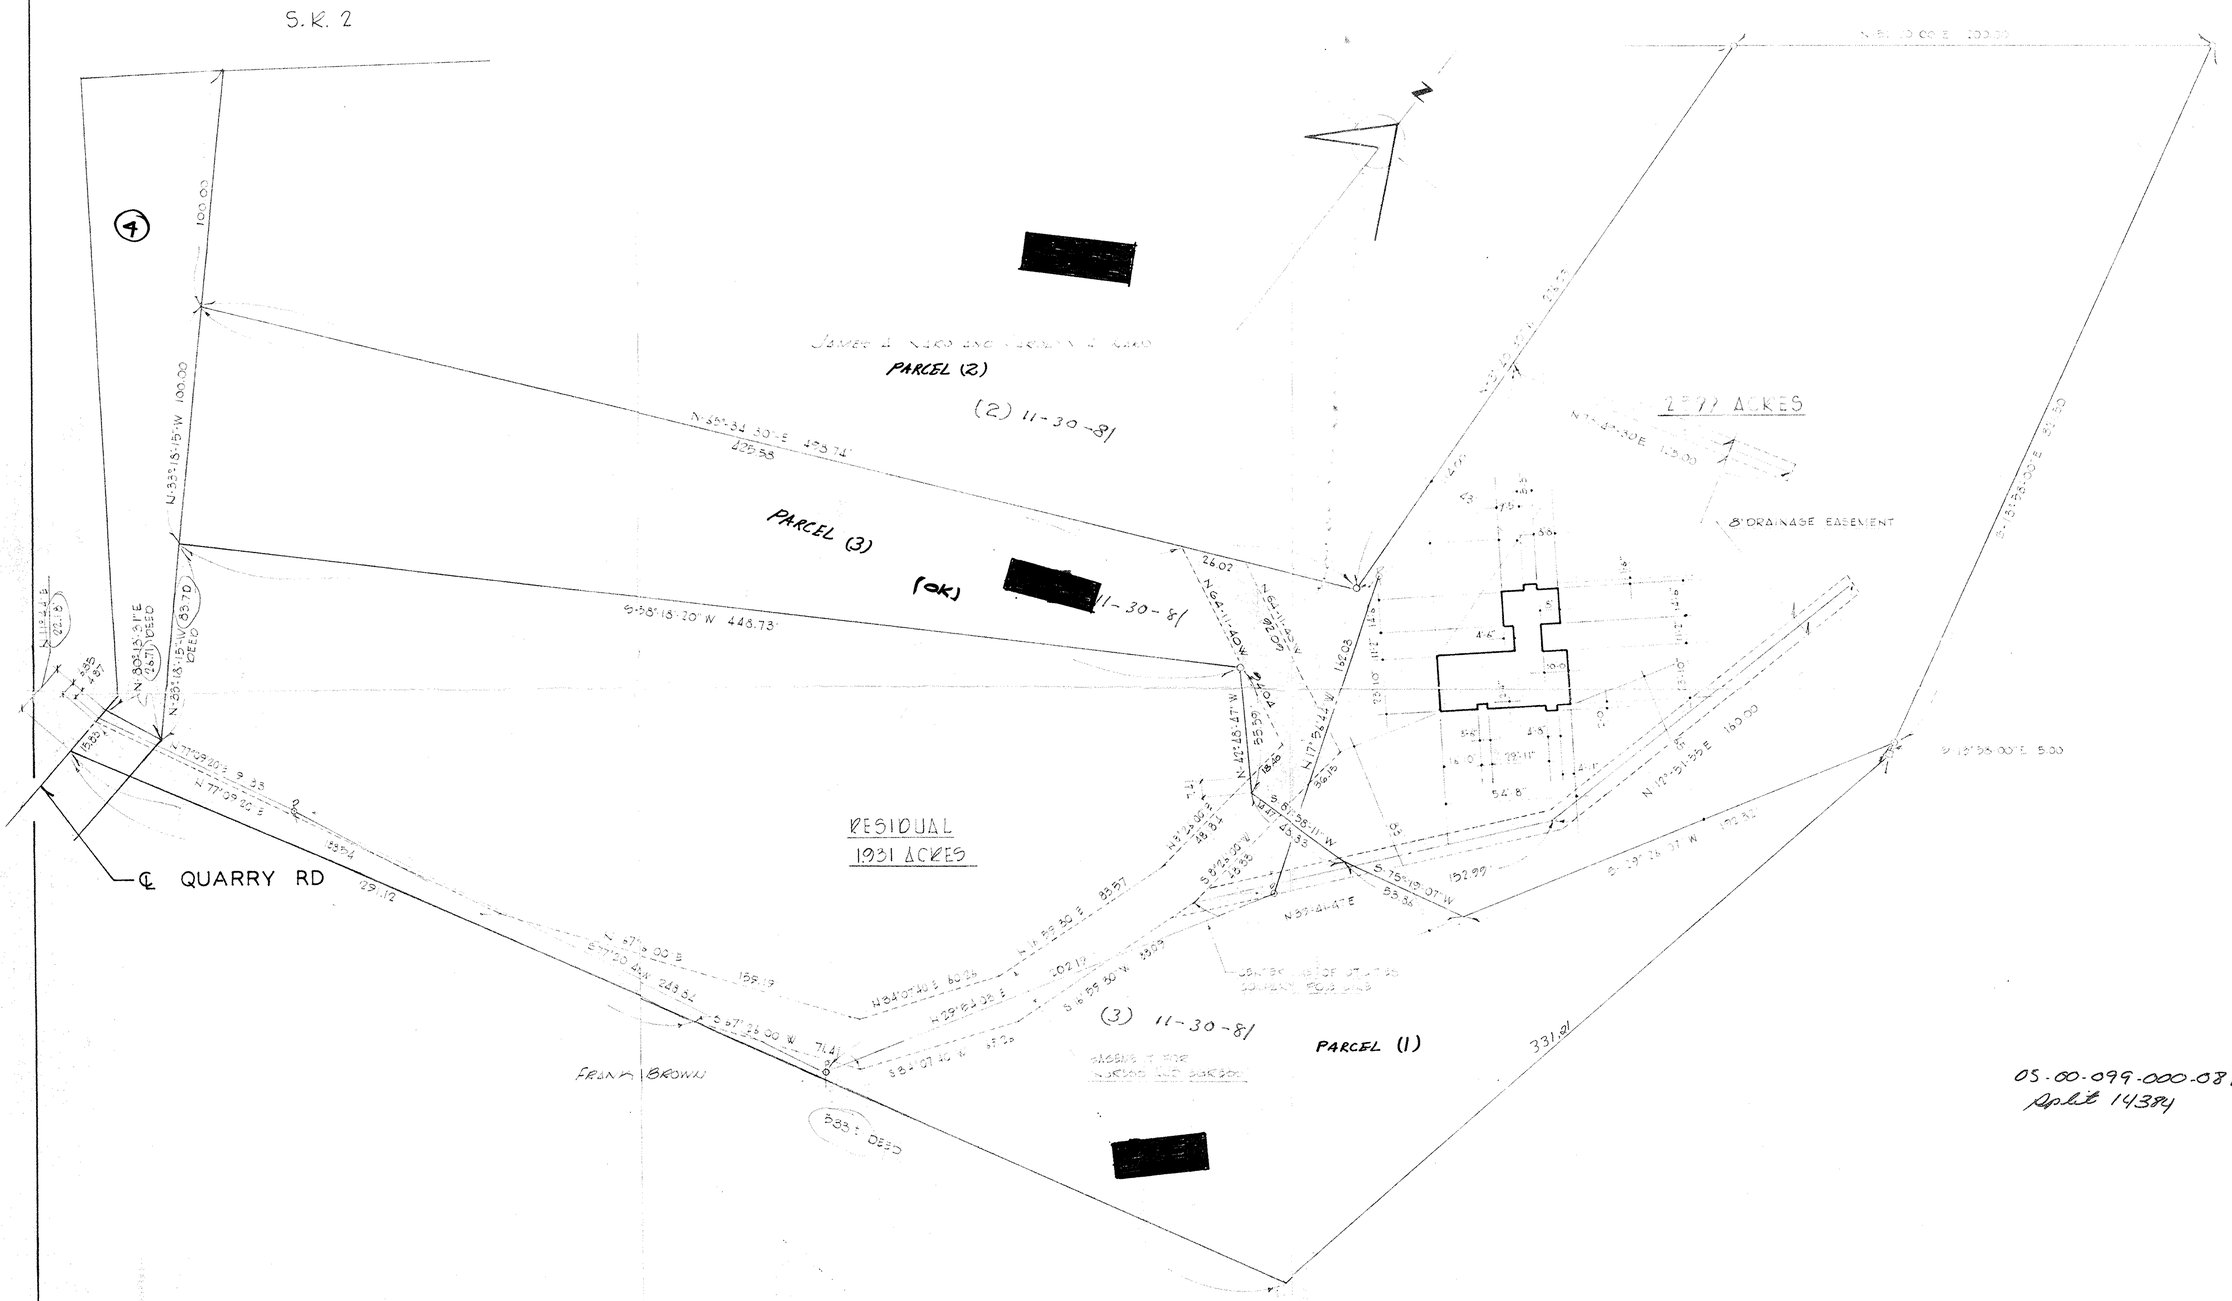

JOHN VOLAK & MARGARET VOLAK	LOT SPLIT AND PLOT PLAN	PART OF ORIGINAL LOT 99 AMHERST TOWNSHIP OHIO	SCALE 1"= 30'	MARCH 1980

S1089