PARENT PARCEL: 05-00-099-000-057

CHILD PARCEL: 05-00-099-000-125, 126

STARTING POINT: SE corner of 05-00-099-000-109

NO. 22409

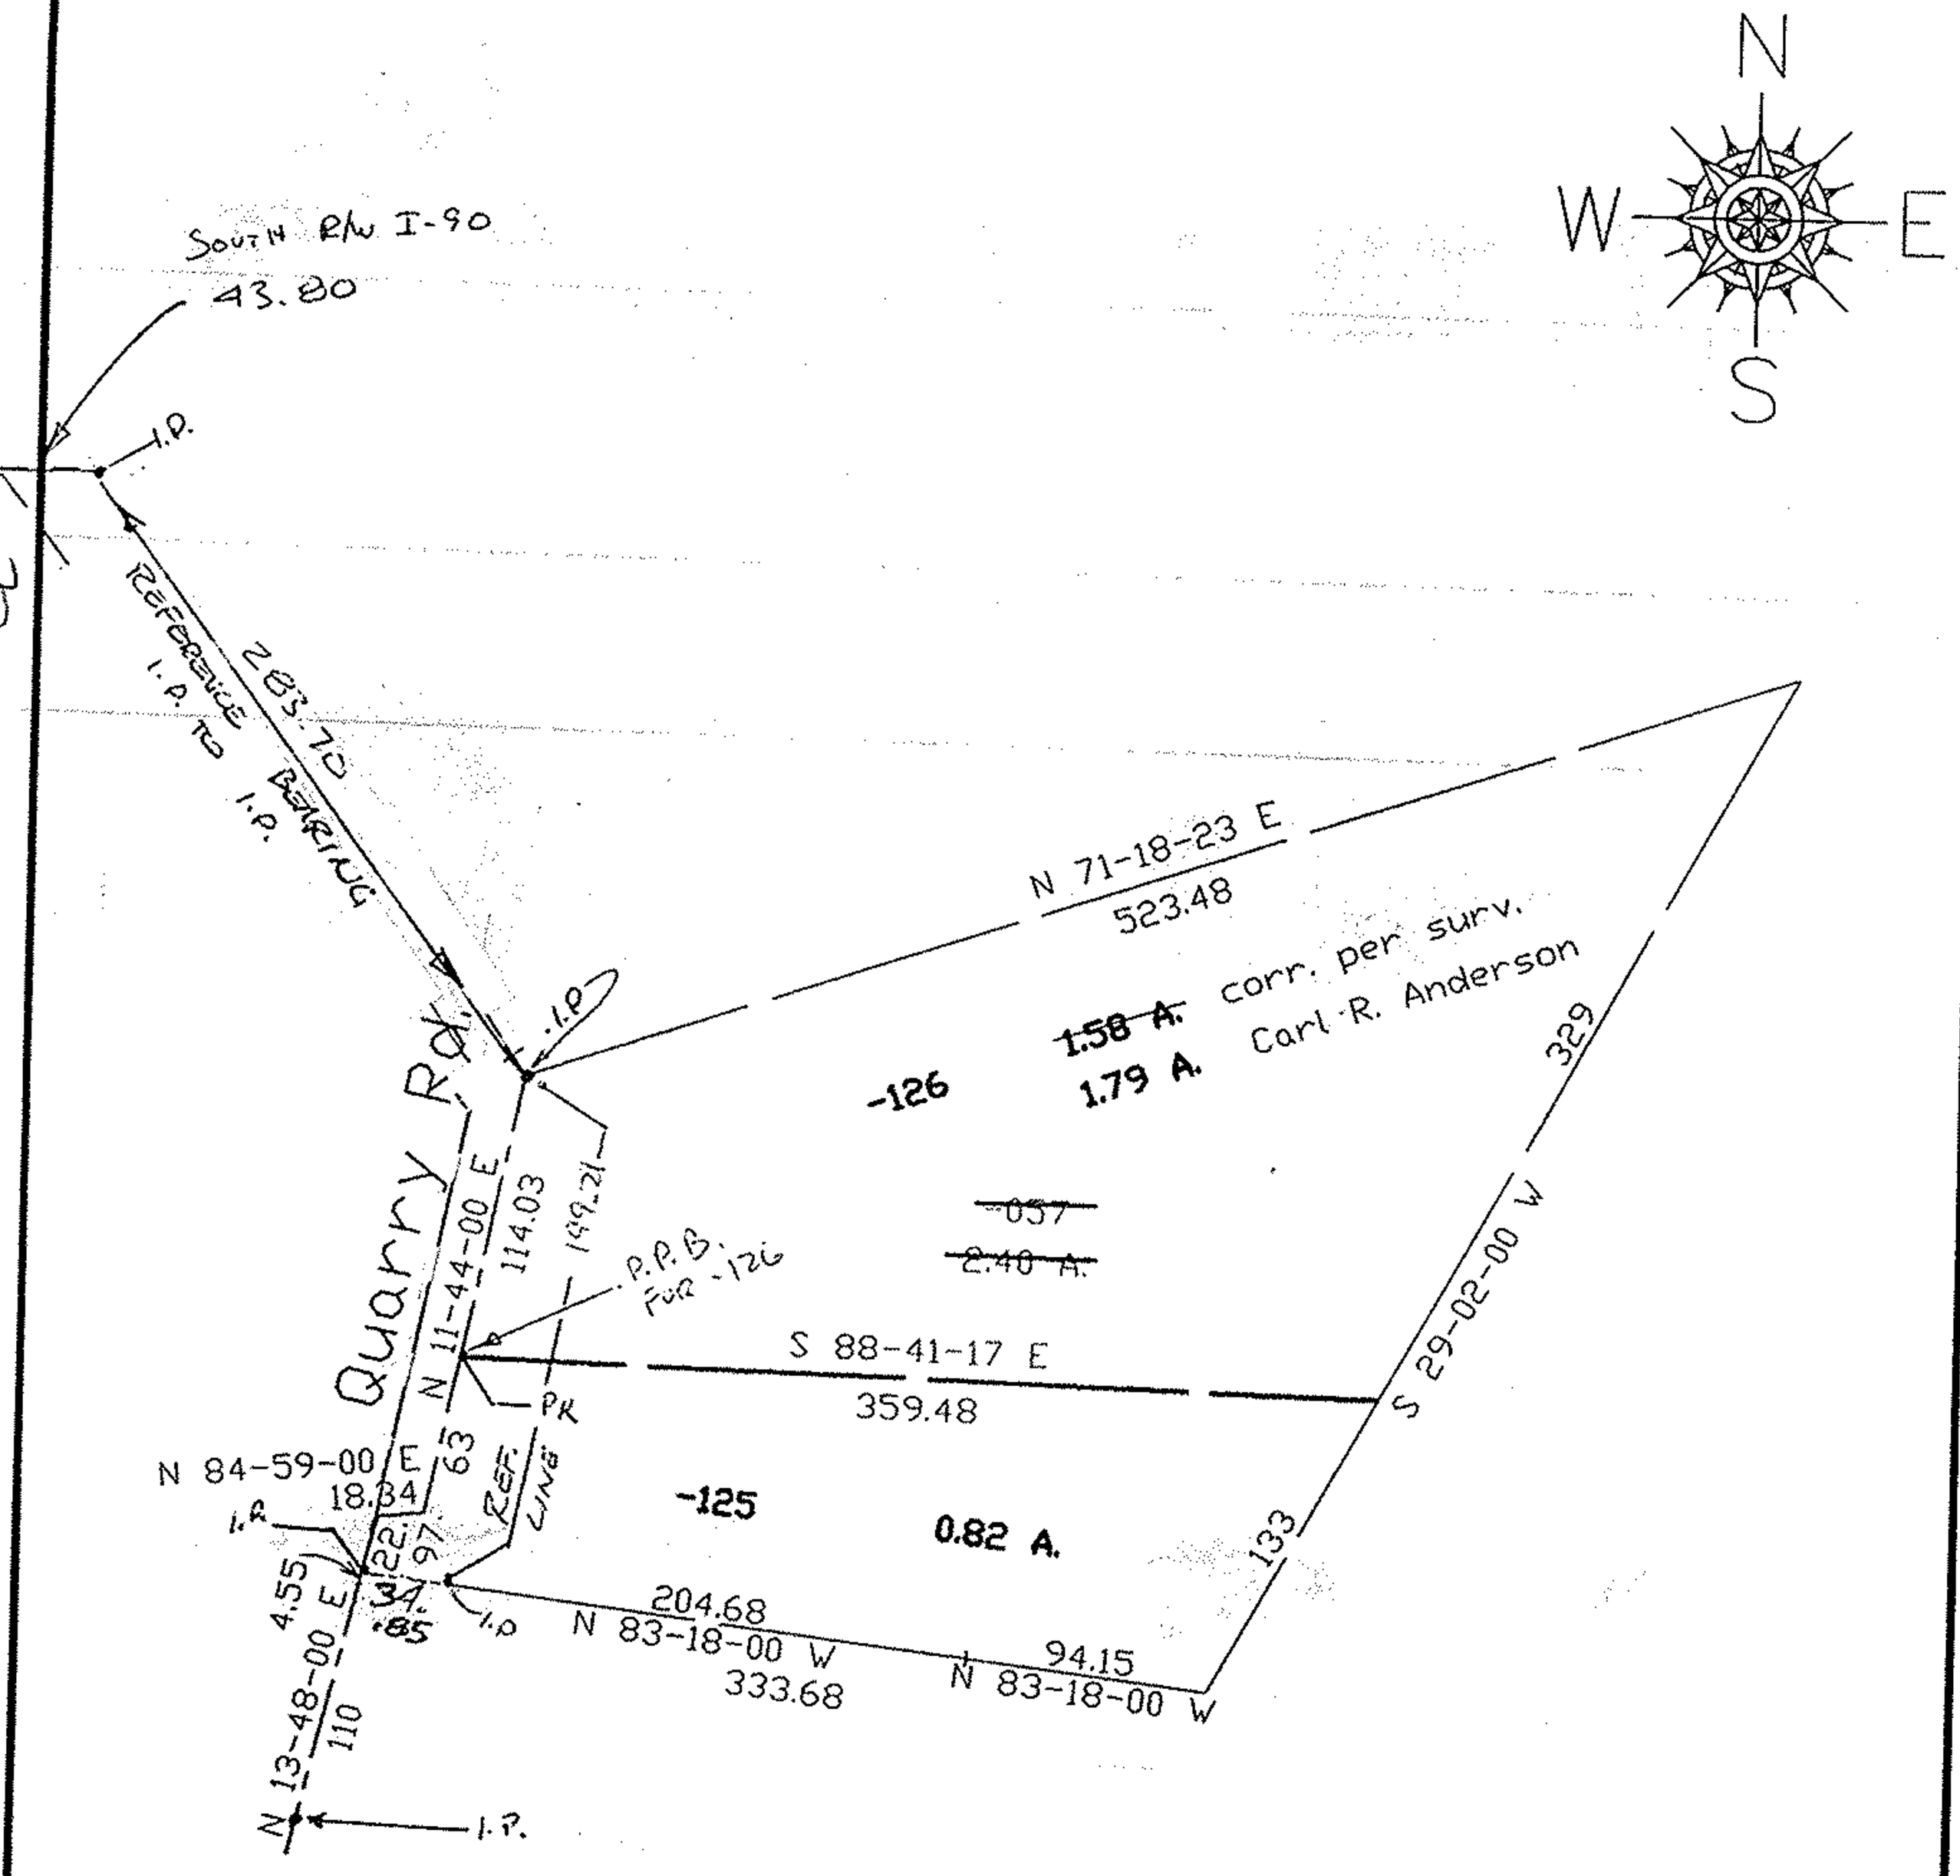

SPLITS/DEEDS PROCESSED

LORAIN COUNTY TAX MAP DEPARTMENT

226 MIDDLE AVE. ELYRIA, OHIO

SURVEYED BY: Carl R. Anderson

CLOSURE: 0.09:10,000

MAP PAGE(S): 05-00-099-C

APPROVED BY: kac DATE: 1/23/98

SCALE: 1"= 100 PRIOR INSTRUMENT: 1360/407