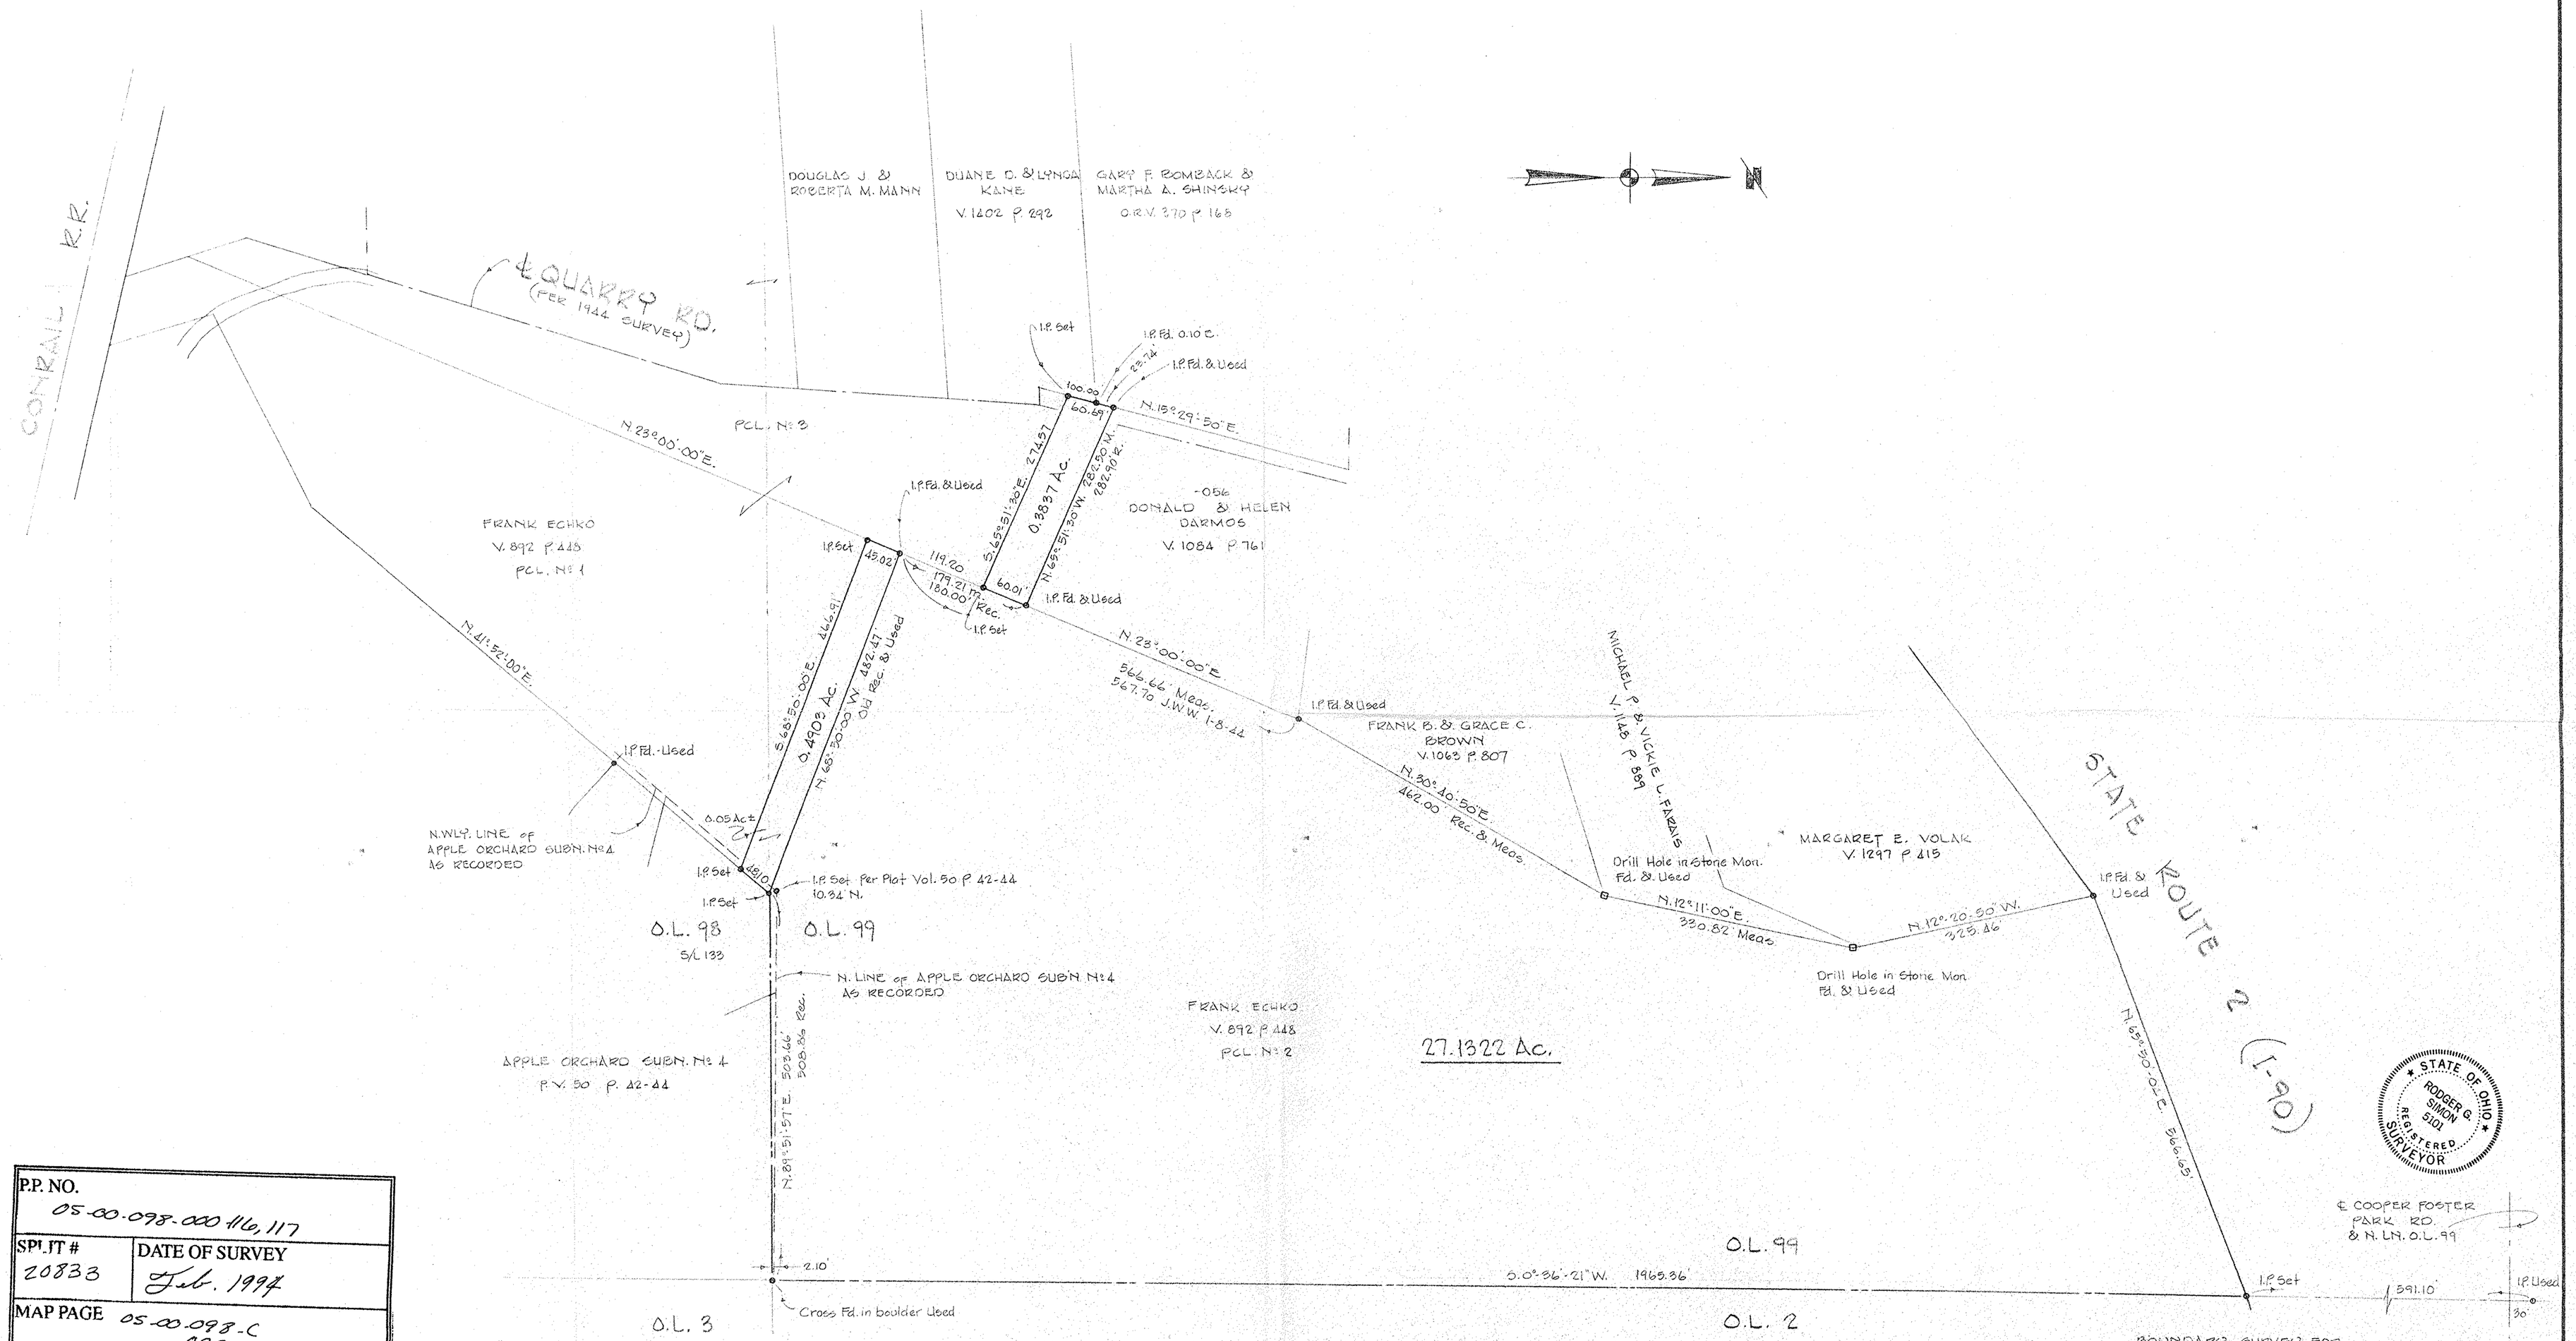

P.P. NO. 05-00-098-000-116, 117	
SPLIT # 20833	DATE OF SURVEY Feb. 1994
MAP PAGE 05-00-098-C 099-C	
SURVEYOR Rodger G. Simon	

BOUNDARY SURVEY FOR

ESTATE OF FRANK ECHKO

PART OF O.L.s 98 & 99 — TOWNSHIP OF AMHERST

CITY OF AMHERST — COUNTY OF LORAIN — STATE OF OHIO

FEBRUARY, 1994 — SCALE 1" = 100'

LAUNDON • SIMON • CAHL & ASSOC.
ENGINEERS — SURVEYORS
110 MIDDLE AVE. ELYRIA, O.

REV. 5/1/94

93-2500