

Penter Bros


PART OF ORIGINAL  
AMHERST TOWNSHIP  
LOT NO. 98  
CITY OF AMHERST  
LORAIN COUNTY, OHIO

SCALE 1"=100'

BY: C.E. RICHARDS DATE: JUNE 1971

CLEVELAND QUARRIES  
VOL. 178 PG. 425  
1961

JAN 31 1975

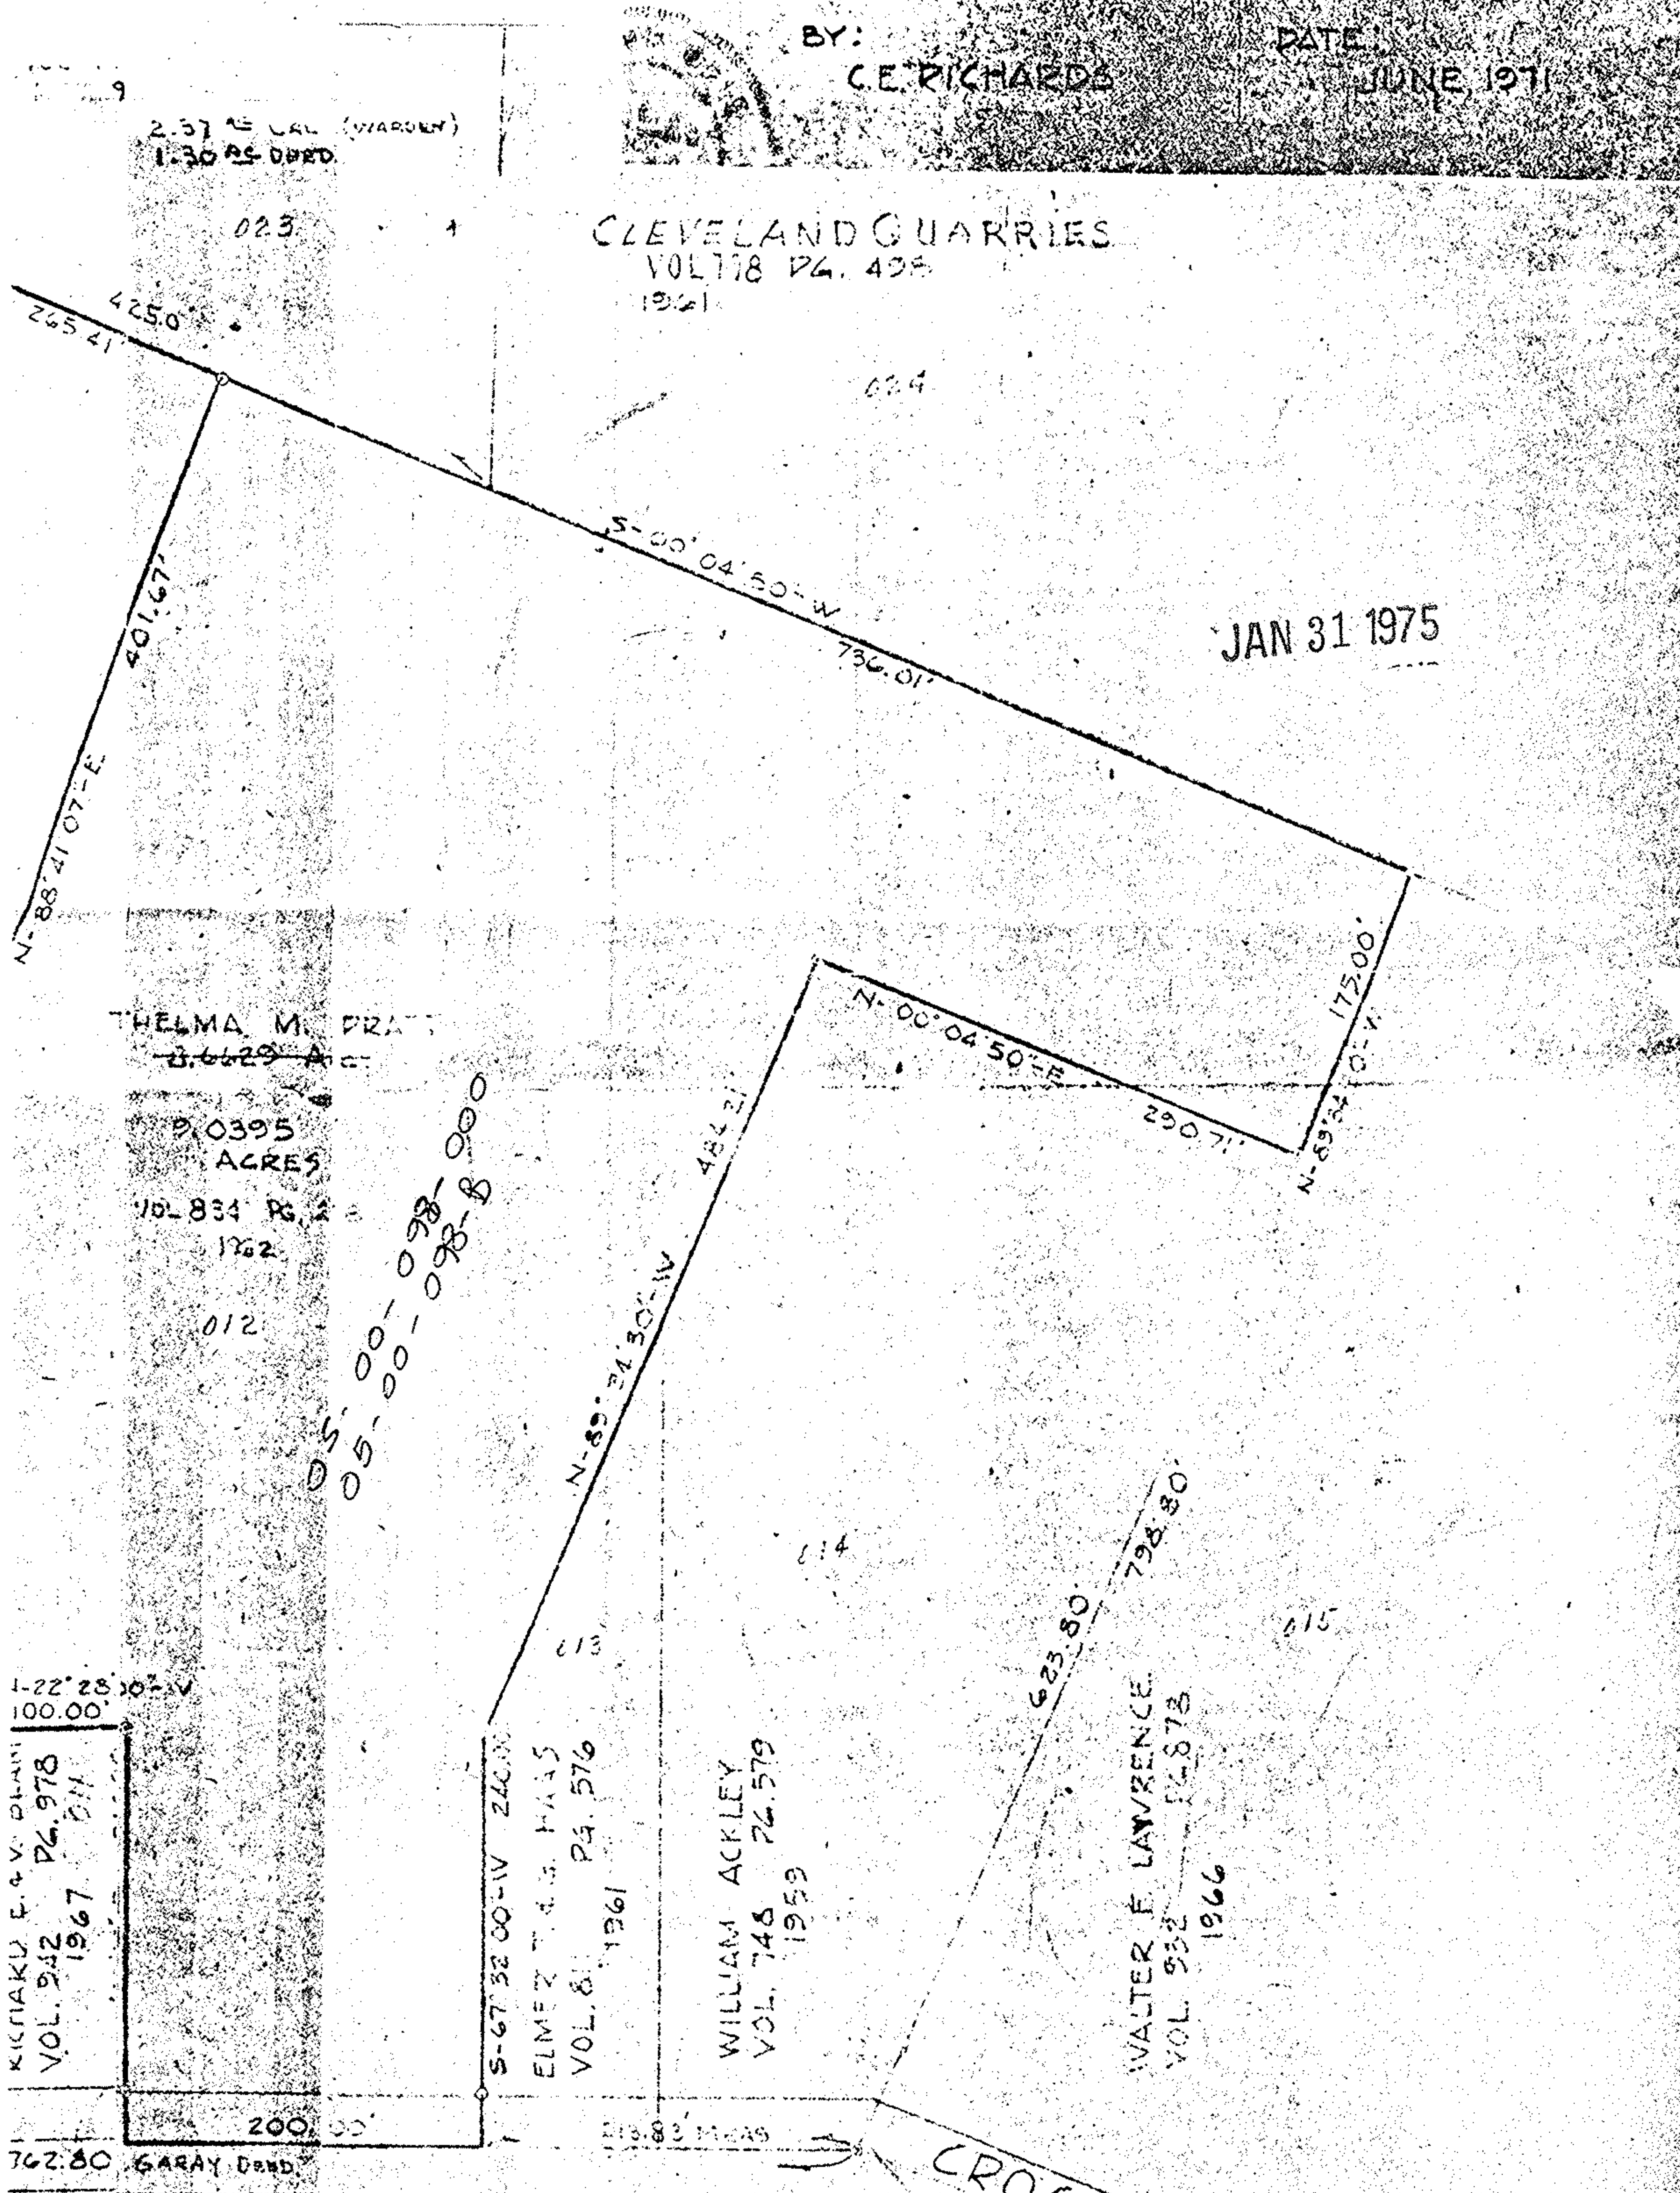

KISCIAK E. & V. OLANI  
VOL. 242 PG. 978  
1967

ELMER T. G. HAYS  
VOL. 8 PG. 576  
1961


WILLIAM ACKLEY  
VOL. 748 PG. 579  
1959

WALTER F. LAWRENCE  
VOL. 952 PG. 873  
1966

CROSSE

04, 98

05-00-098-000-05

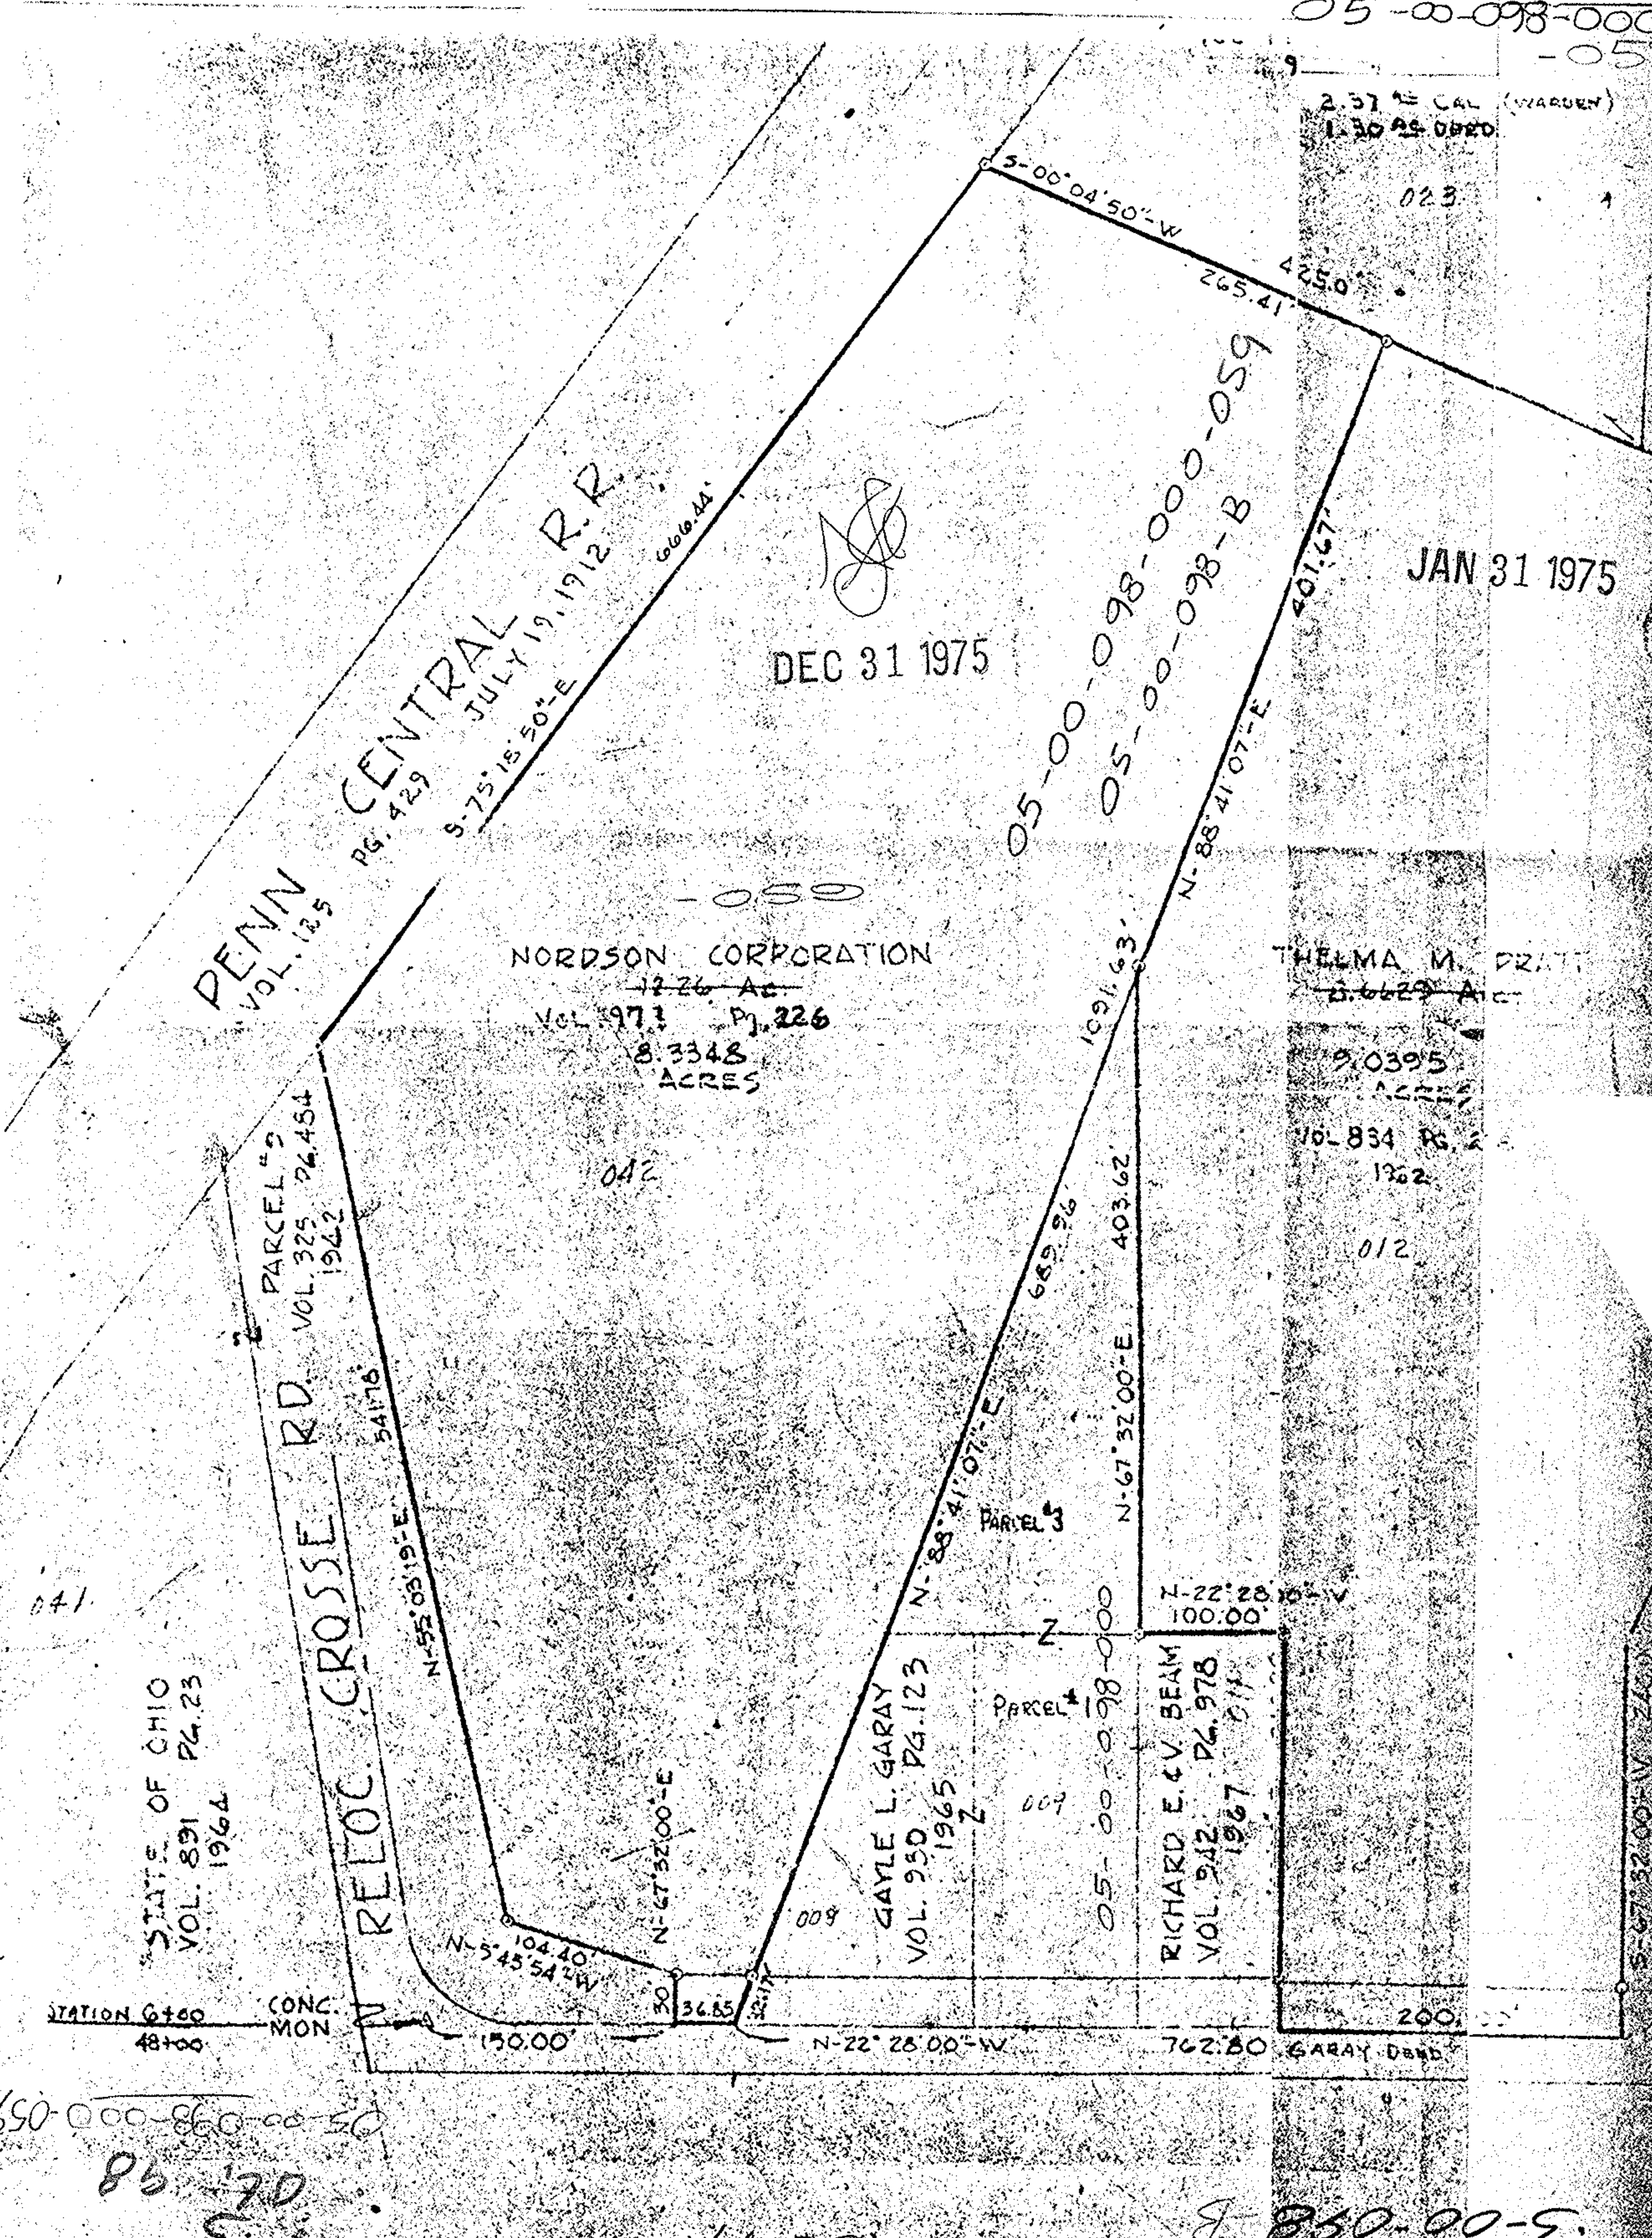

PENN CENTRAL R.R.  
VOL. 125 PG. 429  
JULY 19, 1912

NORDSON CORPORATION  
12.26 AC  
VOL. 973 PG. 226  
8.3348 ACRES

STATE OF OHIO  
VOL. 891 PG. 23  
1964

GAYLE L. GARAY  
VOL. 950 PG. 123  
1965

RICHARD E. & V. BEAM  
VOL. 942 PG. 978  
1967

THELMA M. PRATT  
3.6629 ACRES  
9.0395 ACRES  
10.834 PG. 2  
1962

05-00-098-000-059

07, 98

#9341

5-00-098-B