PROPERTY SPLIT
FOR

JACOB O. KAMM TRUST

AMHERST, OHIO
1992

DATE: MAY 2, 1992
SCALE: 1" = 100'

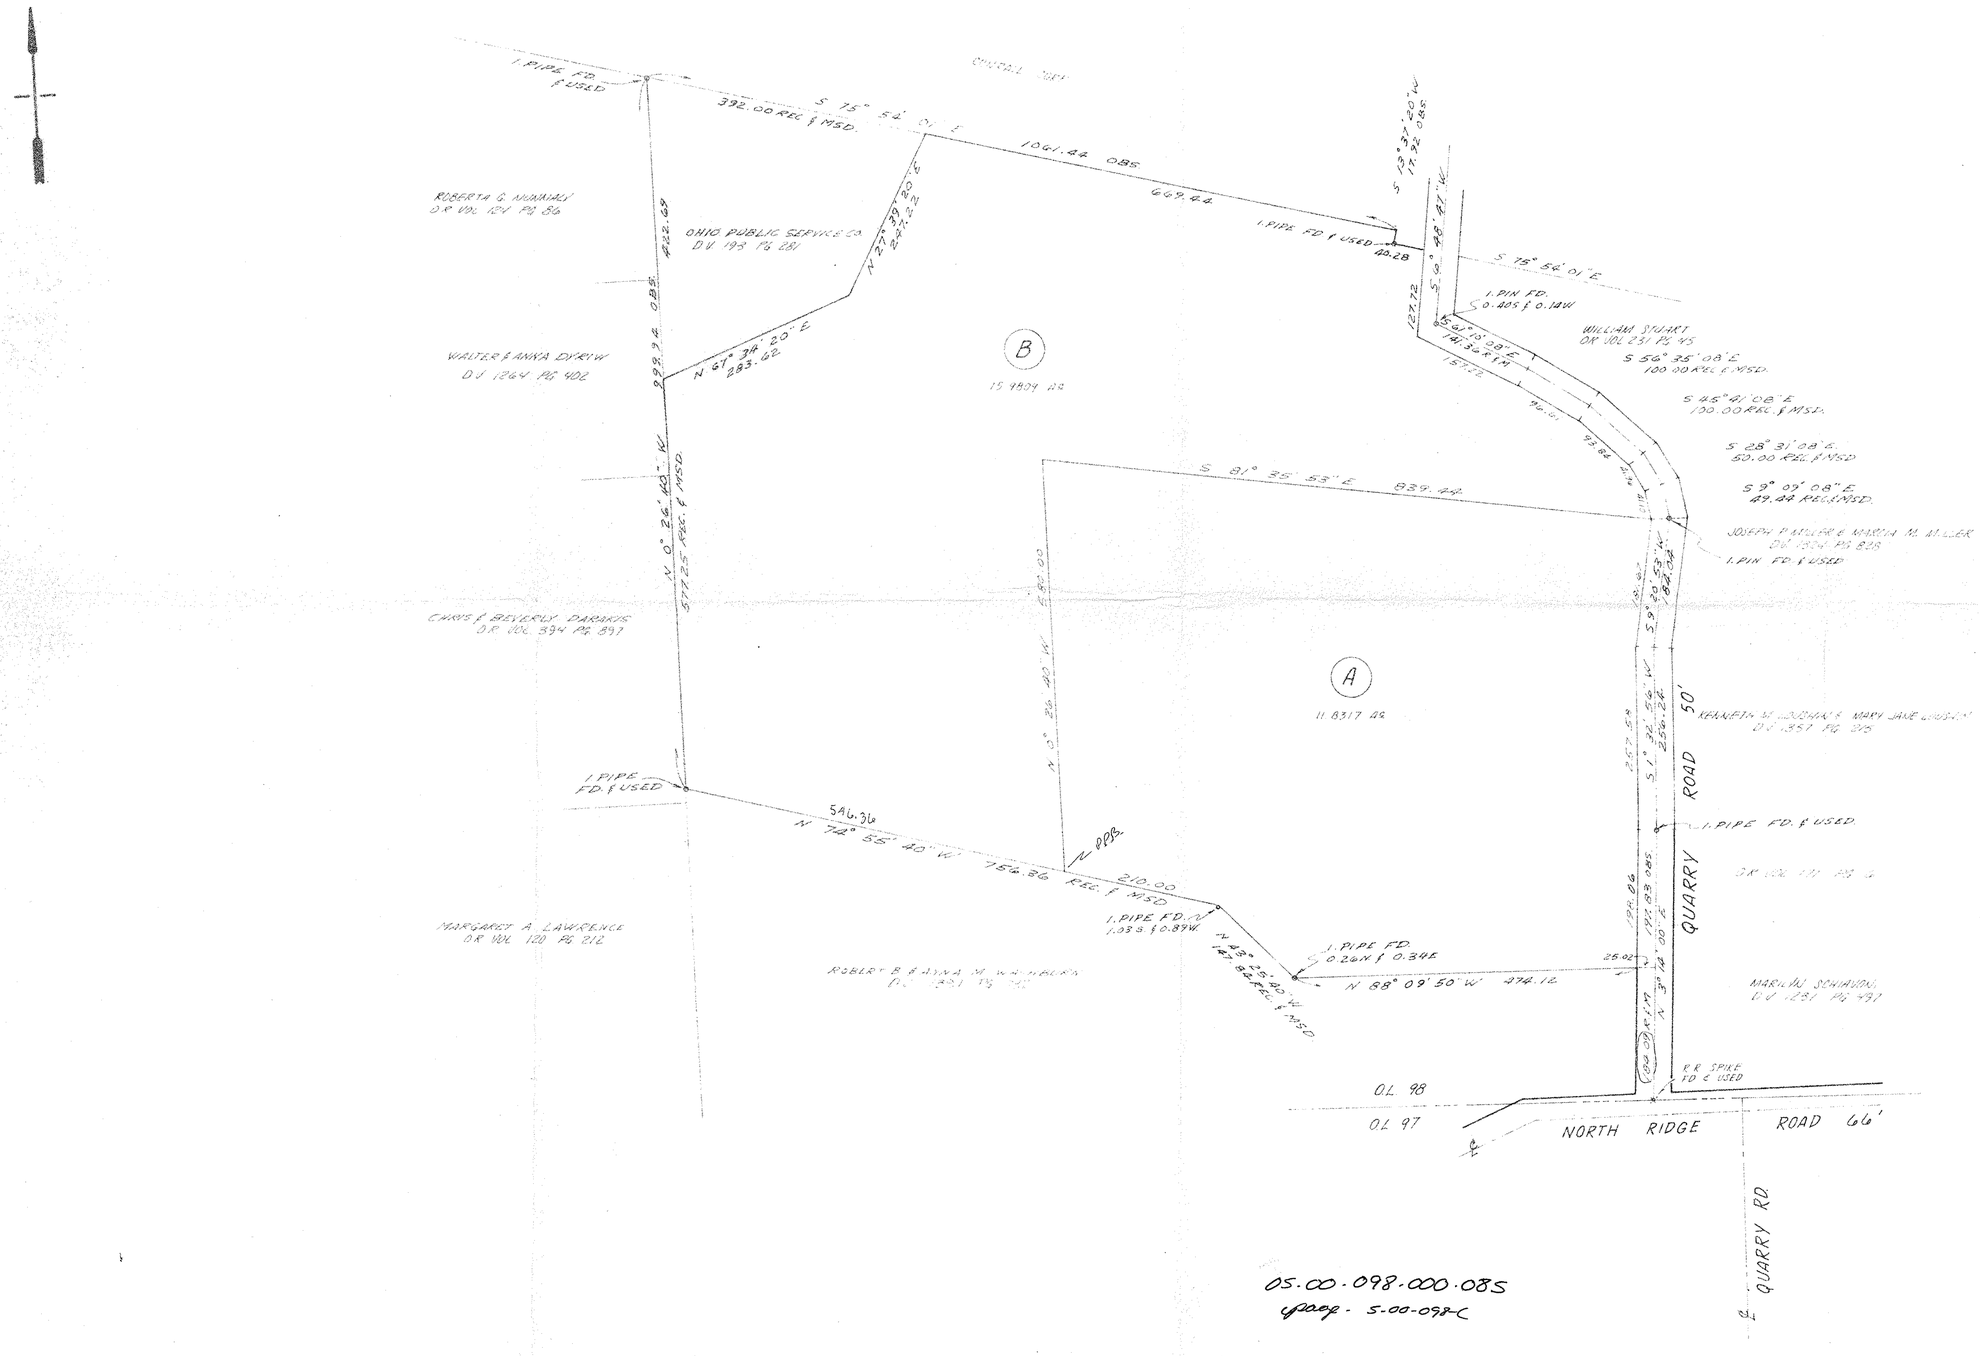

05.00.098.000.085
prop. - 5-00-098-C

#20289-A

APPROVED LORAIN CO. MAP DEPT.	
DATE 6-9-93	
PAGE 5-00-098-C	
BY T. McClain	
VOID AFTER	20289-A

RESAR & ASSOCIATES
CONSULTING ENGINEERS · SURVEYORS
24629 DETROIT ROAD WESTLAKE, OHIO 44145