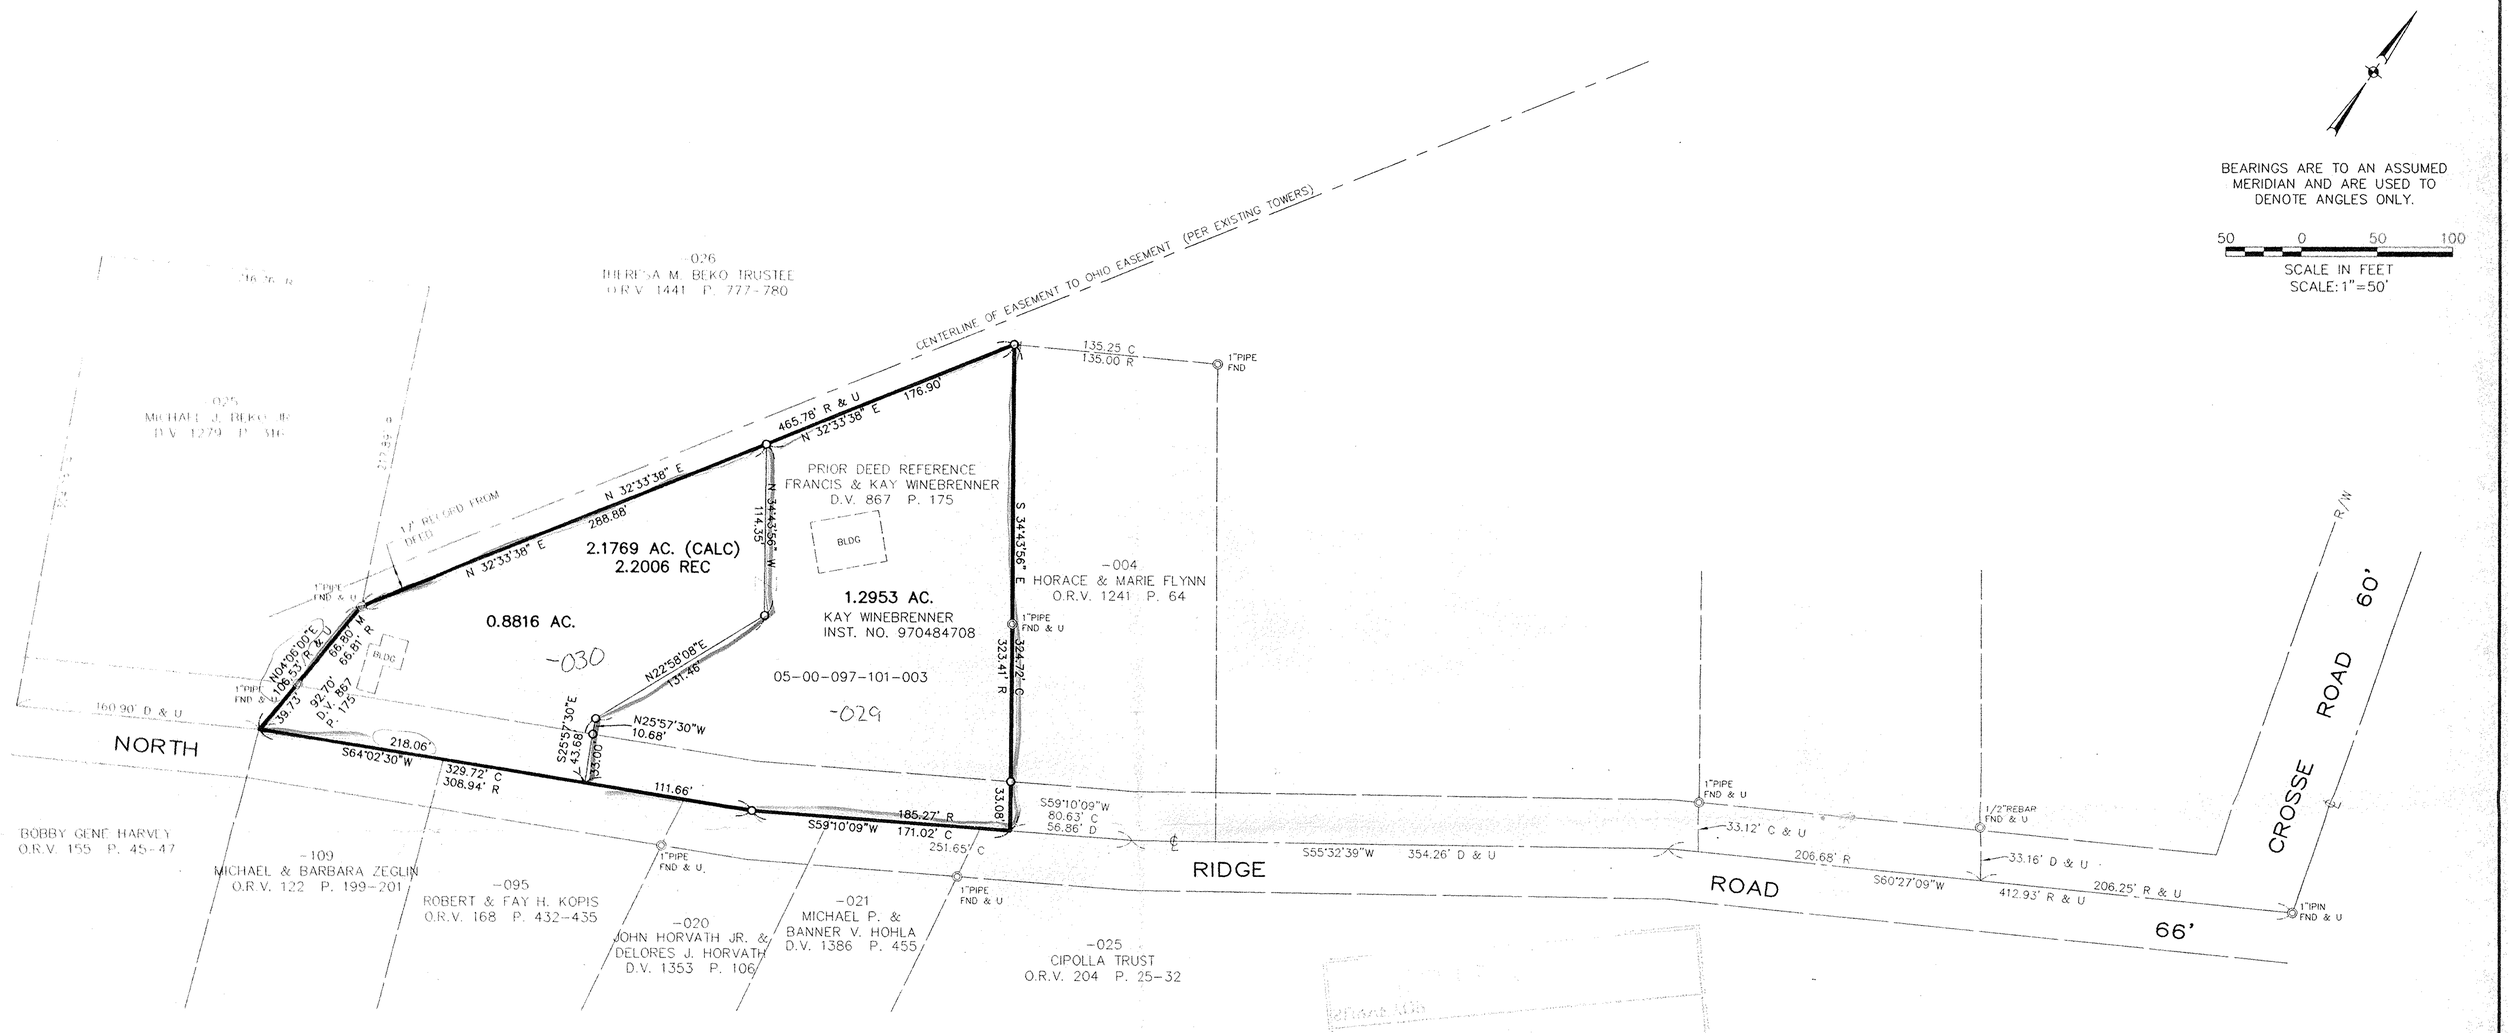

REF. DOCUMENTS USED

D.V. 1135 P. 771
O.R.V. 1372 P. 715
O.R.V. 147 P. 656
D.V. 1420 P. 802
D.V. 1196 P. 108
D.V. 1156 P. 766

ABBREVIATIONS

C – CALCULATED
R – RECORD
U – USED
FND – FOUND
M – MEASURED
D – DEED

LEGEND

◎ – IPIN/IPIPE FOUND
O – 5/8" REBAR SET

P.P. NO. 05-00-097-101-029&030	
SPLIT # 22617	DATE OF SURVEY
MAP PAGE 5-00-097-A	
SURVEYOR David L. Elwell	

#22617

APPROVED
LORAIN CO.
MAP DEPT.
DATE 8-17-98
PAGE 5-00-097-A
BY JJS
VOID 22617

David L. Elwell 6-17-98
DAVID L. ELWELL REGISTERED SURVEYOR NO. 6333

STATE OF OHIO
DAVID L. ELWELL
6333
REGISTERED
SURVEYOR

DATE: 06-09-98
DRAWN BY: VY
CH'D BY: DLE
F.B.
DWG. NAME: 98117/0-SURV01.DWG

REVISIONS

BOUNDARY SURVEY
PARCEL SPLIT

PART OF AMHERST TOWNSHIP O.L. 97
CITY OF AMHERST COUNTY OF LORAIN STATE OF OHIO

KS ASSOCIATES, INC.
ENGINEERS/SURVEYORS
424 Middle Avenue
P.O. Box 89
Elyria, Ohio 44036
PHONE: (440) 322-6317 * FAX: (440) 284-0623

ENGINEERS/SURVEYORS KS ASSOCIATES INCORPORATED

SHEET 1 OF 1

JOB NO. 98117