05-00-095-000-062

5-00-095-B

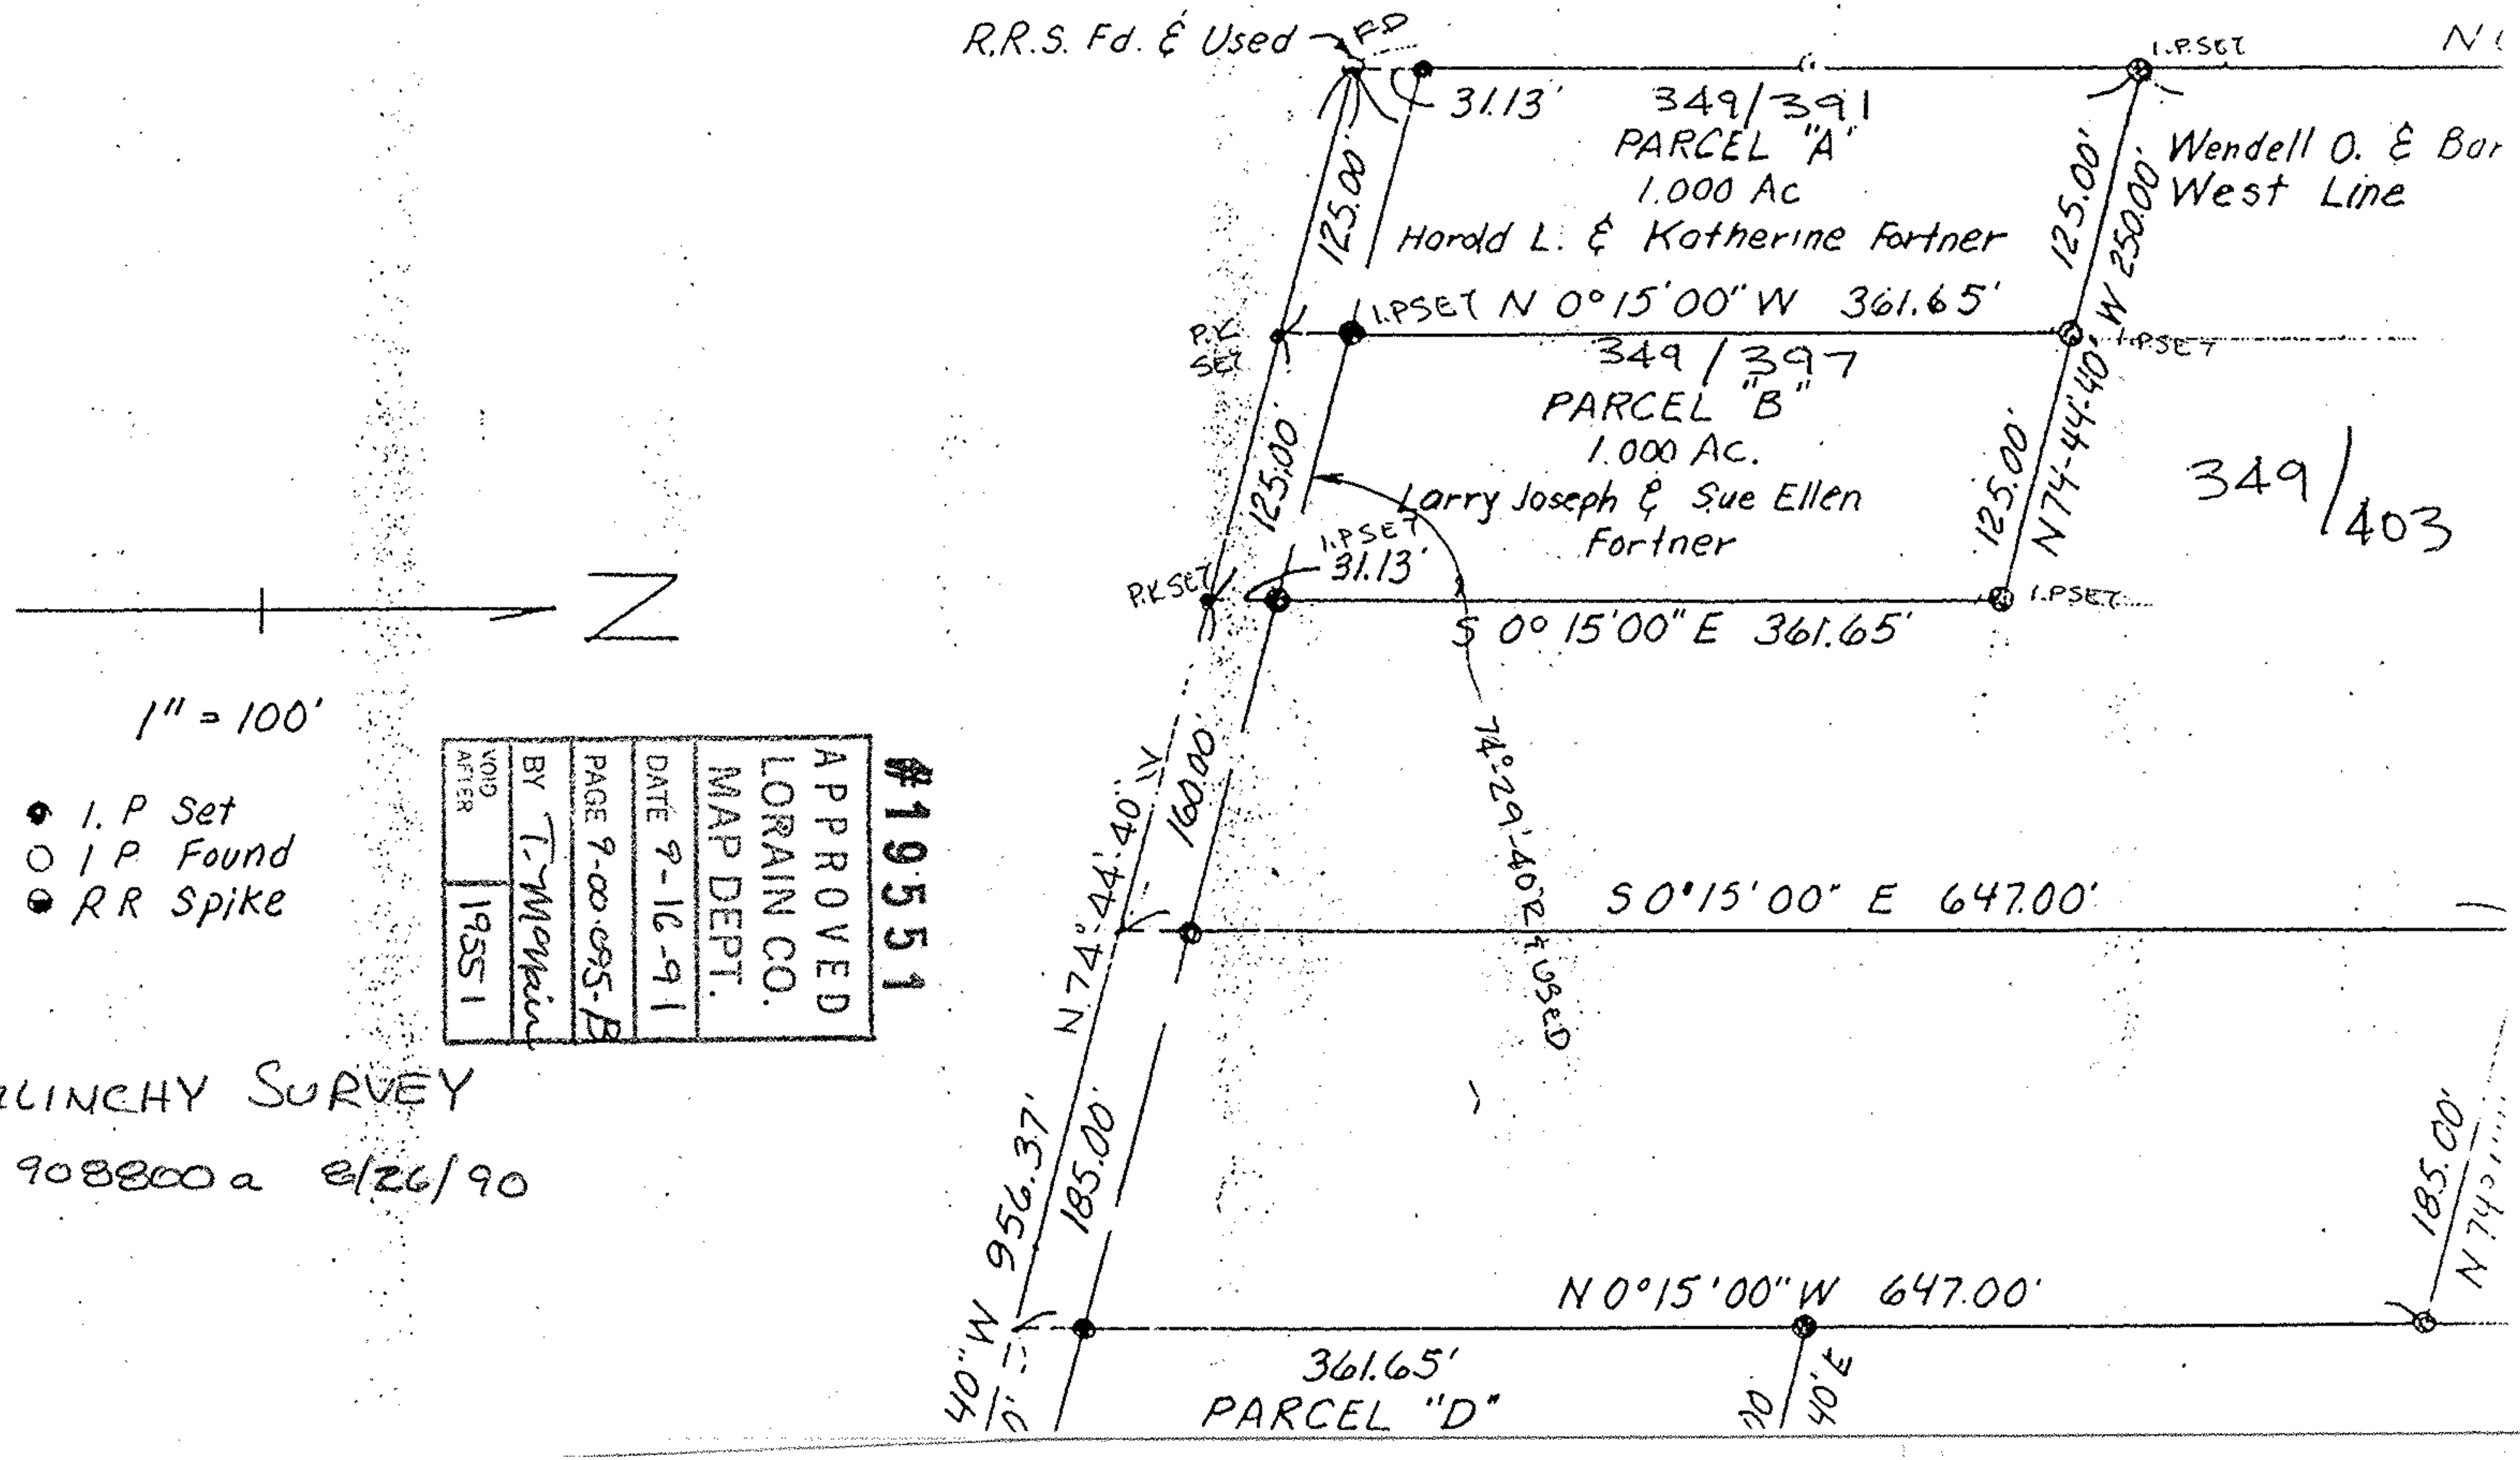

1" = 100'

- ● I. P Set
- ○ I P Found
- ● R R Spike

APPROVED LORAIN CO. MAP DEPT.	#19551
DATE 9-16-91	
PAGE 9-00-095-B	
BY T. McMakin	
VOID AFTER	
1955 1	

L.V. McGLINCHY SURVEY

Job No. 908800a 8/26/90