MAP OF SURVEY MADE FOR

RAY DICK

O.L.NOS.94+95, AMHERST TWP.

LORAIN COUNTY, OHIO

DISTANCES ARE GIVEN IN FEET AND DECIMAL PARTS

SCALE, 1 IN. = 60 FEET

ELYRIA, OHIO. JUNE 4, '50

F. B. PG. 28

C. T. BIGGS, REG. SURVEYOR
809 PARK AVE.
ELYRIA, OHIO

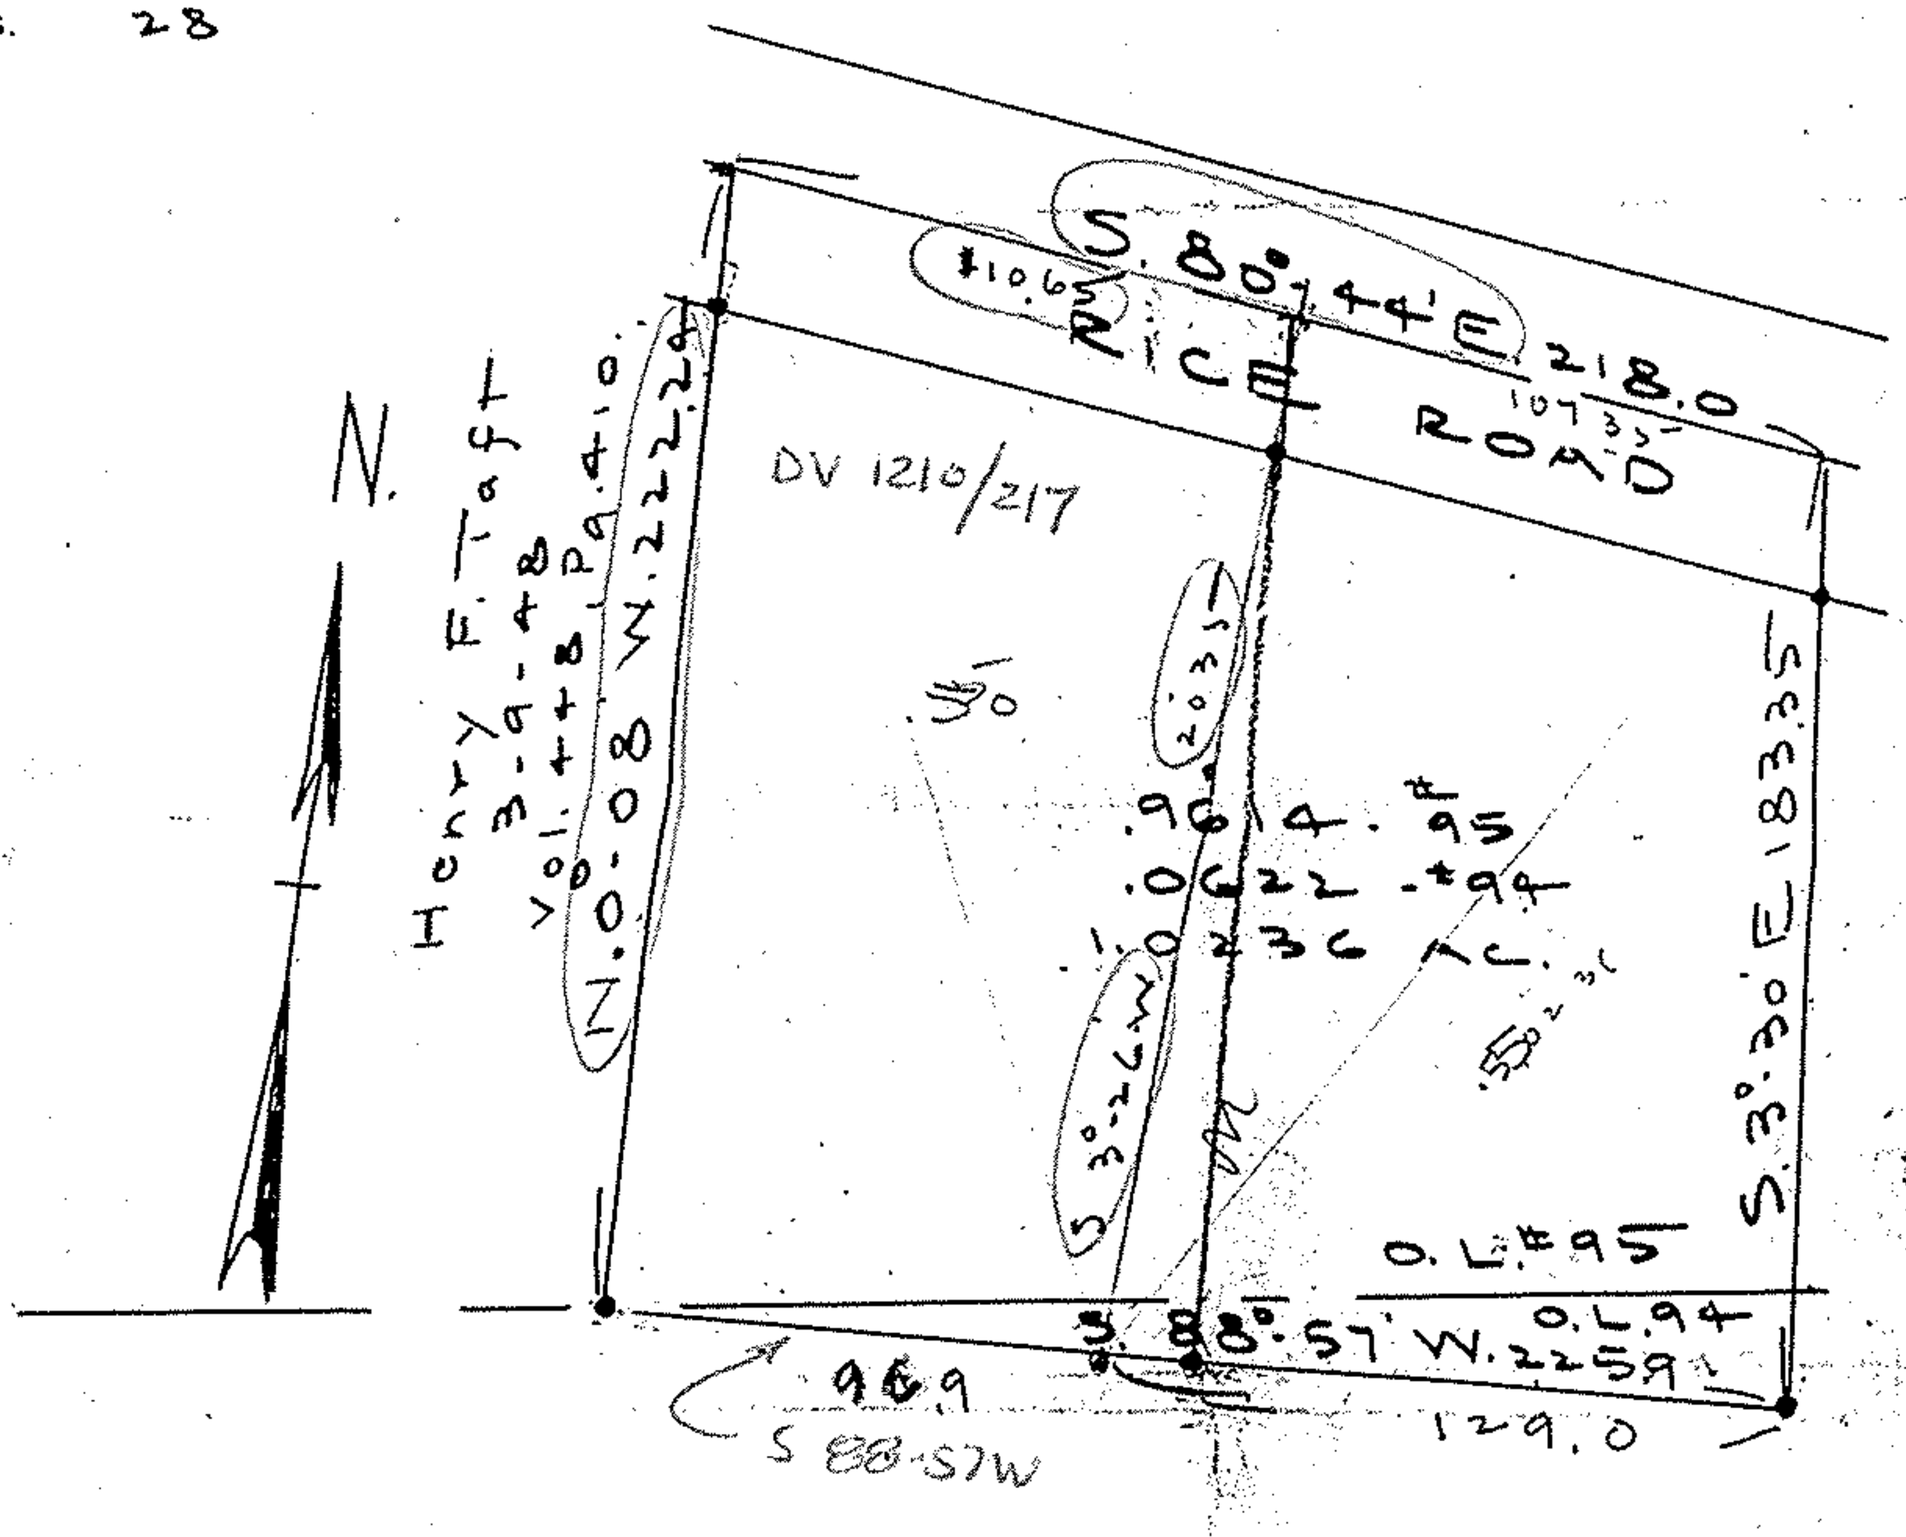

#05-00-095-000-013,014

50
.021
.489

.0236
.0012
.0248

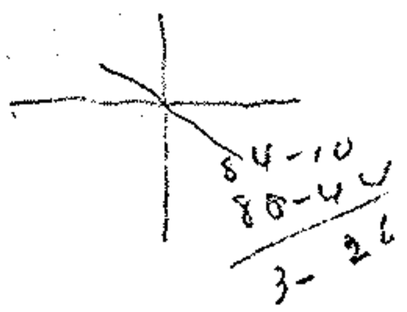

Union Ray &
Ova Zinn Dick
494-506
July 26 50