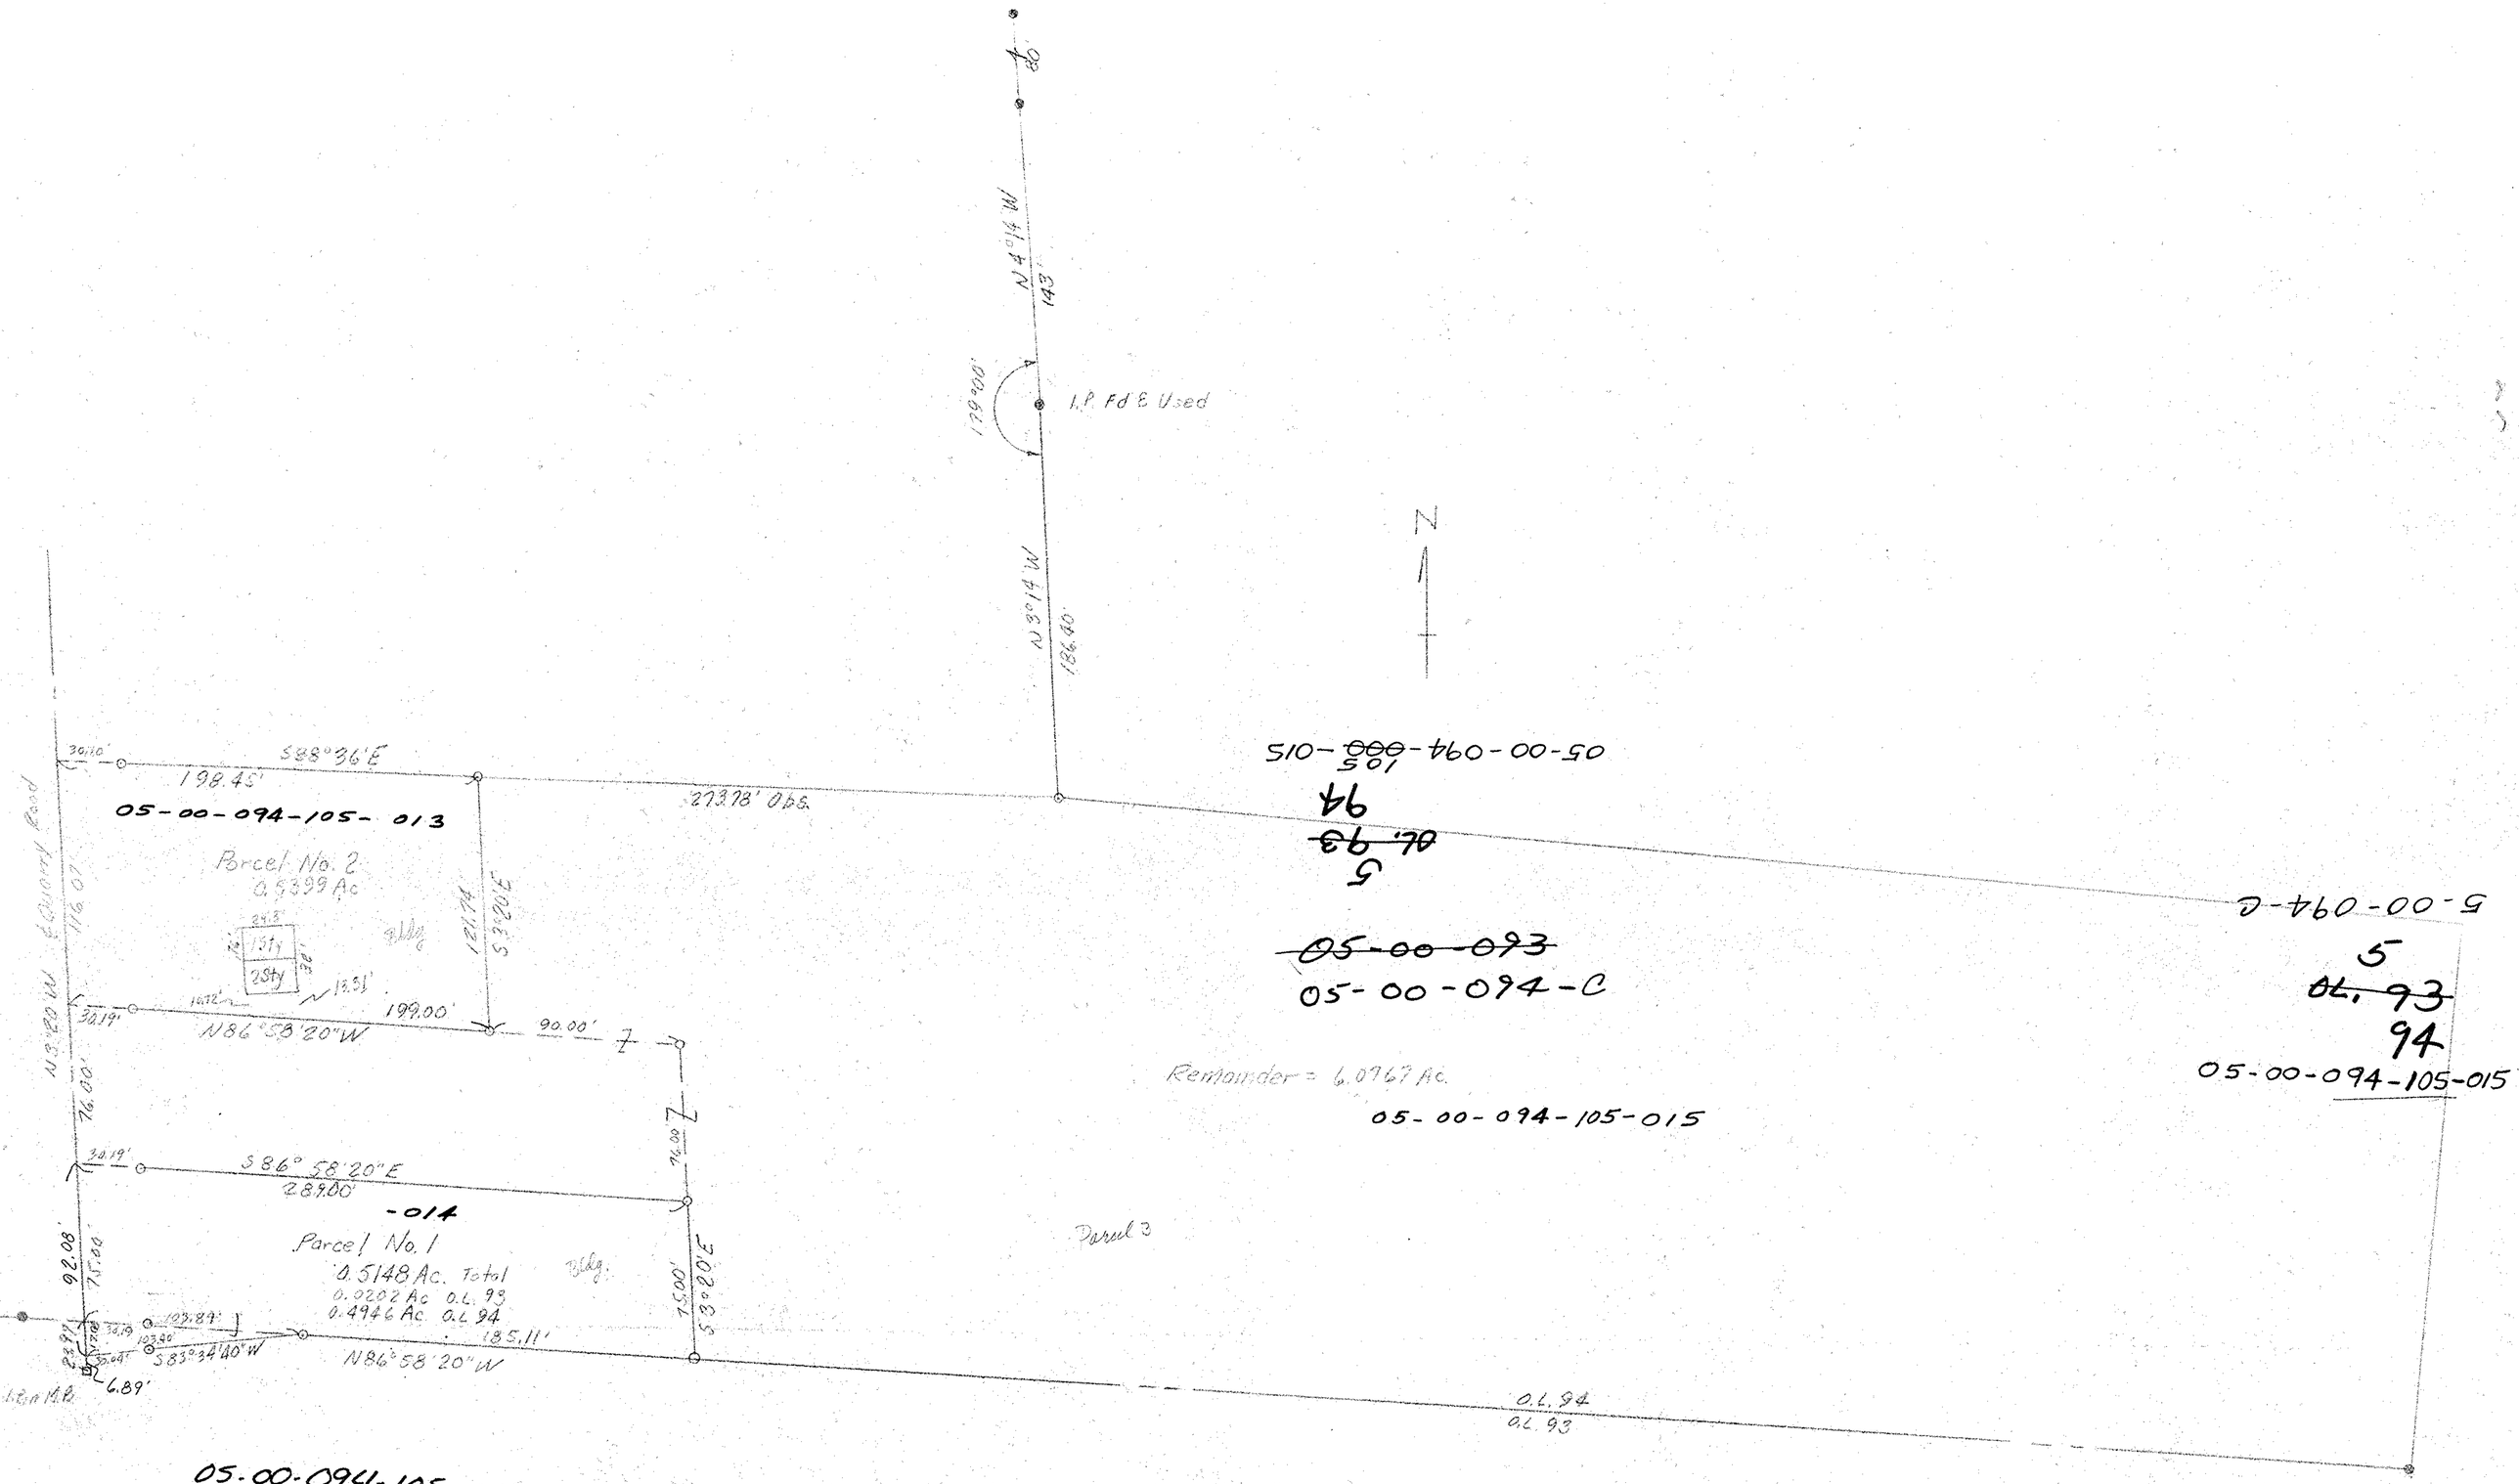

MAP OF SURVEY FOR
JOSEPH & JESSIE D. ABRAHAM
O.L. 93 & 94 AMHERST TWP.
LORAIN COUNTY, OHIO

McGLINCHY & ASSOCIATES
538 W. BROAD ST. ELYRIA, O.
SCALE 1"=50' JOB No 75161